


V & S SURVEYING, INC.

2412 Orsota Circle, Ocoee, Florida 34761. Tel: 407-342-1510 Fax: 407-656-8365 Email: vssurveying@aol.com


BOUNDARY & TOPOGRAPHIC SURVEY FOR AS-BUILT PURPOSE

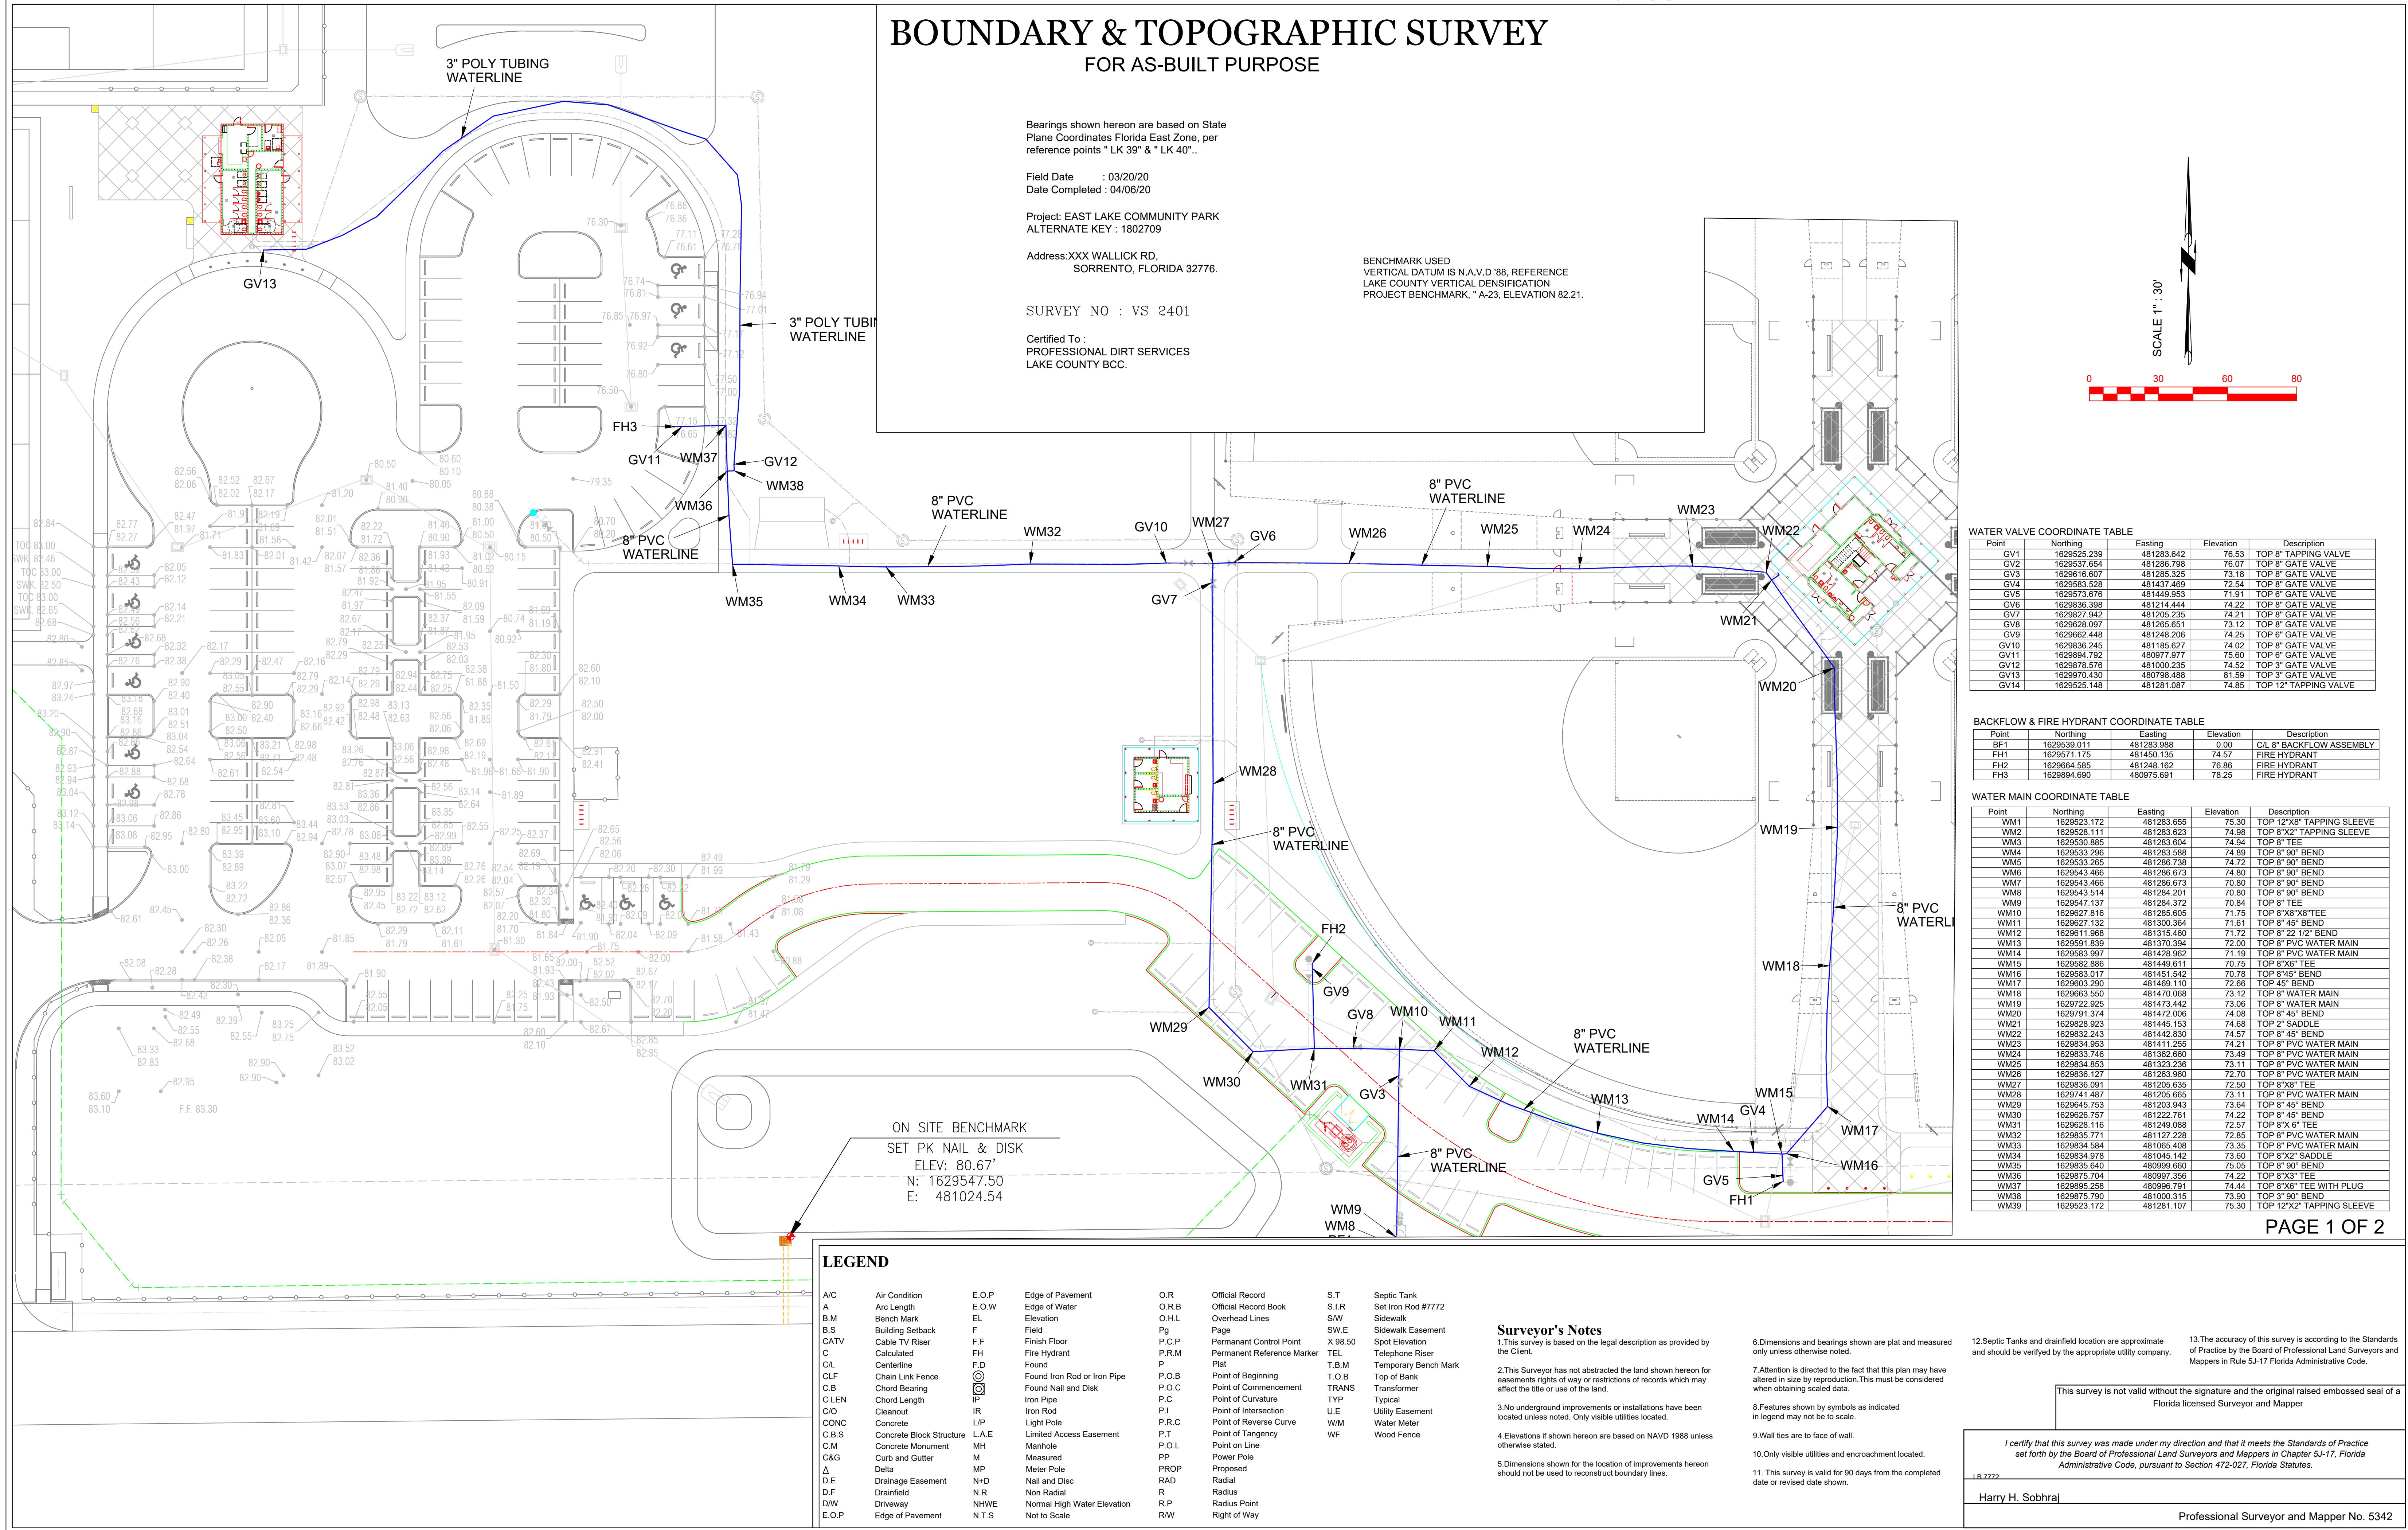

V & S SURVEYING, INC.

2412 Orsota Circle, Ocoee, Florida 34761. Tel: 407-342-1510 Fax: 407-656-8365 Email: vssurveying@aol.com

BOUNDARY & TOPOGRAPHIC SURVEY FOR AS-BUILT PURPOSE

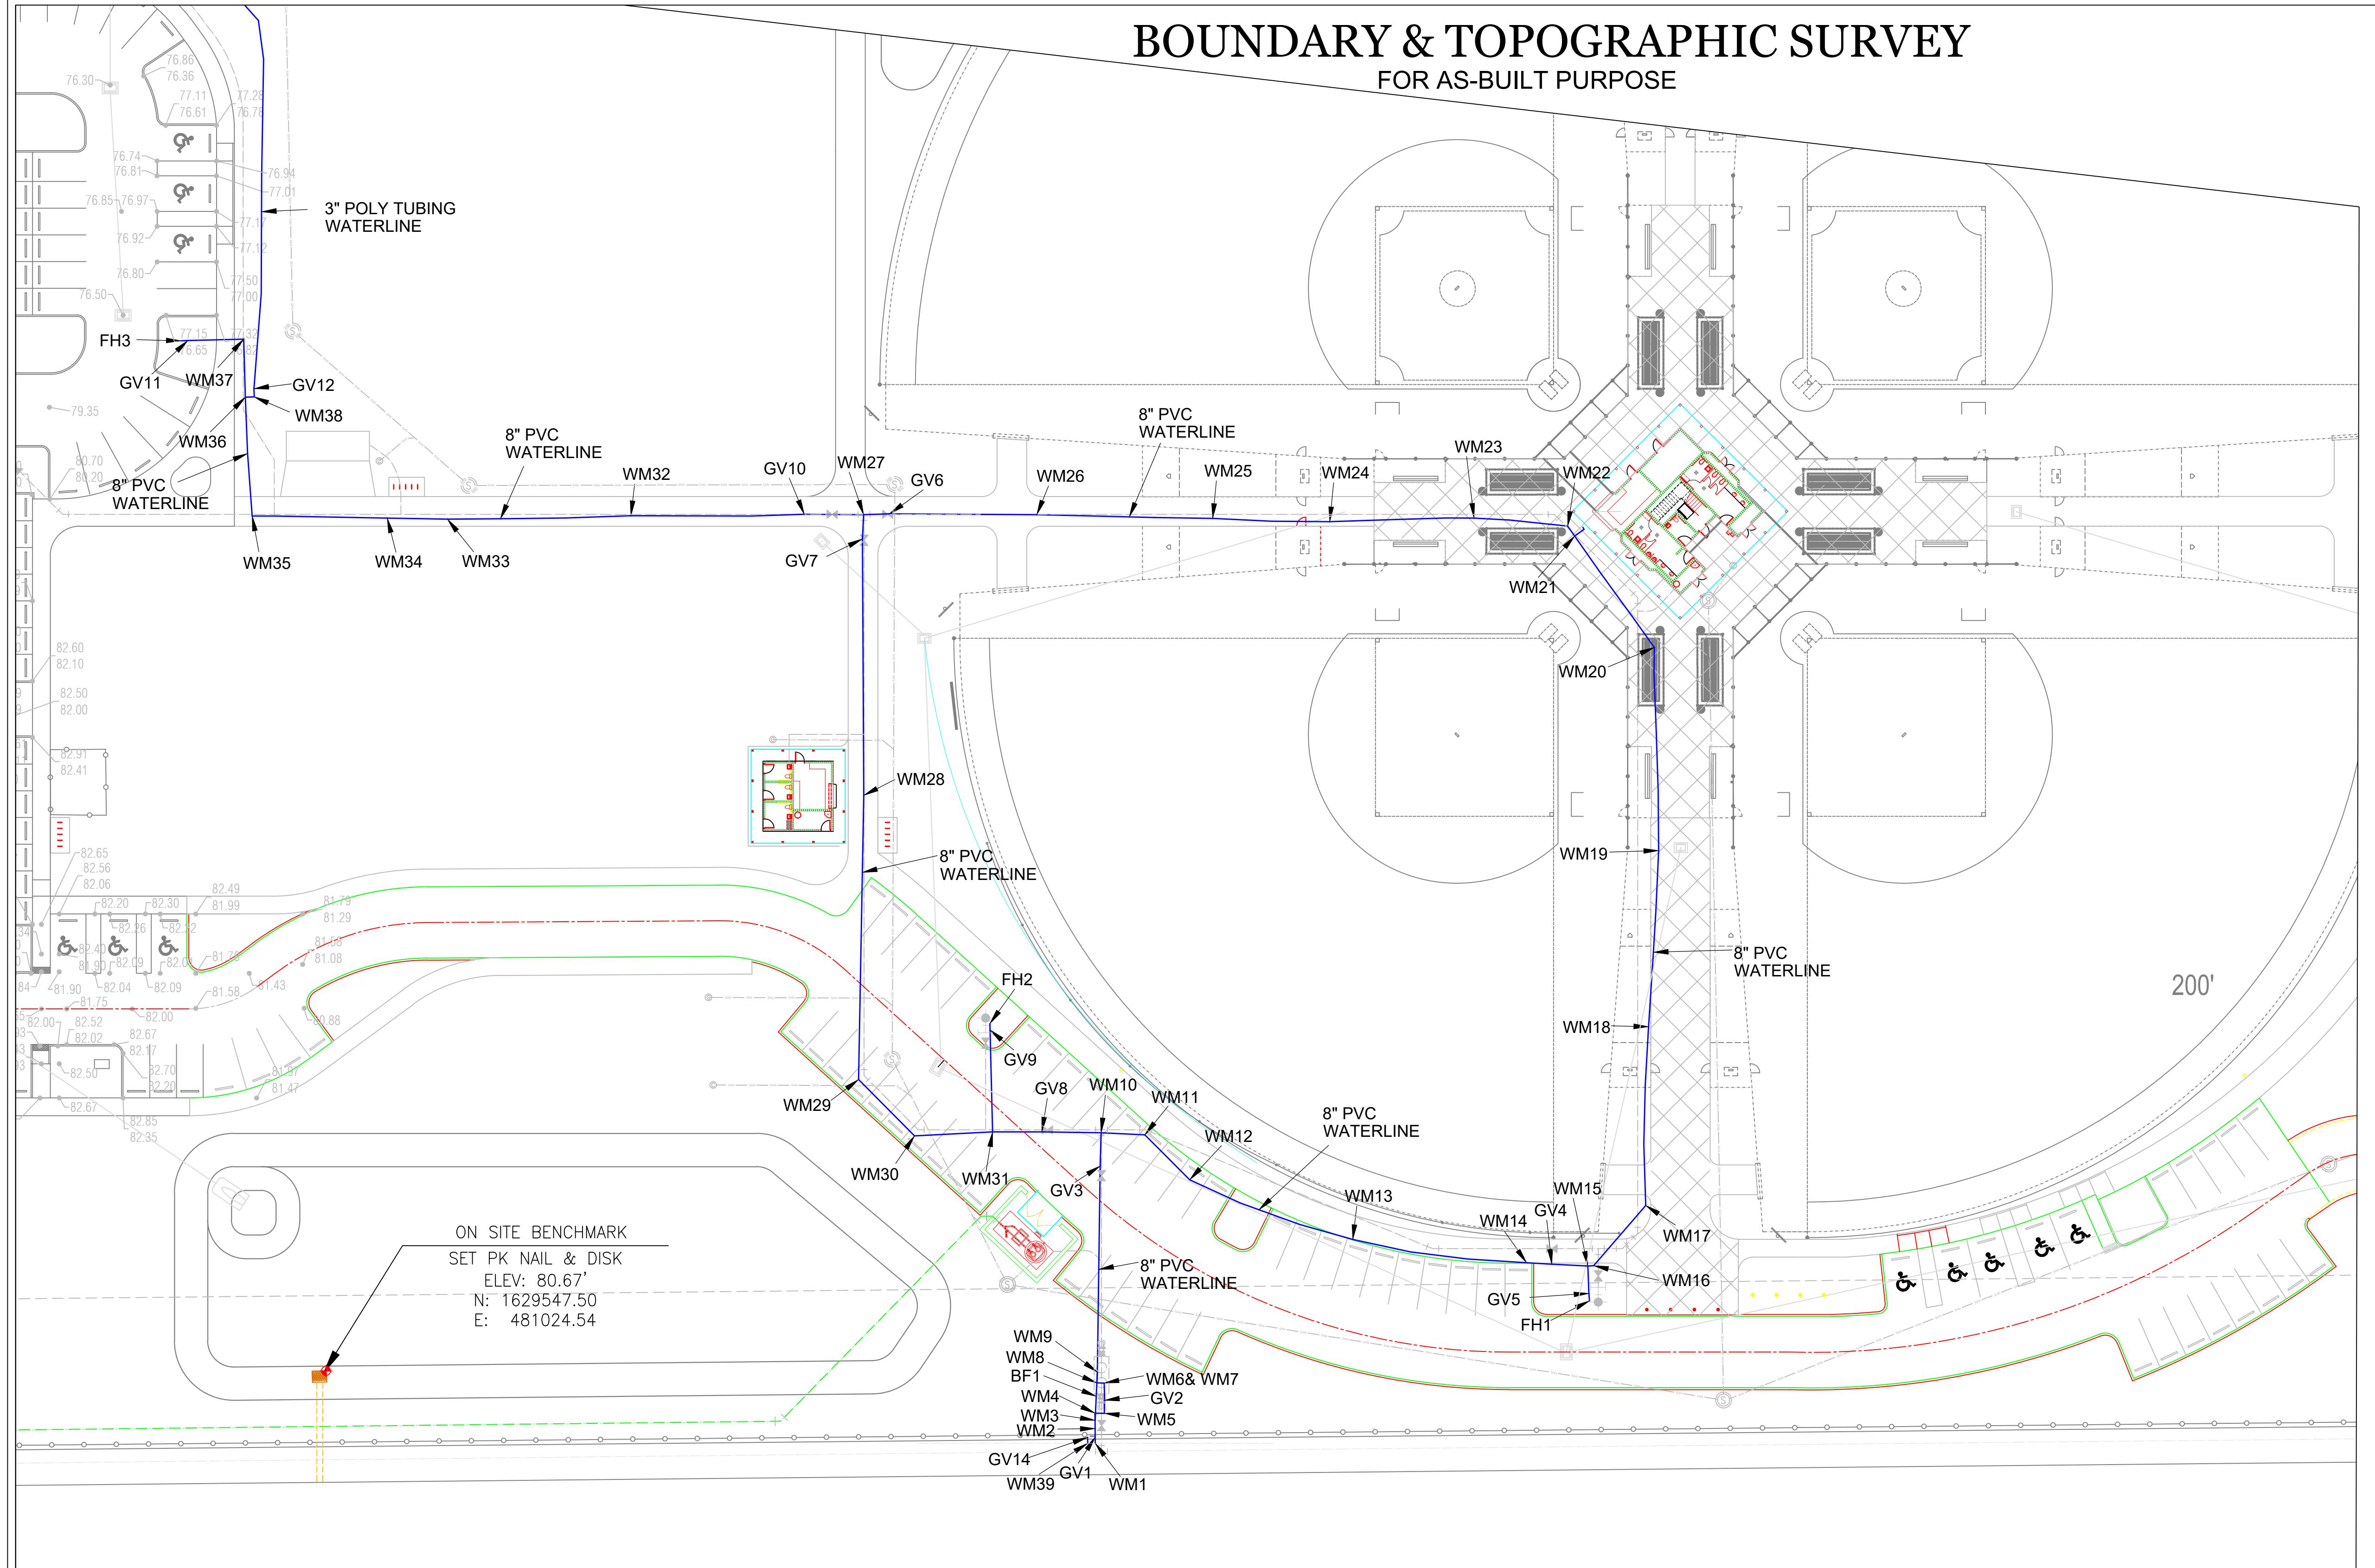

LEGEND

A/C	Air Condition	E.O.P	Edge of Pavement	O.R	Official Record	S.T	Septic Tank
A	Arc Length	E.O.W	Edge of Water	O.R.B	Official Record Book	S.I.R	Set Iron Rod #7772
B.M	Bench Mark	E.L	Elevation	O.H.L	Overhead Lines	SW	Sidewalk
B.S	Building Setback	F	Field	Pg	Page	SW.E	Sidewalk Easement
CATV	Cable TV Riser	F.F	Finish Floor	P.C.P	Permanent Control Point	X 98.50	Spot Elevation
C	Calculated	FH	Fire Hydrant	P.R.M	Permanent Reference Marker	TEL	Telephone Riser
C/L	Centerline	F.D	Found	P	Plat	T.B.M	Temporary Bench Mark
CLF	Chain Link Fence	○	Found Iron Rod or Iron Pipe	P.O.B	Point of Beginning	T.O.B	Top of Bank
C,B	Chord Bearing	○	Found Nail and Disk	P.O.C	Point of Commencement	TRANS	Transformer
C,LEN	Chord Length	○	Iron Pipe	P.C	Point of Curvature	TYP	Typical
C/O	Cleanout	IR	Iron Rod	P.I	Point of Intersection	U.E	Utility Easement
CONC	Concrete	L/P	Light Pole	P.R.C	Point of Reverse Curve	W/M	Water Meter
C,B,S	Concrete Block Structure	L.A.E	Limited Access Easement	P.T	Point of Tangency	WF	Wood Fence
C,M	Concrete Monument	MH	Manhole	P.O.L	Point on Line		
C&G	Curb and Gutter	M	Measured	PP	Power Pole		
Δ	Delta	MP	Meter Pole	PROP	Proposed		
D,E	Drainage Easement	N+D	Nail and Disc	RAD	Radial		
D,F	Drainfield	N.R	Non Radial	R	Radius		
D/W	Driveway	NHWE	Normal High Water Elevation	R.P	Radius Point		
E.O.P	Edge of Pavement	N.T.S	Not to Scale	R/W	Right of Way		

Surveyor's Notes

- This survey is based on the legal description as provided by the Client.
- This Surveyor has not abstracted the land shown herein for easements rights of way or restrictions of records which may affect the title or use of the land.
- No underground improvements or installations have been located unless noted. Only visible utilities located.
- Elevations if shown herein are based on NAVD 1988 unless otherwise stated.
- Dimensions shown for the location of improvements herein should not be used to reconstruct boundary lines.
- Dimensions and bearings shown are plat measured only unless otherwise noted.
- Attention is directed to the fact that this plan may have altered in size by reproduction; this must be considered when obtaining scaled data.
- Features shown by symbols as indicated in legend may not be scale.
- Wall ties are face to wall.
- Only visible utilities and encroachment located.
- This survey is valid for 90 days from the completed date or revised date shown.

12. Septic Tanks and drainfield location are approximate and should be verified by the appropriate utility company.

13. The accuracy of this survey is according to the Standards of Practice by the Board of Professional Land Surveyors and Mappers in Rule 5J-17 Florida Administrative Code.

This survey is not valid without the signature and the original raised embossed seal of a Florida licensed Surveyor and Mapper

I certify that this survey was made under my direction and that it meets the Standards of Practice set forth by the Board of Professional Land Surveyors and Mappers in Chapter 5J-17, Florida Administrative Code, pursuant to Section 472-027, Florida Statutes.
LR.7772
Harry H. Sobhraj

Professional Surveyor and Mapper No. 5342