

0:\2020\20032_SAWGRASS_BAY_BIVD_ROUNDABOUT_TOPO\Engineering\Drawings\Plans\20032CA_SAWGRASS_ROUNDABOUT_6.dwg PLOTTED BY: Nunez, Osvaldo 4/24/2024 8:37 AM

SHEET INDEX

SHEET NO.	SHEET DESCRIPTION
1	COVER SHEET
2	AERIAL PHOTO
3 - 4	GENERAL NOTES
5	LEGENDS
6	EROSION NOTES & DETAILS
7	STREET SIGN DETAIL
8	GENERAL DETAILS
9	CONTROL PROJECT
10	ROUNDAABOUT TYPICAL SECTION
11	SAWGRASS BAY BLVD TYPICAL SECTION
12	FLEMINGS RD TYPICAL SECTION
13	STREET 'B' TYPICAL SECTION
14 - 16	SAWGRASS BAY BLVD PLAN & PROFILE
17	ROUNDAABOUT PLAN, FLEMINGS RD & STREET 'B' P&P
18	I.C.D. PROFILE
19	QUADRANTS PROFILES
20	DRAINAGE & GRADING DETAIL
21 - 23	SAWGRASS BAY BLVD CROSS SECTIONS
24	FLEMINGS RD & STREET 'B' CROSS SECTIONS
25 - 26	SIGN & STRIPING PLAN

SURVEYOR'S CERTIFICATION:

I HEREBY CERTIFY TO THE BEST OF MY PROFESSIONAL KNOWLEDGE, THAT THIS MAP OF AS-BUILT SURVEY IS A TRUE REPRESENTATION OF A FIELD SURVEY MADE UNDER MY DIRECTION AND CONFORMS TO THE STANDARDS OF PRACTICE FOR PROFESSIONAL SURVEYORS AND MAPPERS AS OUTLINED IN CHAPTER 5J-17, FLORIDA ADMINISTRATIVE CODE.

ERIC E. BANTA
PROFESSIONAL LAND SURVEYOR
FLORIDA LICENSE NO. LS 5696

NOTICE:

ADDITIONS OR DELETIONS TO SURVEY MAPS OR REPORTS BY OTHER THAN THE SIGNING PARTY OR PARTIES IS PROHIBITED WITHOUT WRITTEN CONSENT OF THE SIGNING PARTY OR PARTIES.

Know what's below.
Call before you dig.


SUNSHINE STATE ONE CALL OF FLORIDA

811



SAWGRASS BAY BLVD
MULTILANE ROUNADBOUT
PROJECT NO. 20032
APRIL 2024


AS-BUILT SURVEY

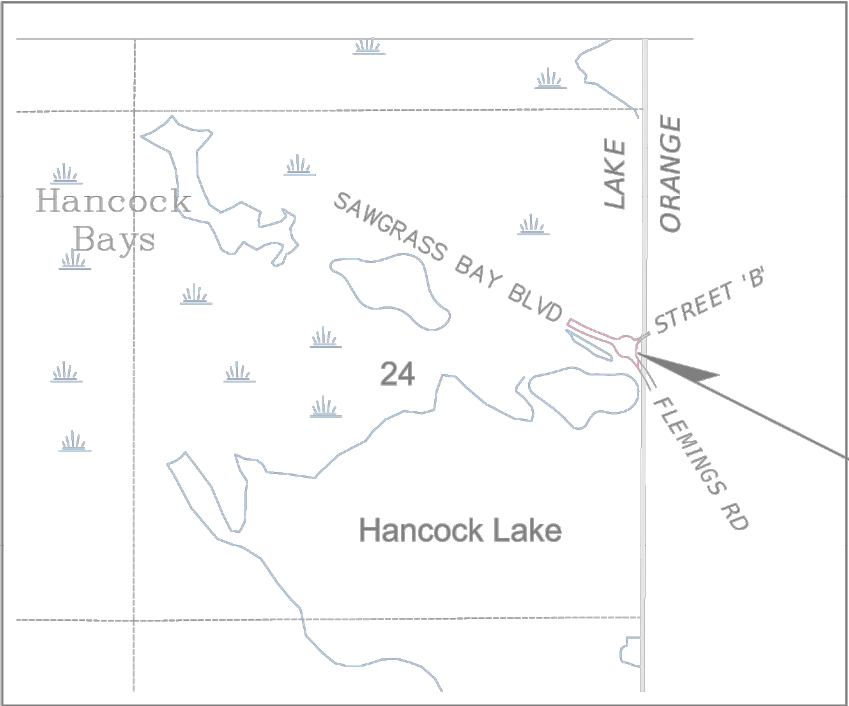

LOCATION MAP

LENGTH OF PROJECT	
	LINEAR FEET
ROADWAY	1648.17
BRIDGES	0
NET LENGTH OF PROJECT	1648.17
EXCEPTIONS	0
GROSS LENGTH OF PROJECT	1648.17

FOR REVIEW ONLY

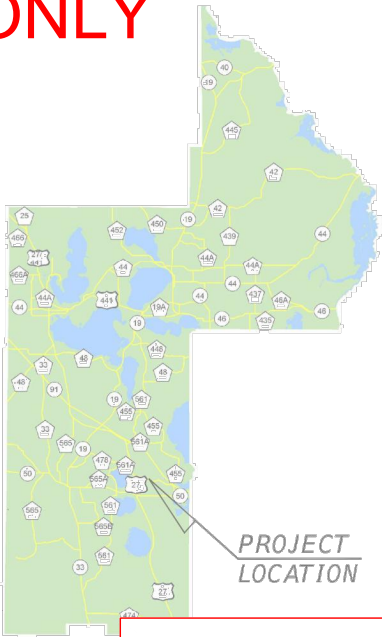

AS-BUILT LEGEND

LS	LICENSED SURVEYOR
LB	LICENSED BUSINESS
N:	NORTHING
E:	EASTING
EL:	ELEVATION
STA.	STATION
LT	LEFT OF BASELINE
RT	RIGHT OF BASELINE
Ⓢ	STORM SEWER MANHOLE

GENERAL NOTES:

THIS SURVEY WAS PREPARED AS AN AS-BUILT SURVEY.

AS-BUILT INFORMATION IS SHOWN IN RED AND CYAN.

ALL UNDERGROUND AS-BUILT INFORMATION WAS FLAGGED IN THE FIELD AND PROVIDED BY THE CONTRACTOR.

SURVEY CONTROL POINTS WERE PROVIDED BY THE CLIENT IN CONSTRUCTION PLANS AND CAD FILES PREPARED BY: LAKE COUNTY DEPARTMENT OF PUBLIC WORKS ENGINEERING DIVISION, DATED: APRIL, 2024.


COORDINATES, STATIONS, OFFSETS AND ELEVATIONS ARE BASED ON CONSTRUCTION CONTROL DATUM PROVIDED IN SAID PLANS.

LAST DATE OF FIELD WORK: JUNE 17, 2025.

AS-BUILT NOTES:

ELEVATIONS SHOWN HEREON BASED ON THE NORTH AMERICAN VERTICAL DATUM OF 1988 (NAVD88).

COORDINATES SHOWN HEREON BASED ON THE NORTH AMERICAN DATUM OF 1983 (NAD83), FLORIDA STATE PLANE COORDINATES, EAST ZONE, U.S. FEET.

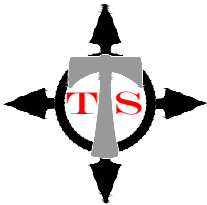

TOMAHAWK SURVEYING

Florida Licensed Business No. LB8449
115 Morningstar Drive
Punta Gorda, FL 33950
(941)-740-0733

DATE 06/19/2025	JOB# 24-79	DWG 24-79 ASB	SCALE AS SHOWN
--------------------	---------------	------------------	-------------------

DEPARTMENT OF PUBLIC WORKS
ENGINEERING DIVISION

LAKE COUNTY, FL
350 N. SINCLAIR AVE., TAVARES, FLORIDA 32778


JEFFREY J. EARHART
No. 49935
FLORIDA PROFESSIONAL LAND SURVEYOR
DATE: 4/24/2024

SAWGRASS BAY BLVD
MULTILANE ROUNDAABOUT
COVER SHEET


JOB NO.:
20032CA

SHEET:
1

0:\2020\20032_SAWGRASS_BAY_BLVD_ROUNDABOUT_TOPO\Engineering\Drawings\Plans\20032CA_SAWGRASS_ROUNDABOUT_6.dwg PLOTTED BY: Nunez, Osvaldo 4/24/2024 8:38 AM

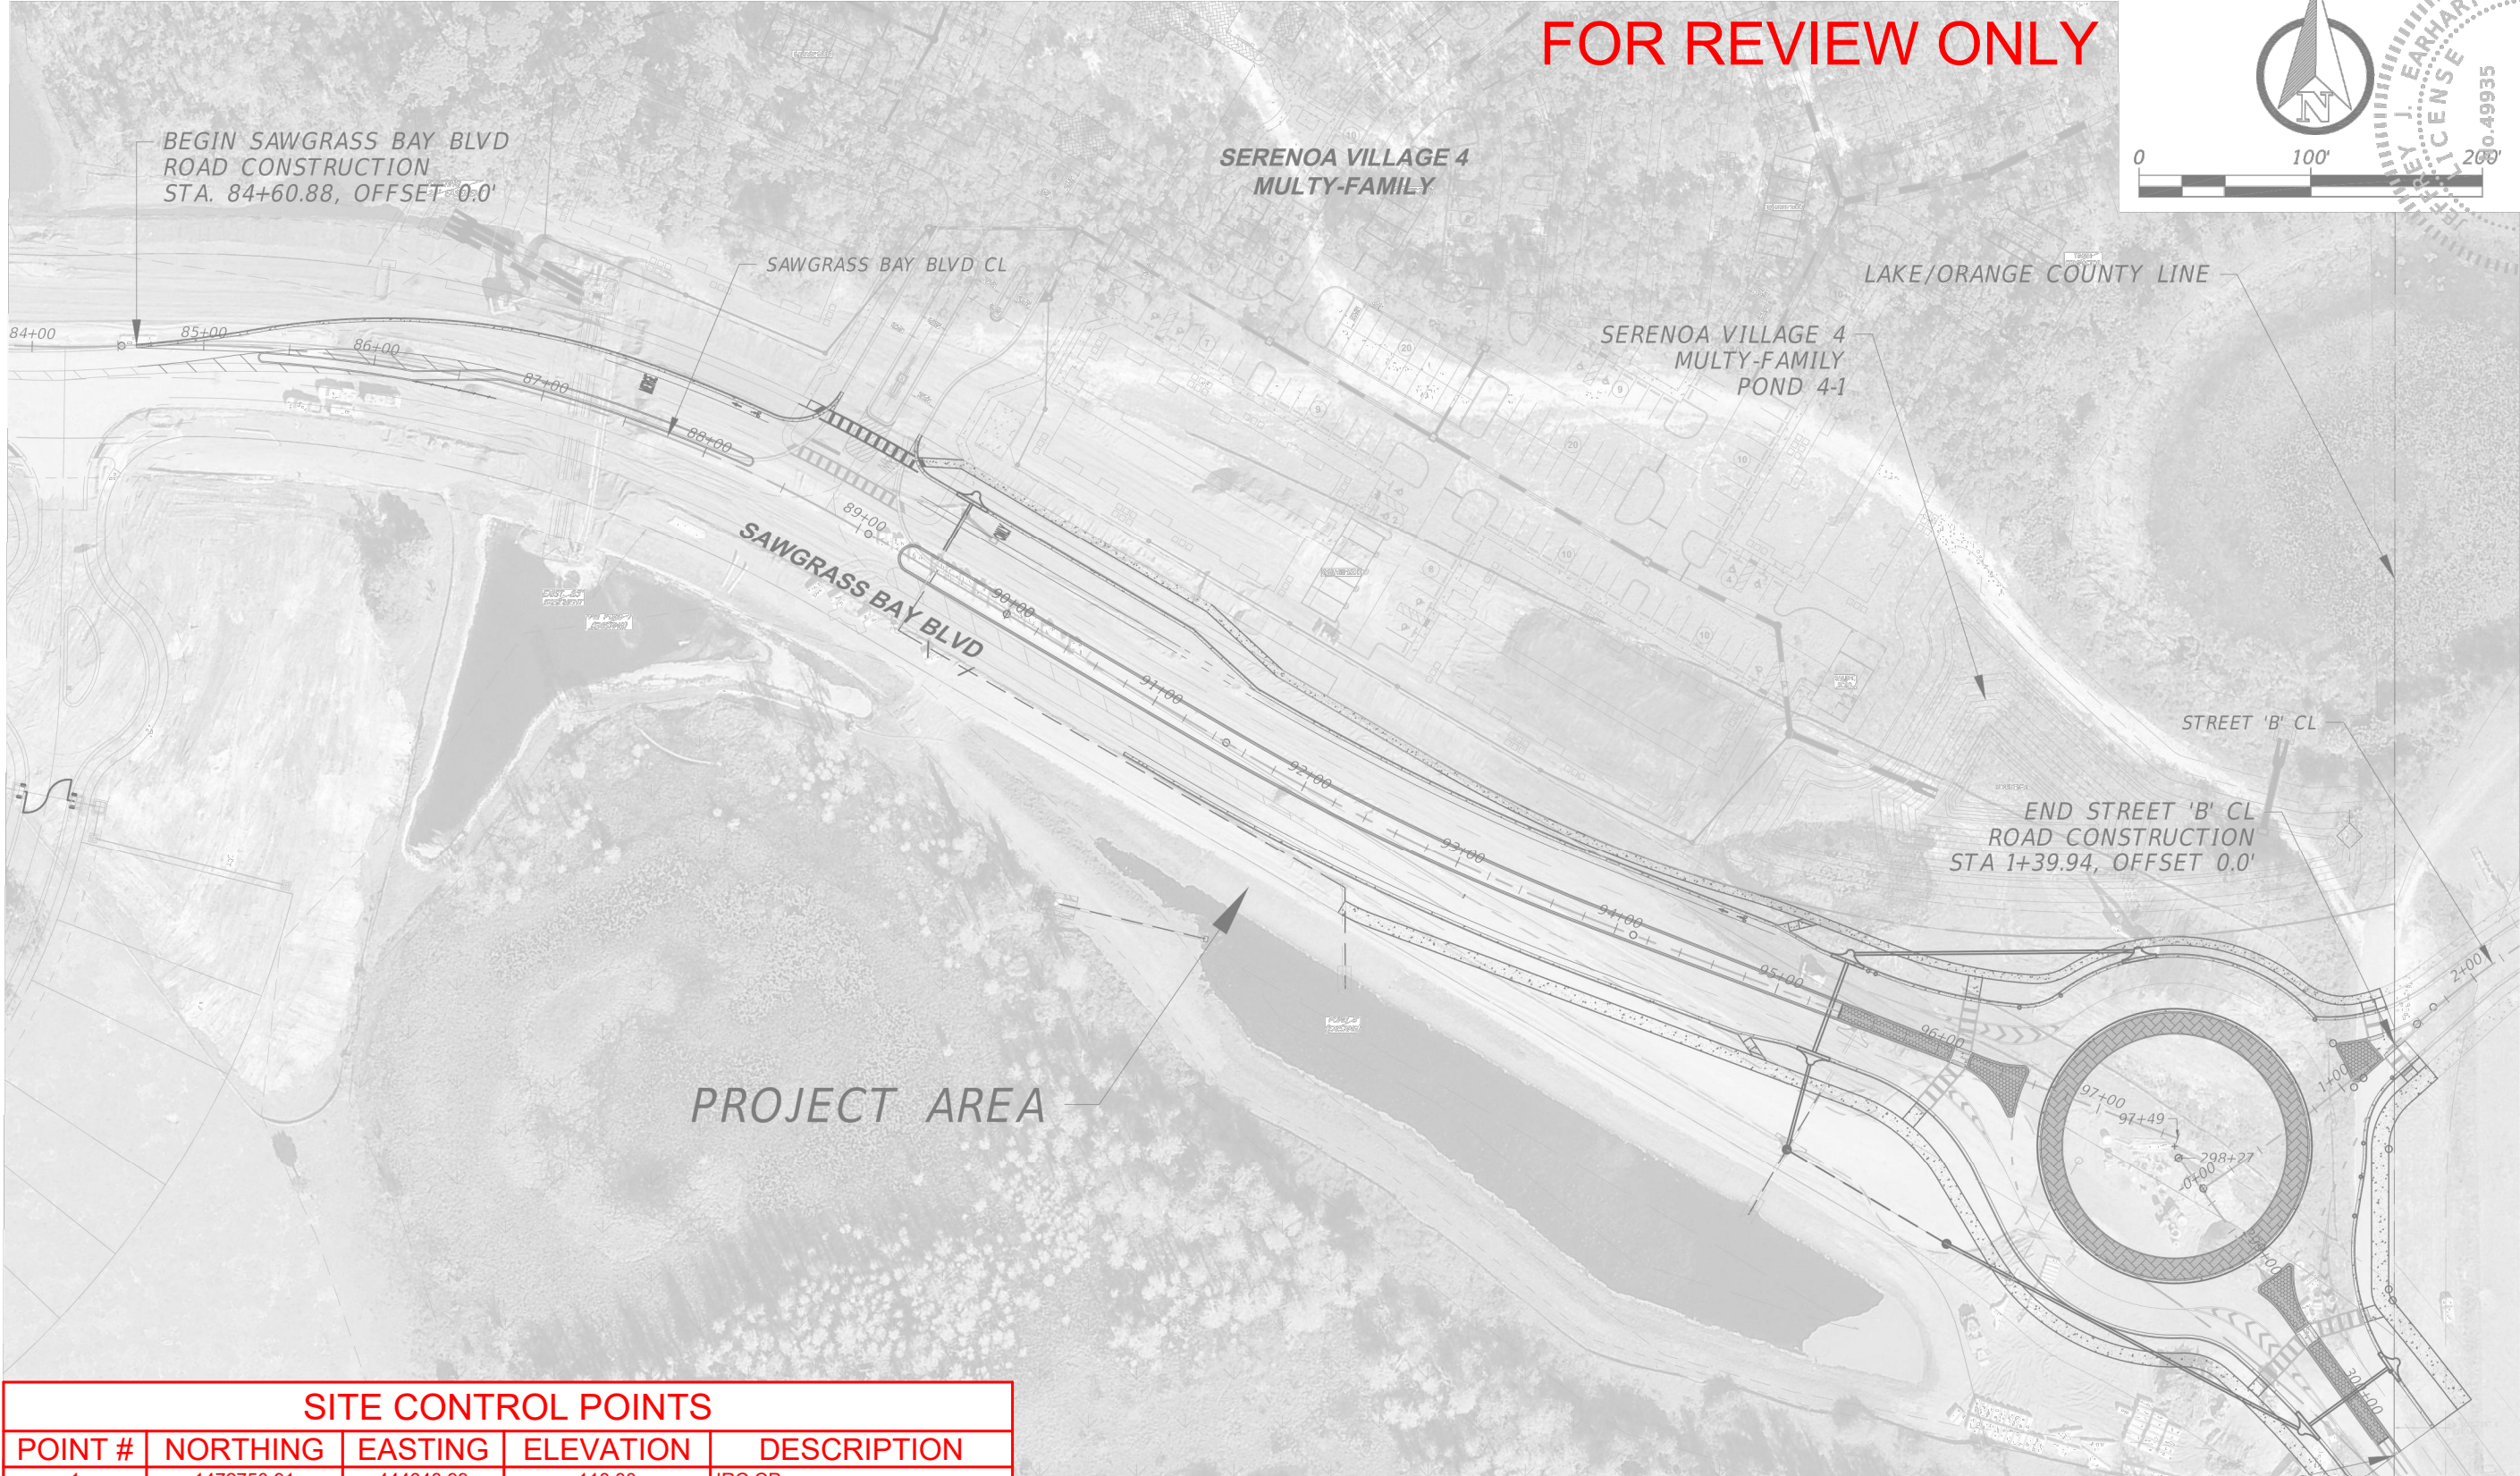

SITE CONTROL POINTS				
POINT #	NORTHING	EASTING	ELEVATION	DESCRIPTION
1	1472750.91	444648.99	118.80	IRC CP
2	1473025.20	444248.11	118.69	IRC CP
3	1473083.57	443979.28	117.92	BM LCBM-H33
4	1472593.79	444834.93	118.89	IRC CP
5	1472926.07	444849.14	118.80	IRC CP
6	1472987.88	444757.18	115.02	IRC CP
7	1472568.83	444846.56	118.29	BM GIS 0250 ROY BARTH 3
8	1472552.76	444852.08	118.14	IP 1/2
9	1472532.30	444942.83	117.69	80D CP
10	1472434.67	445034.61	116.68	80D CP

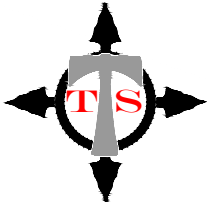


TOMAHAWK SURVEYING

Florida Licensed Business No. LB8449
115 Morningstar Drive
Punta Gorda, FL 33950
(941)-740-0733

DATE	JOB#	DWG	SCALE
06/19/2025	24-79	24-79 ASB	AS SHOWN

FOR REVIEW ONLY

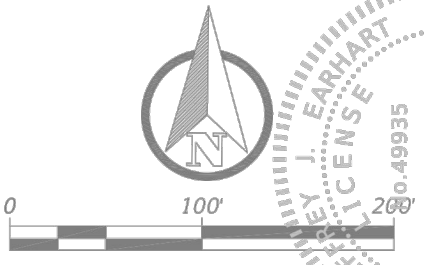

JEFFREY J. EARTHART

PROFESSIONAL ENGINEER

FL LICENSE NO. 49935

DATE: 4/24/2024

DEPARTMENT OF PUBLIC WORKS
ENGINEERING DIVISION



LAKE COUNTY, FL
350 N. SINCLAIR AVE., TAVARES, FLORIDA 32778

S. -24	T. -245	R. -26E	REVISION:	DATE
SURVEYED: CM	DATE: 10/14/20	PAGE: 45-46, 51		
FIELD BOOK: 229	DESIGNED: OEN	DATE: 4/24/2024		
DRAWN: OEN	DATE: 4/24/2024			
APPROVED: JE	DATE: 4/24/2024			

SAWGRASS BAY BLVD
MULTILANE ROUNDABOUT
AERIAL PHOTO

JOB NO.:
20032CA
SHEET:
2

O:\2020\20032_SAWGRASS_BAY_BIVD_ROUNDABOUT_TOP0\Engineering\Drawings\Plans\20032CA_SAWGRASS_ROUNDABOUT_6.dwg PLOTTED BY: Nunez, Osvaldo 4/24/2024 8:38 AM

GENERAL NOTES


- A. ALL MATERIALS, INSTALLATION, TESTING, AND CONSTRUCTION SHALL BE IN ACCORDANCE WITH THE STANDARDS AND SPECIFICATIONS OF LAKE COUNTY, FLORIDA AND THE FDOT UNIFORM MINIMUM STANDARDS FOR DESIGN, CONSTRUCTION AND MAINTENANCE FOR STREETS AND HIGHWAYS" COMMONLY KNOWN AS THE "FLORIDA GREENBOOK" 2018 EDITION EDITION AND FDOT FY 2023 - 2024 STANDARD PLANS FOR ROAD AND BRIDGE CONSTRUCTION. WHERE THE SPECIFICATIONS CONFLICT, THE MAXIMUM REQUIREMENTS OF EITHER SPECIFICATION SHALL APPLY, UNLESS OTHERWISE DIRECTED BY THE ENGINEER OF RECORD.
- B. ALL PROPOSED ELEVATIONS ARE SHOWN WITH A BORDER. (i.e.: XX.XX). ALL OTHER SPOT ELEVATIONS SHOWN ARE EXISTING. ALL VERTICAL DATUM IS N.A.V.D. 1988 DATUM.
- C. PAVEMENT SHALL MEAN ALL ASPHALT AND BASE ASSOCIATED WITH A DRIVING SURFACE AS SHOWN ON THE CONSTRUCTION PLANS.
- D. PAVEMENT REMOVAL SHALL BE REQUIRED ON ALL SIDE STREETS AND DRIVEWAYS THAT ARE WITHIN THE LIMITS OF THE RIGHT OF WAY OF THE COUNTY ROAD, AND CONSTRUCTED PER THE CROSS SECTION SHOWN ON THE CONSTRUCTION PLANS MATCHING EXISTING WIDTH AND ELEVATION UNLESS OTHERWISE NOTED.
- E. A CONSTANT SLOPE SHALL BE MAINTAINED BETWEEN DESIGNATED AREAS OF CUT AND FILL.
- F. ALL FILL INCLUDING SUB GRADE AND/OR SUBBASE PLACED WITHIN PROPOSED ROAD RIGHT-OF-WAY OR EASEMENT SHALL BE COMPACTED AS FOLLOWS:
- ROADWAY AREAS (UNDER PAVEMENT AND PAVED SHOULDERS) SHALL BE 98% MAXIMUM DENSITY, AASHTO T-180, MINIMUM LBR 40 FOR EACH LIFT. EACH LIFT SHALL BE A MAXIMUM OF 6".
- STABILIZED SHOULDERS SHALL BE TWELVE (12) INCHES DEEP, 98% MAXIMUM DENSITY, AASHTO T-180, MINIMUM LBR 40.
- BEYOND THE STABILIZED SHOULDER, ALL FILL SHALL BE COMPACTED TO 95% MINIMUM DENSITY.
- FILL VOLUMES SHOWN DO NOT HAVE A COMPACTION MULTIPLIER FACTORED. THE CONTRACTOR SHALL DETERMINE A COMPACTION FACTOR AND APPLY IT FOR FINAL FILL PLACEMENT VOLUMES. FOR SUBGRADE AND/OR SUBBASE REQUIREMENTS, PLEASE REFER TO SPECIFIC CROSS SECTION.
- G. UNLESS OTHERWISE NOTED, THE ESTABLISHED CLEAR ZONE IS (14) FEET FROM NEW EDGE OF TRAVEL WAY. ALL ABOVE GROUND STRUCTURES SUCH AS MAIL BOXES, TRAFFIC CONTROL SIGNS, STREET SIGNS, FENCES, ETC., ARE TO BE REMOVED AND REPLACED OUTSIDE OF THE CLEAR ZONE. THE CONTRACTOR IS RESPONSIBLE FOR THE COORDINATION OF REMOVAL AND REPLACEMENT OF THESE STRUCTURES. DAILY ACCESS TO MAILBOXES SHALL BE MAINTAINED. ALL FENCES ARE TO BE RELOCATED TO THE RIGHT-OF-WAY LINE. THE ENGINEER OF RECORD MAY WAIVE SOME OF THESE REQUIREMENTS, IF NECESSARY.
- H. ALL WORK SHALL BE PERFORMED IN SUCH A MANNER THAT WILL SUCCESSFULLY ACCOMPLISH THE INTENDED DESIGN WITH MINIMAL IMPACT TO EXISTING CONDITIONS. ANY CONSTRUCTION ACTIVITY PERFORMED WITHOUT PRIOR WRITTEN APPROVAL FROM THE ENGINEER OF RECORD THAT IS DEEMED EXCESSIVELY DISRUPTIVE TO EXISTING CONDITIONS OF THE SURROUNDING AREA AND/OR SIGNIFICANTLY DEVIATES FROM THE LIMITS OF CONSTRUCTION AS SET FORTH BY THESE CONSTRUCTION PLANS SHALL BE CONSIDERED AS PART OF THE ORIGINAL WORK AND NO ADDITIONAL COMPENSATION SHALL BE GIVEN TO RESTORE THE DISTURBED AREA(S).
- I. APPARENT ERRORS, DISCREPANCIES OR OMISSIONS SHALL BE BROUGHT TO THE ENGINEER OF RECORD'S ATTENTION WITHIN A REASONABLE TIME FRAME, LESS THAN 48 HOURS AFTER DISCOVERED. ADVANTAGE WILL NOT BE TAKEN OF APPARENT ERROR OR OMISSION IN THE DRAWINGS OR SPECIFICATIONS, AND THE ENGINEER SHALL BE PERMITTED TO MAKE CORRECTIONS AND INTERPRETATIONS AS MAY BE DEEMED NECESSARY FOR FULFILLMENT OF THE INTENT OF THE DESIGN.
- J. CONTRACTOR SHALL VERIFY ALL EXISTING ROADWAY CROSS-SLOPES.
- K. DETECTABLE WARNING ON SIDEWALK TERMINATIONS SHALL BE CAST IN PLACE, THERMOPLASTIC, LIQUID APPLIED ADA MATS OR COUNTY APPROVED EQUAL THAT IS LISTED ON THE FDOT APPROVED PRODUCTS LIST (APL). THE COLOR SHALL BE SAFETY BRICK RED.
- K. ALL CHAIN LINK FENCE (CLF) WHEN PROPOSED SHALL BE FDOT TYPE B FENCING, BLACK VINYL COATED PER FDOT INDEX 550-002.

PUBLIC NOTIFICATION

- A. PRIOR TO CONSTRUCTION, THE CONTRACTOR SHALL PROVIDE WRITTEN NOTICE TO ALL RESIDENCES ADJACENT TO THE PROJECT LIMITS. WITHIN A MINIMUM OF 14 CALENDAR DAYS PRIOR TO CONSTRUCTION, CONTRACTOR SHALL PROVIDE TO THE COUNTY A COPY OF THE NOTIFICATION WITH A LIST OF THE PARTIES CONTACTED. THIS NOTICE SHALL INCLUDE, AT A MINIMUM, THE ANTICIPATED CONSTRUCTION SCHEDULE, MAINTENANCE OF TRAFFIC PLAN AND ANY IMPACTS, PERMANENT OR TEMPORARY, TO THE SUBJECT RESIDENCE AND ITS ADJACENT AREA. CONTRACTOR SHALL PROVIDE CONTACT INFO INCLUDING NAME OF PROJECT MANAGER AND TELEPHONE NUMBER.
- B. CONTRACTOR SHALL ALSO INSTALL PORTABLE CHANGEABLE (VARIABLE) MESSAGE SIGNS (F.D.O.T. DESIGN MANUAL 2023-24 INDEX 102-607) ON COUNTY ROAD IF IMPACTED BY CONSTRUCTION, ONE (1) WEEK PRIOR TO CONSTRUCTION IN ORDER TO INFORM RESIDENTS AND ROADWAY USERS OF THE IMPENDING CONSTRUCTION. THE PCMS SHALL DISPLAY LANE CLOSURE INFORMATION INCLUDING BUT NOT LIMITED TO ANTICIPATED LANES TO BE CLOSED, EXTENT OF LANE CLOSURE (I.E. "NEXT 3 MILES"), DAILY HOURS OF CLOSURE, AND TEMPORARY SPEED RESTRICTIONS.
- C. STRIPING SHALL BE REFLECTORIZED.
- D. ALL CENTERLINE STRIPING SHALL HAVE REFLECTIVE RAISED PAVEMENT MARKINGS (RPM'S) PER F.D.O.T. STANDARDS INDEX 706-001, UNLESS OTHERWISE NOTED.
- E. ALL TRAFFIC CONTROL SIGNS THAT ARE DISTURBED SHALL BE REPLACED.
- F. ALL STRIPING, SIGNING, AND SIGNAL WORK SHALL BE COORDINATED WITH LAKE COUNTY TRAFFIC OPERATIONS. CONTRACTOR SHALL NOTIFY LAKE COUNTY TRAFFIC OPERATIONS (352) 742-1766 AT LEAST 48 HOURS PRIOR TO THE COMMENCEMENT OF ANY STRIPING, SIGNING, OR SIGNAL WORK.
- G. ALL SIGNS AND SIGNAL EQUIPMENT TO BE REMOVED ARE THE PROPERTY OF LAKE COUNTY. THESE ITEMS SHALL BE RETURNED TO LAKE COUNTY TRAFFIC OPERATIONS OR DISPOSED OF BY THE CONTRACTOR AT LAKE COUNTY TRAFFIC OPERATIONS' DIRECTION.
- H. ALL MATERIALS AND HARDWARE SHALL BE F.D.O.T. APPROVED AND PRE-APPROVED BY LAKE COUNTY TRAFFIC OPERATIONS PRIOR TO INSTALLATION.
- I. EXISTING STRIPING DESIGNATED FOR REMOVAL SHALL BE MILLED AND RESURFACED IN ACCORDANCE WITH FDOT REQUIREMENTS AND SPECIFICATIONS, SECTION 711.
- J. ALL PAVEMENT MARKING WORK SHALL BE PERFORMED IN ACCORDANCE WITH THE REQUIREMENTS OF THE LATEST EDITION OF THE F.D.O.T. STANDARDS INCLUDING BUT NOT LIMITED TO 'STANDARD SPECIFICATIONS FOR ROAD AND BRIDGE CONSTRUCTION', DESIGN STANDARDS' AND THE LATEST EDITION OF THE 'MANUAL OF UNIFORM TRAFFIC CONTROL DEVICES'.

DRIVEWAYS

- A. DRIVEWAYS SHALL BE PAVED WITHIN THE RIGHT-OF-WAY.
- B. SINGLE RESIDENTIAL DRIVES SHALL MATCH EXISTING WIDTH AND BE A MINIMUM OF 10.0' WIDE WITH AN 8.0' RADIUS FOR ASPHALT OR 4' x 8' WEDGE FOR CONCRETE.
- C. DRIVEWAYS SHALL NOT EXCEED 14% SLOPE.
- D. CONCRETE APRONS SHALL BE CONSTRUCTED AT EXISTING CONCRETE DRIVEWAYS. CONCRETE SHALL BE A MINIMUM OF SIX (6) INCHES THICK, 3,000 PSI.
- E. DRIVEWAY LOCATIONS AND WIDTHS SHOWN ARE TO BE MAINTAINED UNLESS OTHERWISE DIRECTED BY THE ENGINEER OF RECORD.

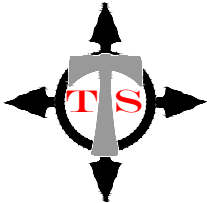

TOMAHAWK SURVEYING

Florida Licensed Business No. LB8449
115 Morningstar Drive
Punta Gorda, FL 33950
(941)-740-0733

DATE	JOB#	DWG	SCALE
06/19/2025	24-79	24-79 ASB	AS SHOWN

JEFFREY J. EARHART
No.49935
LICENSE

JEFFREY J. EARHART
No.49935
P.E.

32778

DEPARTMENT OF PUBLIC WORKS
ENGINEERING DIVISION

LAKE COUNTY, FL

350 N. SINCLAIR AVE., TAVARES, FLORIDA

SAWGRASS BAY BLVD
MULTILANE ROUNDABOUT
GENERAL NOTES (1)

JOB NO.:
20032CA

SHEET:
3

REVISION:

DATE

DATE

S. -24

T. -245

R. -26E

SURVEYED: CM

DATE: 10/14/20

FIELD BOOK: 229

PAGE: 45-46, 51

DESIGNED: OEN

DATE: 4/24/2024

DRAWN: OEN

DATE: 4/24/2024

APPROVED: JE

DATE: 4/24/2024

O:\2020\20032_SAWGRASS_BAY_BLYD_ROUNDABOUT_TOP\Engineering\Drawings\Plans\20032CA_SAWGRASS_ROUNDABOUT_6.dwg PLOTTED BY: Nunez, Osvaldo 4/24/2024 8:39 AM

TREES AND LANDSCAPING

- A. ALL TREES WITHIN CONSTRUCTION LIMITS RIGHT-OF-WAY ARE TO BE REMOVED UNLESS OTHERWISE NOTED IN THE PLANS
- B. CONTRACTOR SHALL REPLACE LANDSCAPING THAT IS REMOVED OR DESTROYED WITHIN THE LIMITS OF CONSTRUCTION.
- C. TREES SHALL BE TRIMMED TO RIGHT-OF-WAY LINE OR WITHIN 8' OF EOP TO A HEIGHT OF 18', WHICHEVER IS LESS BY THE CONTRACTORS.

UTILITIES

- A. THE UTILITIES SHOWN IN THE CONSTRUCTION PLANS MAY NOT BE ALL OF THE UTILITIES ON SITE. UNLESS OTHERWISE NOTED, THE LOCATION OF UTILITIES SHOWN IN THE PLANS ARE BASED ON LIMITED INVESTIGATION TECHNIQUES AND SHOULD BE CONSIDERED APPROXIMATE ONLY. CALL SUNSHINE STATE 1-CALL OF FLORIDA, INC. @ 1-800-432-4770 TO CONFIRM UTILITY LOCATIONS.
- B. CONTRACTOR SHALL BE RESPONSIBLE FOR NOTIFYING ALL UTILITIES PRIOR TO CONSTRUCTION AND COORDINATING UTILITY RELOCATION WITH THE PROJECT CONSTRUCTION.
- C. ONLY THOSE UTILITIES SHOWN HERON THAT WERE VISIBLE AT THE TIME OF THE SURVEY WERE LOCATED. NO ATTEMPT WAS MADE TO LOCATE UNDERGROUND UTILITIES. AN ASCE QUALITY A OR B DESIGNATION WILL BE NECESSARY BEFORE ANY ONSITE WORK TAKES PLACE. CONTACT SUNSHINE ONE CALL AT 811 FOR FURTHER INFORMATION.

SURVEY


- A. CONTRACTOR SHALL BE RESPONSIBLE FOR VERIFYING ALL CONTROL AND BENCHMARK DATA BEFORE CONSTRUCTION. DISCREPANCIES IN DATA SHALL BE BROUGHT TO THE ATTENTION OF THE LAKE COUNTY SURVEY MANAGER AT (352) 253-6049.
- B. ALL (P.R.M.'s) IRONS AND MONUMENTS SHOWN ON PLANS, OR FOUND, SHALL BE PRESERVED. THOSE SHOWN IN PROPOSED PAVEMENT SHALL BE PROTECTED WITH A CAST IRON VALVE BOX.
- C. PUBLIC LAND CORNERS WITHIN THE LIMITS OF CONSTRUCTION SHALL BE PROTECTED. IF A CORNER MONUMENT IS IN DANGER OF BEING DESTROYED OR DISTURBED THE COUNTY SURVEYOR SHALL BE IMMEDIATELY NOTIFIED.
- D. CONTRACTOR IS TO PROVIDE TWO (2) SETS OF HARD COPY AS-BUILTS AND ONE ELECTRONIC FILE. THE AS-BUILTS SHALL SHOW DRAINAGE INFORMATION AS WELL AS EDGE OF PAVEMENT SHOTS FOR THE ROADWAY.
- E. THE HORIZONTAL DATUM OF THIS SURVEY IS THE FLORIDA STATE PLANE COORDINATE SYSTEM, EAST ZONE, NORTH AMERICAN DATUM OF 1983 (2011 ADJUSTMENT) IN U.S. SURVEY FEET BASED ON ON GLOBAL NAVIGATION SATELLITE SYSTEM TIES TO CONTINUOUSLY OPERATING REFERENCE STATIONS (CORS) AS PROCESSED THROUGH THE FLORIDA DEPARTMENT OF TRANSPORTATION'S FLORIDA PERMANENT REFERENCE NETWORK (FPRN). THE EXPECTED HORIZONTAL ACCURACY OF MAPPED FEATURES ARE EXPECTED TO BE LESS THAN 0.07 FEET AT A 95 PERCENT CONFIDENCE LEVEL PLUS A REASONABLE CENTERING ERROR INHERENT TO THE FEATURE BEING MAPPED. THE METHODOLOGY TO DETERMINE SAID ACCURACY WAS AN ERROR PROPAGATION ANALYSIS DONE BY A LEAST SQUARES ADJUSTMENT PROGRAM.

TRAFFIC CONTROLS

- A. EXISTING STREETS AND DRIVEWAYS SHALL BE MAINTAINED TO LOCAL TRAFFIC AND PROPERTY OWNERS.
- B. CONTRACTOR SHALL SUBMIT DETAILED MAINTENANCE OF TRAFFIC PLANS FOR REVIEW AND APPROVAL. ALL ROADS SHALL BE OPEN TO TRAFFIC WITH NO PERMANENT LANE CLOSURES ALLOWED. CONTRACTOR SHALL CONFORM TO THE LATEST EDITIONS OF MANUAL ON UNIFORM TRAFFIC CONTROL DEVICES AND THE F.D.O.T. ROADWAY AND TRAFFIC DESIGN STANDARDS, INDEX 102-600 TO 102-680 AS APPLICABLE.
- C. ANY TEMPORARY ROAD CLOSURE REQUIRES AUTHORIZATION REQUEST MADE TO LAKE COUNTY ROAD OPERATIONS AT (352) 343-6439 AND WITH AT LEAST THREE (3) DAYS NOTICE PRIOR TO CLOSURE. CONTRACTOR MUST SUPPLY A DETOUR PLAN WHEN REQUESTING CLOSURE. NO CLOSURE SHALL TAKE PLACE WITHOUT APPROVAL OF THE DETOUR PLAN. CONTRACTOR SHALL SUPPLY ALL SIGNAGE ASSOCIATED WITH CLOSURE AND DETOUR.
- D. IF EXISTING VEHICLE DETECTION LOOPS ARE DAMAGED DURING CONSTRUCTION, CONTRACTOR SHALL FURNISH, INSTALL, AND MAINTAIN TEMPORARY DETECTION LOOPS.

DRAINAGE

- A. IN ALL PONDS THAT REQUIRE FILL, THE CONTRACTOR SHALL USE WELL GRADED SAND FILL WITH NO MORE THAN 10% PASSING #200 SIEVE MATERIAL IN THE POND BANKS AND BOTTOM. AT NO TIME SHALL CLAYS/CLAYEY SOILS BE USED UNLESS AUTHORIZED BY THE DIRECTOR OF ENGINEERING OR HIS DESIGNEE. THE CONTRACTOR SHALL NOTIFY THE LAKE COUNTY CONSTRUCTION INSPECTOR 48 HOURS PRIOR TO THE COMMENCEMENT OF ANY POND CONSTRUCTION TO COORDINATE THE INSPECTION OF THE PROPOSED CONSTRUCTION PRACTICES AND MATERIALS TO BE USED.
- B. ALL CURB INLETS, DITCH BOTTOM INLETS, AND MANHOLES WITHIN THE RIGHT-OF-WAY SHALL HAVE TRAFFIC BEARING FRAMES AND COVERS OR GRATES MEETING HS-20 LOADING REQUIREMENTS.
- C. UNLESS OTHERWISE NOTED, ALL EXISTING DRAINAGE STRUCTURES WITHIN THE LIMITS OF CONSTRUCTION ARE TO REMAIN.
- D. THE CONTRACTOR SHALL BE RESPONSIBLE TO CONSTRUCT ALL PIPES, PIPE END TREATMENTS, AND DRAINAGE STRUCTURES WITHIN THE LIMITS OF CONSTRUCTION IN A DRY CONDITION OR AS APPROVED BY THE DIRECTOR OF ENGINEERING.
- E. CONSTRUCT ALL MITERED END SECTIONS PER F.D.O.T. DESIGN STANDARDS INDEX No. 430-021 FOR CROSS PIPES AND SIDE PIPES, RESPECTIVELY.
- F. SWALES SHOULD BE SODDED.

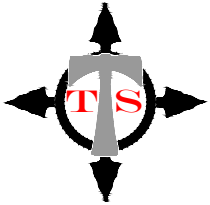

TOMAHAWK SURVEYING

Florida Licensed Business No. LB8449
115 Morningstar Drive
Punta Gorda, FL 33950
(941)-740-0733

DATE

06/19/2025

JOB#

24-79

DWG

24-79 ASB

SCALE

AS SHOWN

FOR REVIEW ONLY



DEPARTMENT OF PUBLIC WORKS
ENGINEERING DIVISION



LAKE
COUNTY, FL

350 N. SINCLAIR AVE., TAVARES, FLORIDA 32778

JEFFREY J. EARHART
P.E. NO. 49935

4/24/2024

REVISION:		DATE
S. -24	T. -245	R. -26E
SURVEYED: CM	DATE: 10/14/20	
FIELD BOOK: 229	PAGE: 45-46, 51	
DESIGNED: OEN	DATE: 4/24/2024	
DRAWN: OEN	DATE: 4/24/2024	
APPROVED: JE	DATE: 4/24/2024	
SAWGRASS BAY BLVD MULTILANE ROUNDABOUT GENERAL NOTES (2)		
JOB NO.: 20032CA		
SHEET: 4		

O:\2020\20032_SAWGRASS_BAY_BVLD_ROUNDABOUT_TOP\Engineering\Drawings\Plans\20032CA_SAWGRASS_ROUNDABOUT_6.dwg PLOTTED BY: Nunez, Osvaldo 4/24/2024 8:39 AM

LEGEND

FOR REVIEW ONLY

ASPH = ASPHALT	(P) = PLAT DIMENSION
BWF = BARBED WIRE FENCE	PB = PLAT BOOK
(C) = CALCULATED DIMENSION	PC = POINT OF CURVATURE
C# = CURVE NUMBER (SEE CURVE TABLE)	PCC = POINT OF COMPOUND CURVATURE
CL = CENTERLINE	PG = PAGE
CCR = CERTIFIED CORNER RECORD	PI = POINT OF INTERSECTION
CLF = CHAIN LINK FENCE	POB = POINT OF BEGINNING
CM = CONCRETE MONUMENT	POC = POINT OF COMMENCEMENT
CMP = CORRUGATED METAL PIPE	PRC = POINT OF REVERSE CURVATURE
CONC = CONCRETE	PT = POINT OF TANGENCY
(D) = DESCRIPTION DIMENSION	PVC = POLY VINYL CHLORIDE
DB = DEED BOOK	PVCFN = POLY VINYL CHLORIDE FENCE
DWG = DRAWING	R = RANGE
IR = IRON ROD	RCP = REINFORCED CONCRETE PIPE
IRC = IRON ROD AND CAP	RMB = ROAD MAP BOOK
L# = LINE NUMBER (SEE LINE TABLE)	RT = RIGHT
LT = LEFT	R/W = RIGHT-OF-WAY
FB = FIELD BOOK	SEC = SECTION
FDOT = FLORIDA DEPARTMENT OF TRANSPORTATION	STA = STATION
FND = FOUND	T = TOWNSHIP
HDPE = HIGH DENSITY POLYETHYLENE PIPE	VCP = VITRIFIED CLAY PIPE
N&D = NAIL AND DISK	WFF = WIRE FIELD FENCE
ORB = OFFICIAL RECORDS BOOK	WBF = WOOD BOARD FENCE
O/S = OFFSET	WRF = WOOD RAIL FENCE


STANDARD ABBREVIATIONS

<u>A</u>	<u>F</u>	<u>N</u>	<u>S</u>
AC. ACRE	F.G. FINISHED GRADE	N NORTH	S SOUTH
ALT. ALTERNATE	FND FOUND	N&C NAIL & CAP	SHT. SHEET
A/U AERIAL UTILITIES	FUT FUTURE	N&D NAIL & DISK	SQ SQUARE
		NIC NOT IN CONTRACT	STD. STANDARD
			SS STORM SEWER
<u>B</u>	<u>G</u>	<u>O</u>	<u>T</u>
BL BASE LINE	GND. GROUND	OPNG. OPENING	T&B TOP & BOTTOM
BM BENCH MARK	GP GRADE POINT	OPT. OPTION	TBM TEMPORARY BENCH MARK
BOC BACK OF CURB	GW GUY WIRE	ORB OFFICIAL RECORD BOOK	TEL. TELEPHONE
BOT. BOTTOM			TOB TOP OF BANK
BW BARBED WIRE	<u>H</u>	<u>P</u>	TOS TOE OF SLOPE
	HOG HOG WIRE	PC POINT OF CURVE	T.P. TELEPHONE POLE
<u>C</u>	H.W. HIGH WATER	PCC POINT OF COMPOUND CURVE	
(C) CALCULATED DIMENSION		P.C.M. PERMANENT CONTROL MONUMENT	<u>U</u>
CCR CERTIFIED CORNER RECORD		P.R.L.C. PUBLIC RECORDS OF LAKE COUNTY, FLORIDA	U.G. UNDERGROUND
CLR. CLEAR / CLEARANCE	<u>I</u>		U.G.P. UNDERGROUND POWER
CM CONCRETE MONUMENT	INT. INTERSECTION	PG PAGE	U.O.N. UNLESS OTHERWISE NOTED
CMP CORRUGATED METAL PIPE	I.P. IRON PIPE	PK CASE HARDENED NAIL	U.T.C. UNDERGROUND TELEPHONE CABLE
CL CHAIN LINK FENCE		PI POINT OF INTERSECTION	UTIL. UTILITY
CP COMBINATION POLE	<u>J</u>	POB POINT OF BEGINNING	
CPP CORRUGATED PLASTIC PIPE	JOINT	PP POWER POLE	<u>V</u>
CONST. CONSTRUCT / CONSTRUCTION		PROP. PROPOSED	VAR. VARIES
CULV CULVERT	<u>L</u>	PRC POINT OF REVERSE CURVE	
	LMRK LIME ROCK	PT POINT OF TANGENCY	
<u>D</u>	L.P. LIGHT POLE		
DET. DETAIL	LTD LIGHTED		
D/W DRIVEWAY	L.W. LOW WATER		
		<u>Q</u>	<u>W</u>
<u>E</u>	<u>M</u>		W WEST
E EAST	MATL. MATERIAL		W/ WITH
ELLIP ELLIPTICAL	(M) MEASURED DIMENSION	R.C. REINFORCED CONCRETE	W/ OUT WITH OUT
ENGR. ENGINEER	MEG MATCH EXIST. GRADE	RCP REINFORCED CONCRETE PIPE	W.R.A. WATER RETENTION AREA
EOC EDGE OF CONCRETE	MFR. MANUFACTURER	RD. ROAD	W.S. WATER SURFACE
EOM EDGE OF MAINTENANCE	MON. MONUMENT	RLS REGISTERED LAND SURVEYOR	W.S.EL. WATER SURFACE ELEVATION
EOT EDGE OF TRAVEL		REV. REVISION	
ESMT. EASEMENT		RPM REFLECTIVE PAVEMENT	<u>Y</u>

	= AIR CONDITIONER		= METER (ELECTRIC)		= UTILITY MARKER (GAS)
	= BENCH		= METER (GAS)		= UTILITY MARKER (H2O)
	= BOLLARD		= METER (WATER)		= UTILITY MARKER (NPW)
	= CLEAN OUT		= MONITOR WELL		= VALVE (UNKNOWN)
	= CABLE TV JUNCTION BOX		= PEDESTRIAN SIGNAL		= VALVE (BACKFLOW PREVENTER)
	= DELINEATOR POST		= PILLAR OR COLUMN		= VALVE (GAS)
	= ELECTRICAL JUNCTION BOX		= POST		= VALVE (RECLAIM)
	= ELECTRICAL OUTLET		= POWER POLE		= VALVE (SANITARY)
	= ELECTRICAL TRANSFORMER		= PUMP		= VALVE (WATER)
	= FIRE HYDRANT		= SIGN		= VAULT (CABLE TV)
	= FLAG POLE		= SIGNAL PEDESTAL		= VAULT (COMMUNICATIONS)
	= GUY POLE		= SIGNAL CONTROL CABINET		= VAULT (ELECTRICAL)
	= GUY WIRE		= SIGNAL MAST ARM		= VAULT (TELEPHONE)
	= HANDICAP PARKING		= SIGNAL SPAN WIRE POLE		= VAULT (TRAFFIC SIGNAL)
	= LIGHT POLE		= SOIL BORING		= WATER FAUCET
	= MAIL BOX		= SPRINKLER HEAD		= WELL
	= MANHOLE (UNKNOWN)		= TELEPHONE PEDESTAL		
	= MANHOLE (COMMUNICATIONS)		= TELEPHONE CABINET		
	= MANHOLE (DRAINAGE)		= UTILITY MARKER (CABLE TV)		
	= MANHOLE (ELECTRICAL)		= UTILITY MARKER (FIBER OPTIC)		
	= MANHOLE (SANITARY)		= UTILITY MARKER (ELECTRICAL)		
	= MANHOLE (TELEPHONE)		= UTILITY MARKER (TELEPHONE)		

BA 	= BAY TREE	CR 	= CAMPHOR TREE	MY 	= CREPE MYRTLE TREE
BS 	= BUSH	CT 	= CITRUS TREE	NS 	= NON-SPECIFIC TREE
CD 	= CEDAR TREE	CY 	= CYPRESS TREE	OK 	= OAK TREE
CE 	= CHERRY TREE	ER 	= EAR TREE	PA 	= PALM TREE
CH 	= CHINABERRY TREE	MG 	= MAGNOLIA TREE	PN 	= PINE TREE
				SY 	= SYCAMORE TREE


	= FOUND AXLE		= FOUND IRON ROD (SIZE AND MARKINGS AS NOTED)
	= BENCHMARK		= SET 5/8" IRON ROD WITH CAP "LAKE COUNTY LS6329"
	= CALCULATED CORNER		
	= FOUND BOX CUT OR SCRIBED "X"		
	= FOUND CONCRETE MONUMENT (SIZE AND MARKINGS AS NOTED)		
	= HUB AND TACK		
	= FOUND IRON PIPE (SIZE AND MARKINGS AS NOTED)		

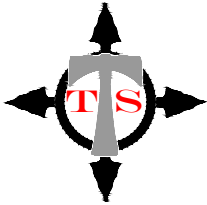

TOMAHAWK SURVEYING

Florida Licensed Business No. LB8449
115 Morningstar Drive
Punta Gorda, FL 33950
(941)-740-0733

DATE	JOB#	DWG	SCALE
06/19/2025	24-79	24-79 ASB	AS SHOWN

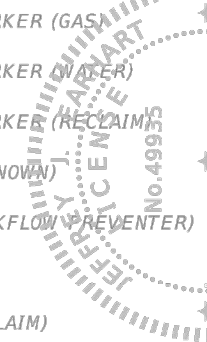

DEPARTMENT OF PUBLIC WORKS
ENGINEERING DIVISION
LAKE COUNTY, FL
350 N. SINCLAIR AVE., TAVARES, FLORIDA 32778
JEFFREY J. EARTHART P.E. NO. 49935

DATE	REVISION:	R. - 26E	T. - 24S	S. - 24	SURVEYED: CM	DATE: 10/14/20	DESIGNED: OEN	DATE: 4/24/2024	DRAWN: OEN	DATE: 4/24/2024	APPROVED: JE	DATE: 4/24/2024
					FIELD BOOK: 229	PAGE: 45-46, 51						

SAWGRASS BAY BLVD
MULTILANE ROUNDABOUT
LEGENDS

JOB NO.: 20032CA
SHEET: 5

O:\2020\20032_SAWGRASS_BAY_BLDV_ROUNDABOUT_TOP\Engineering\Drawings\Plans\20032CA_SAWGRASS_ROUNDABOUT_6.dwg PLOTTED BY: Nunez, Osvaldo 4/24/2024 8:39 AM


EROSION AND SEDIMENT CONTROL

- A. ALL INLETS, MITERED END SECTIONS, AND END WALLS SHALL BE PROTECTED WITH SOD (5' OF SOD IN ALL DIRECTIONS) PER F.D.O.T. DESIGN STANDARDS INDEX NO. 570-001, INDEX 524-001, AND AS SHOWN ON THE CONSTRUCTION PLANS.
- B. THE LOCATION OF THE MINIMUM REQUIRED EROSION AND SEDIMENT CONTROL MEASURES, SUCH AS SILT FENCES AND TURBIDITY BARRIERS, ARE SUMMARIZED ON THE PLAN SHEETS. SEE SHEET C-6 FOR TYPICAL INSTALLATION DETAILS.
- C. SOIL TRACKING PREVENTION DEVICES SHALL BE CONSTRUCTED AT POINTS OF EGRESS FROM UNSTABLE AREAS OF THE PROJECT TO ROADS WHERE OFF SITE TRACKING OF MATERIAL COULD OCCUR. SEE SHEET C-6 FOR DETAILS.
- D. SOD SHALL BE PLACED IMMEDIATELY AROUND NEW MITERED END SECTIONS AND AREAS SUBJECT TO EROSION PER FDOT INDEX 524-001.
- E. ALL DISTURBED AREAS SHALL BE SODDED, UNLESS OTHERWISE NOTED. CONTRACTOR IS RESPONSIBLE FOR WATERING AND MAINTAINING SOD UNTIL FULLY ESTABLISHED AND AS ADDITIONALLY SHOWN ON THE CONSTRUCTION PLANS.
- F. SOD SHALL BE REPLACED WITH ORIGINAL TYPE ON ALL RESIDENTIAL LOTS AND AS SHOWN ON PLANS.


- G. CONTRACTOR SHALL DE-SILT ALL DRAINS, PIPES AND SWALES WITHIN PROJECT BOUNDARY AT COMPLETION OF CONSTRUCTION.
- H. IT IS THE CONTRACTOR'S RESPONSIBILITY TO PROVIDE IN WRITING A STORM WATER POLLUTION PREVENTION PLAN (SWPPP) TO THE COUNTY FOR APPROVAL PRIOR TO BEGINNING ANY CONSTRUCTION ACTIVITIES.
- I. EROSION AND SEDIMENT CONTROL MEASURES SHOWN ON THE PLAN SHEETS SHALL BE PLACED PRIOR TO OR AS THE FIRST STEP IN CONSTRUCTION AND ARE THE MINIMUM REQUIRED. ADDITIONAL CONTROLS SHALL BE FURNISHED AS NEEDED AT NO ADDITIONAL COST. MATERIALS FROM WORK ON THESE PROJECTS SHALL BE CONTAINED AND NOT ALLOWED TO COLLECT ON ANY OFF PERIMETER AREAS OR IN WATERWAYS. SILT FENCES, TURBIDITY BARRIERS, AND OTHER ESSENTIAL EROSION CONTROL MEASURES MUST REMAIN IN PLACE AND IN GOOD CONDITION AT ALL LOCATIONS IN THE CONSTRUCTION PLANS OR AS REQUIRED UNTIL SOILS ARE STABILIZED, VEGETATION HAS BEEN ESTABLISHED AND THE CONTRACT IS COMPLETE. MEASURES SHOWN ARE THE MINIMUM REQUIRED, AND THE CONTRACTOR SHALL ENSURE THAT THERE IS NO DIRECT OR INDIRECT DISCHARGE OF CONSTRUCTION MATERIALS INTO OFF SITE AREAS OR WATERWAYS ETC.. EROSION AND SEDIMENT CONTROL MEASURES SHALL BE REMOVED AT THE COMPLETION OF CONSTRUCTION.
- J. PEGGED SOD SHALL BE PLACED ON ALL SLOPES 3:1 OR STEEPER.

SILT FENCE TYPE III

NOTE:
EROSION, SEDIMENT AND TURBIDITY CONTROL SHALL BE MAINTAINED AT ALL TIMES DURING AND AFTER CONSTRUCTION OF THE PROJECT. THESE CONTROL MEASURES ARE ONLY THE MINIMUM REQUIRED AND ADDITIONAL CONTROLS SHALL BE UTILIZED AS NEEDED, DEPENDENT UPON ACTUAL SITE CONDITIONS AND CONSTRUCTION OPERATIONS.

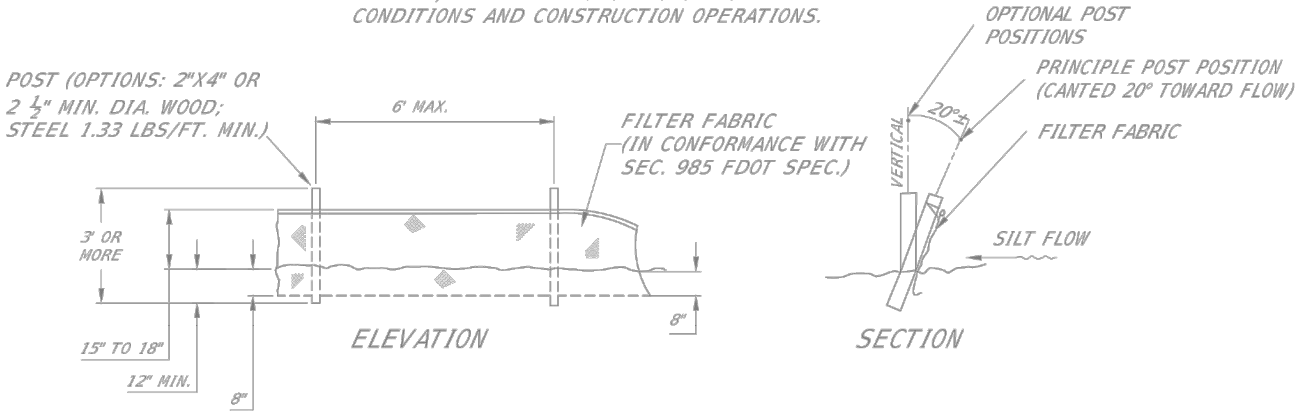

SILT FENCE APPLICATIONS

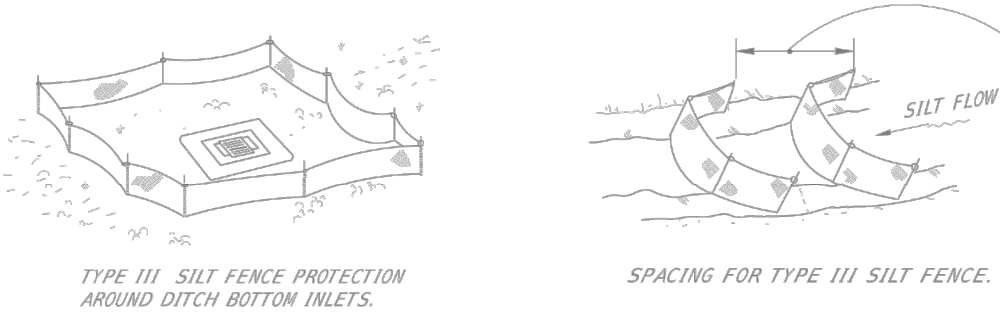

DO NOT DEPLOY IN A MANNER THAT SILT FENCES WILL ACT AS A DAM ACROSS PERMANENT FLOWING WATERCOURSES. SILT FENCES ARE TO BE USED AT UPLAND LOCATIONS.

EROSION & SEDIMENT CONTROL

PRIOR TO INITIATING CONSTRUCTION OF PLANNED IMPROVEMENTS, ALL SWALES WILL BE EXCAVATED AND ROUGH GRADED TO PROVIDE SEDIMENT AND RUNOFF CONTROL DURING CONSTRUCTION.

ALL DISTURBED AREAS WILL BE BROUGHT TO FINAL GRADE AND SODDED AS SOON AS POSSIBLE.

AREAS WHICH MAY ERODE DUE TO SLOPES OR CONCENTRATED RUNOFF DURING CONSTRUCTION WILL BE PROTECTED AT A MINIMUM WITH SILT FENCING AS SHOWN ON THE PLAN SHEETS.

UPON COMPLETION OF SITE IMPROVEMENTS, THE RETENTION PONDS, SWALES, AND OTHER STORM WATER MANAGEMENT DEVICES WILL BE FINAL GRADED AND SODDED AS SPECIFIED IN THE APPROVED CONSTRUCTION PLANS.

ROUTINE MAINTENANCE - STORM WATER

AFTER COMPLETION OF CONSTRUCTION, SWALES WILL BE MOWED AND MAINTAINED AS PART OF THE COUNTY ROAD MAINTENANCE.

TRASH AND DEBRIS THAT ACCUMULATES WITHIN THE RETENTION PONDS, SWALES, PIPES, AND INLETS WILL BE MANUALLY COLLECTED AND DISPOSED OF WITH OTHER NORMAL SOLID WASTE.

ANY EROSION, LOSS OF GRASS, ETC., WILL BE REPAIRED OR REPLACED ROUTINELY AND AS NEEDED.

FOR 1% SLOPE
FOR 2.5% SLOPE
FOR SLOPES 3:1
2.5%, CONSIDER
TEMPORARY
SOD PER FDOT
PLANS 570-001



TOMAHAWK SURVEYING

Florida Licensed Business No. LB8449
115 Morningstar Drive
Punta Gorda, FL 33950
(941)-740-0733

DATE	JOB#	DWG	SCALE
06/19/2025	24-79	24-79 ASB	AS SHOWN

JEFFREY J. EARHART
No. 49935
LICENSE

STATE OF FLORIDA
PROFESSIONAL ENGINEERING
DATE: 4/24/2024
SIGNATURE: Jeffrey J. Earhart

JEFFREY J. EARHART P.E. NO. 49935


DEPARTMENT OF PUBLIC WORKS
ENGINEERING DIVISION
LAKE COUNTY, FL
350 N. SINCLAIR AVE., TAVARES, FLORIDA 32778

DATE	REVISION:	R. - 26E	T. - 24S	S. - 24	SURVEYED: CM	DATE: 10/14/20	FIELD BOOK: 229	PAGE: 45-46, 51	DESIGNED: OEN	DATE: 4/24/2024	DRAWN: OEN	DATE: 4/24/2024	APPROVED: JE	DATE: 4/24/2024
SAWGRASS BAY BLVD MULTILANE ROUNDABOUT EROSION NOTES AND DETAILS														
JOB NO.: 20032CA														
SHEET: 6														

FOR REVIEW ONLY




TYPICAL CONCRETE SIDEWALK DETAIL

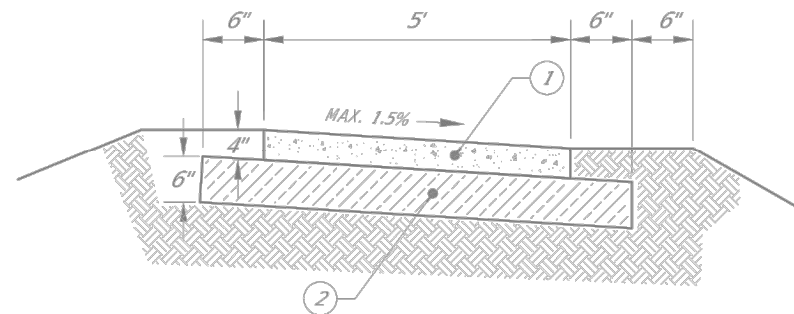

KEY: (1) 4" THICK x 5' WIDE, 3000 PSI CONCRETE WITH FIBER MESH.
(2) 6" COMPACTED BASE - MIN. 95%, AASHTO T-99

SCALE: N.T.S.

SIDEWALK RAMP AND CROSS WALK (PAVEMENT MARKING) DETAIL

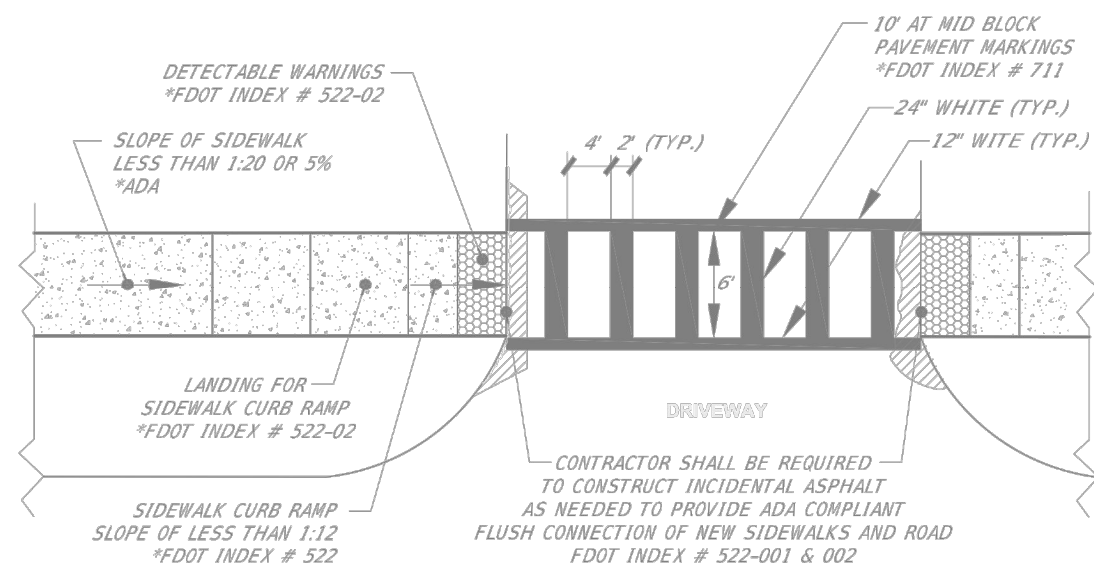


NOTE:

1. 4" 3,000 PSI CONCRETE SIDEWALK AND TRAILS INTERSECTING ROADWAYS, COMMERCIAL DRIVENWAYS, AND DRIVENWAYS OF 24 FEET OR GREATER IN WIDTH SHALL HAVE CONCRETE RAMPS CONSTRUCTED PER FDOT DESIGN STANDARDS 304 & 310. WITH RAMPS AND LANDINGS CONSTRUCTED OF 6" 3,000 PSI FIBER REINFORCED CONCRETE.
2. ALL SIDEWALK AND TRAIL APPROACHES SHALL HAVE DETECTABLE WARNING SURFACES THAT EXTENDED THE FULL WIDTH OF THE APPROACH AND TWENTY FOUR (24) INCHES IN THE DIRECTION OF TRAVEL.
3. ALL DETECTABLE WARNING SURFACES SHALL BE CONSTRUCTED IN ACCORDANCE WITH FDOT SPECIFICATION 527, FDOT DESIGN STANDARDS 304, UNITED STATES ACCESS BOARD/ADA SPECIFICATIONS, AND BE INSTALLED SUCH THAT THE EDGE OF THE DETECTABLE WARNING SURFACE IS FLUSH WITH THE FINISHED GRADE OF THE APPROACH SURFACE.
4. DETECTABLE WARNING SURFACES WITHIN COUNTY RIGHT-OF-WAY SHALL BE CAST-IN-PLACE. THE SUPPLIERS FOR THESE DETECTABLE WARNING MATS MUST BE APPROVED SUPPLIERS ON THE MOST RECENT FDOT APPROVED PRODUCT LIST (APL) SPECIFICATION 527 DETECTABLE WARNINGS ON WALKABLE SURFACES.
5. DETECTABLE WARNING COLOR SHALL BE BRICK RED.


SCALE: N.T.S.

TYPICAL SIDEWALK JOINT DETAIL

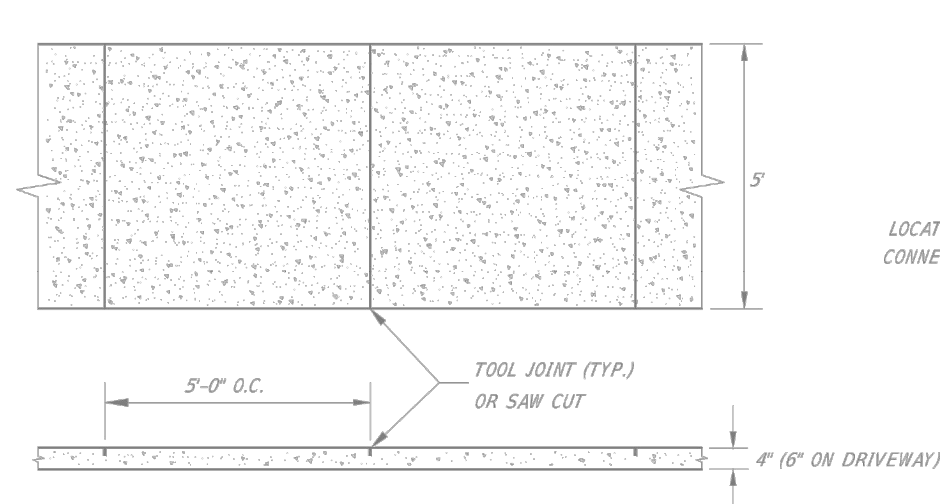


NOTE:

1. SIDEWALK SHALL BE MIN. 5' WIDE AND 4" THICK 3000 PSI CONCRETE
6" THICK 3000 PSI CONCRETE WITH FIBER MESH ON ALL DRIVEWAY
2. 6" COMPACTED BASE - MIN. 95%, AASHTO T-99
3. 3/16" WIDE SAW CUT JOINTS, 1-1/2" DEEP, MAX. 5' CENTER
4. 1/2" EXPANSION JOINT WHEN RUN OF SIDEWALK EXCEEDS 120'.
INTERMEDIATE LOCATIONS WHEN CALLED FOR IN THE PLANS OR AT
LOCATIONS AS DIRECTED BY THE ENGINEER.
5. INSTALL PER FDOT DESIGN STANDARDS AND STANDARD SPECIFICATIONS
FOR ROAD AND BRIDGE CONSTRUCTION, LATEST EDITIONS.
6. ALL SIDE WALK AND RAMP CONSTRUCTION MUST MEET ADA SPECIFICATIONS.
7. SOD ALL DISTURBED AREAS.
8. COMPACT ALL FILL AREAS TO 95% COMPACTION, AASHTO T-99.
9. THE RUNNING GRADE SLOPE OF THE SIDEWALK SHALL BE 5% MAX
10. THE CROSS SLOPE OF THE SIDEWALK SHALL NOT EXCEED 1 IN 4
11. CONCRETE FINISH TO BE BROOM FINISH, NO PICTURE FRAME

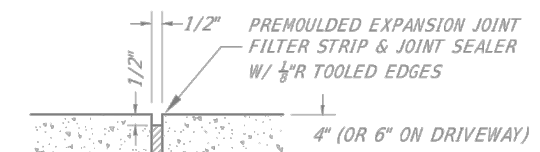


EXPANSION JOINT

LOCATE AT 120' INTERVALS IN SIDEWALK OR WHEN
CONNECTING TO EXISTING SIDEWALK OR DRIVEWAYS

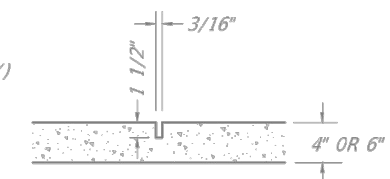


SAWED JOINT

LOCATE AT 5' INTERVALS IN SIDEWALK
SAW CUT WITHIN 24 HRS/KN AFTER CONCRETE POUR

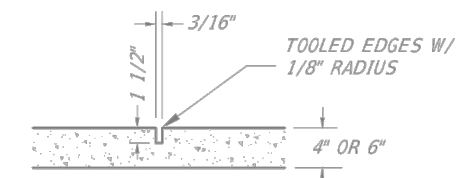

CONTRACTION JOINT

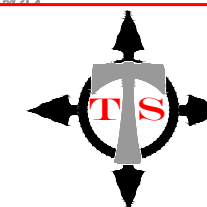

TOMAHAWK SURVEYING

Florida Licensed Business No. LB8449
115 Morningstar Drive
Punta Gorda, FL 33950
(941)-740-0733

DATE
06/19/2025

JOB#
24-79

DWG
24-79 ASB

SCALE
AS SHOWN

5, -24		T. -24S	R. -26E	REVISION.	DATE
SURVEYED:		CM	DATE: 10/14/20		
FIELD BOOK:		229	PAGE: 45-46; 51		
DESIGNED:		OEN	DATE: 4/24/2024		
DRAWN:		OEN	DATE: 4/24/2024		
APPROVED:		JE	DATE: 4/24/2024		

SAWGRASS BAY BLVD
MULTILANE ROUNDABOUT
GENERAL DETAILS

JOB NO.:
20032CA

SHEET:
8

0:\2020\20032_SAWGRASS_BAY_BVLD_ROUNDABOUT_TOPO\Engineering\Drawings\Plans\20032CA_SAWGRASS_ROUNDABOUT_6.dwg PLOTTED BY: Nunez, Osvaldo 4/24/2024 8:41 AM

Curve Table: Quad NW-North						
Curve #	Radius	Length	Start Point	End Point	Delta	Chord Direction
C2	300.00	86.32	(444633.79,1472865.17)	(444550.01,1472884.68)	016° 29' 11"	N76° 53' 18.60"W
C3	35.00	25.64	(444657.88,1472872.13)	(444633.79,1472865.17)	041° 58' 39"	S73° 52' 46.40"W

Line Table: Quad NW-North				
Line #	Length	Direction	Start Point	End Point
L3	4.60	N68° 38' 42.98"W	(444550.01,1472884.68)	(444545.72,1472886.36)

Curve Table: Quad NE-North						
Curve #	Radius	Length	Start Point	End Point	Delta	Chord Direction
C12	100.00	70.28	(444872.12,1472876.91)	(444805.89,1472858.12)	040° 16' 08"	S74° 09' 45.68"W

Line Table: Quad NE-North				
Line #	Length	Direction	Start Point	End Point
L10	31.03	S54° 01' 41.78"W	(444897.24,1472895.13)	(444872.12,1472876.91)

Curve Table: Quad NE-North-Inside EOP						
Curve #	Radius	Length	Start Point	End Point	Delta	Chord Direction
C13	111.01	62.99	(444816.44,1472844.40)	(444874.95,1472865.37)	032° 30' 33"	N70° 17' 05.62"E

Line Table: Quad NE-North Inside EOP				
Line #	Length	Direction	Start Point	End Point
L11	35.52	N54° 01' 41.78"E	(444874.95,1472865.37)	(444903.70,1472886.23)


Curve Table: Street 'B'						
Curve #	Radius	Length	Start Point	End Point	Delta	Chord Direction
C10	1146.00	157.37	(444740.89,1472759.45)	(444865.41,1472855.48)	007° 52' 04"	N52° 21' 35.85"E
C11	502.50	251.83	(444865.41,1472855.48)	(445087.02,1472969.45)	028° 42' 49"	N62° 48' 58.40"E

Curve Table: Quad NE-South-Inside EOP						
Curve #	Radius	Length	Start Point	End Point	Delta	Chord Direction
C14	100.00	7.67	(444828.71,1472818.86)	(444834.23,1472824.18)	004° 23' 46"	N46° 01' 46.72"E

Line Table: Quad NE-South Inside EOP				
Line #	Length	Direction	Start Point	End Point
L12	93.14	N48° 13' 39.59"E	(444834.23,1472824.18)	(444903.70,1472886.23)

Curve Table: Quad NE-South						
Curve #	Radius	Length	Start Point	End Point	Delta	Chord Direction
C15	110.00	20.11	(444832.73,1472766.19)	(444834.23,1472786.22)	010° 28' 32"	N4° 17' 32.04"E
C16	50.00	42.91	(444834.23,1472786.22)	(444850.92,1472824.34)	049° 10' 24"	N23° 38' 28.12"E

Line Table: Quad NE-South				
Line #	Length	Direction	Start Point	End Point
L13	80.04	N48° 13' 39.52"E	(444850.92,1472824.34)	(444910.61,1472877.65)

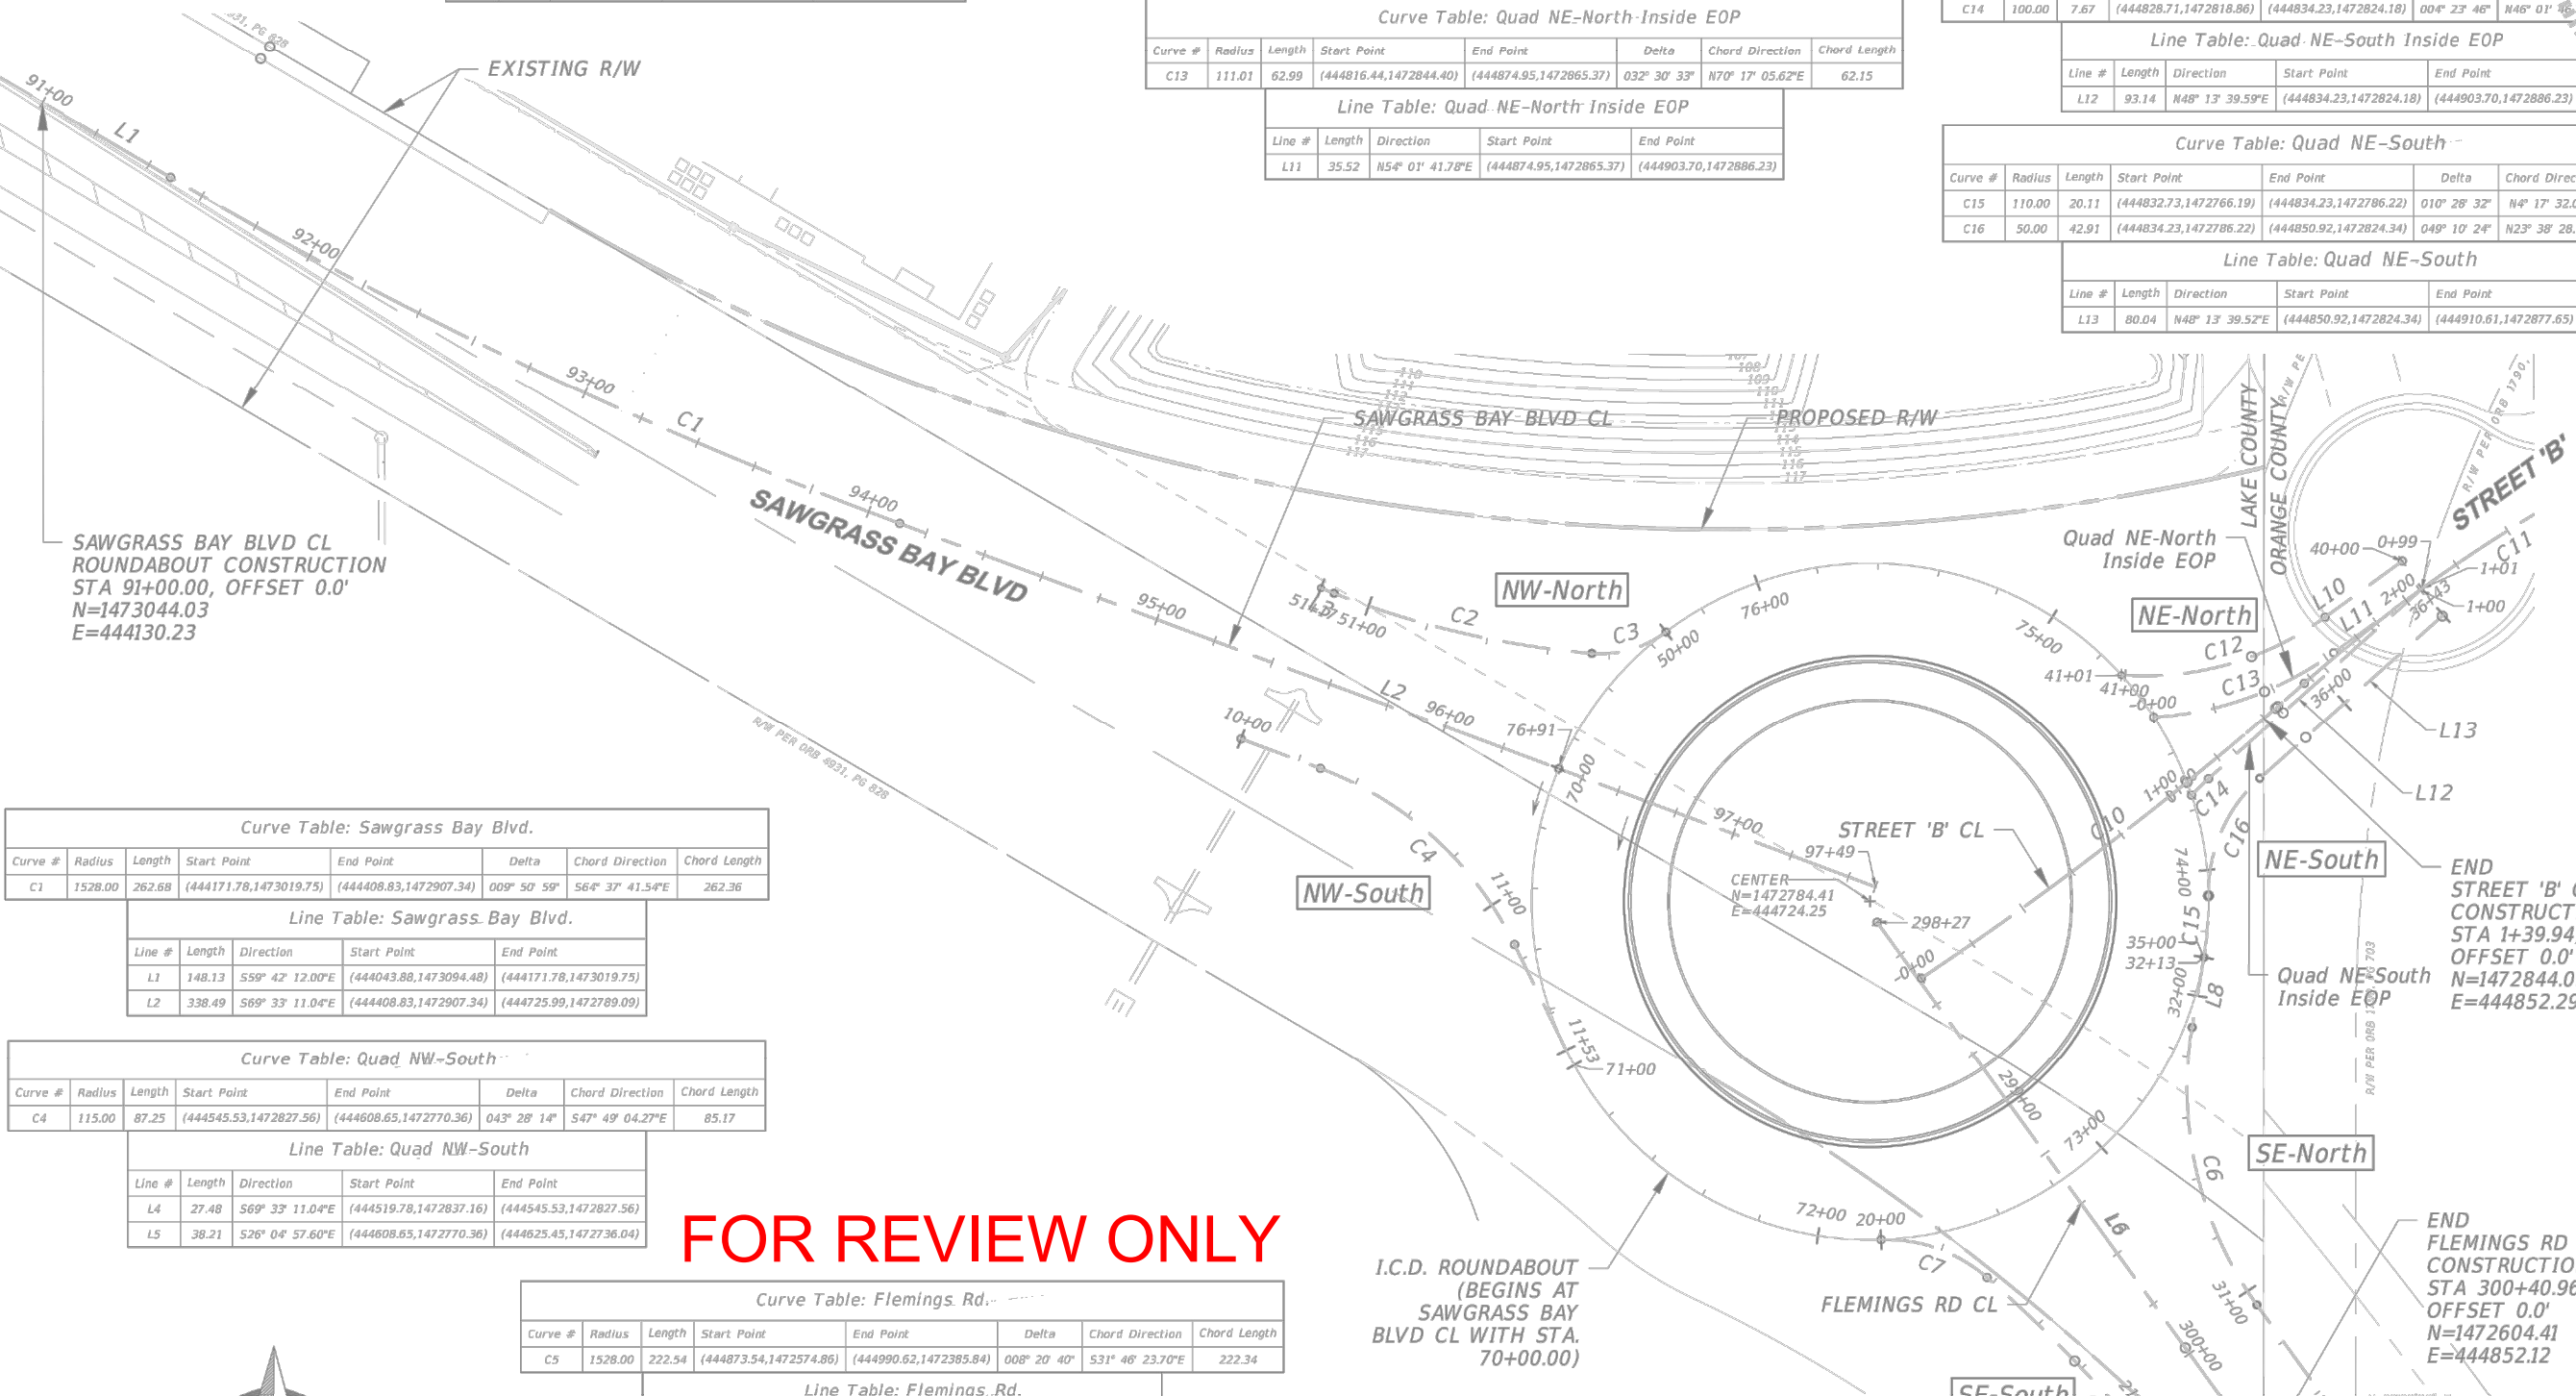

Curve Table: Sawgrass Bay Blvd.						
Curve #	Radius	Length	Start Point	End Point	Delta	Chord Direction
C1	1528.00	262.68	(444171.78,1473019.75)	(444408.83,1472907.34)	009° 50' 59"	S64° 37' 41.54"E

Line Table: Sawgrass Bay Blvd.				
Line #	Length	Direction	Start Point	End Point
L1	148.13	S59° 42' 12.00"E	(444043.88,1473094.48)	(444171.78,1473019.75)
L2	338.49	S69° 33' 11.04"E	(444408.83,1472907.34)	(444725.99,1472789.09)

Curve Table: Quad NW-South						
Curve #	Radius	Length	Start Point	End Point	Delta	Chord Direction
C4	115.00	87.25	(444545.53,1472827.56)	(444608.65,1472770.36)	043° 28' 14"	S47° 49' 04.27"E

Line Table: Quad NW-South				
Line #	Length	Direction	Start Point	End Point
L4	27.48	S69° 33' 11.04"E	(444519.78,1472837.16)	(444545.53,1472827.56)
L5	38.21	S26° 04' 57.60"E	(444608.65,1472770.36)	(444625.45,1472736.04)

Curve Table: Flemings Rd.						
Curve #	Radius	Length	Start Point	End Point	Delta	Chord Direction
C5	1528.00	222.54	(444873.54,1472574.86)	(444990.62,1472385.84)	008° 20' 40"	S31° 46' 23.70"E

Line Table: Flemings Rd.				
Line #	Length	Direction	Start Point	End Point
L6	250.46	S35° 56' 43.91"E	(444726.52,1472777.63)	(444873.54,1472574.86)
L7	100.00	S27° 35' 20.20"E	(444990.62,1472385.84)	(445036.93,1472297.21)

Curve Table: Quad SE-South						
Curve #	Radius	Length	Start Point	End Point	Delta	Chord Direction
C7	50.00	37.39	(444727.83,1472674.46)	(444762.25,1472662.24)	042° 50' 40"	S70° 26' 39.05"E
C8	450.00	110.13	(444762.25,1472662.24)	(444835.77,1472580.62)	014° 01' 19"	S42° 00' 39.40"E
C9	1501.00	28.85	(444835.77,1472580.62)	(444852.08,1472556.83)	001° 06' 04"	S34° 26' 57.96"E

Curve Table: Quad SE-North						
Curve #	Radius	Length	Start Point	End Point	Delta	Chord Direction
C6	120.00	95.02	(444849.98,1472653.35)	(444828.92,1472743.48)	045° 22' 11"	N13° 09' 17.85"E

Line Table: Quad SE-North				
Line #	Length	Direction	Start Point	End Point
L8	23.03	N9° 31' 47.93"E	(444828.92,1472743.48)	(444832.73,1472766.19)
L9	94.58	N35° 56' 43.91"W	(444905.50,1472576.78)	(444849.98,1472653.35)



TOMAHAWK SURVEYING
Florida Licensed Business No. LB8449
115 Morningstar Drive
Punta Gorda, FL 33950
(941)-740-0733

DATE 06/19/2025	JOB# 24-79	DWG 24-79 ASB	SCALE AS SHOWN
--------------------	---------------	------------------	-------------------

FOR REVIEW ONLY

DEPARTMENT OF PUBLIC WORKS
ENGINEERING DIVISION


LAKE COUNTY, FL
350 N. SINCLAIR AVE., TAVARES, FLORIDA 32778
JEFFREY J. EARHART P.E. NO. 49935

DATE	REVISION:	R - 26E	T - 245	S. - 24	SURVEYED: CM	DATE: 10/14/20	FIELD BOOK: 229	PAGE: 45-46, 51	DESIGNED: OEN	DATE: 4/24/2024	DRAWN: OEN	DATE: 4/24/2024	APPROVED: JE	DATE: 4/24/2024
SAWGRASS BAY BLVD MULTILANE ROUNDABOUT PROJECT CONTROL														JOB NO.: 20032CA
SHEET: 9														

0:\2020\20032_SAWGRASS_BAY_BVLD_ROUNDABOUT_TOPO\Engineering\Drawings\Plans\20032CA_SAWGRASS_ROUNDABOUT_6.dwg PLOTTED BY: Nunez, Osvaldo 4/24/2024 8:43 AM

FOR REVIEW ONLY

TYPICAL ROAD SECTION
SAWGRASS BAY EXTENSION 4-LANE BLVD

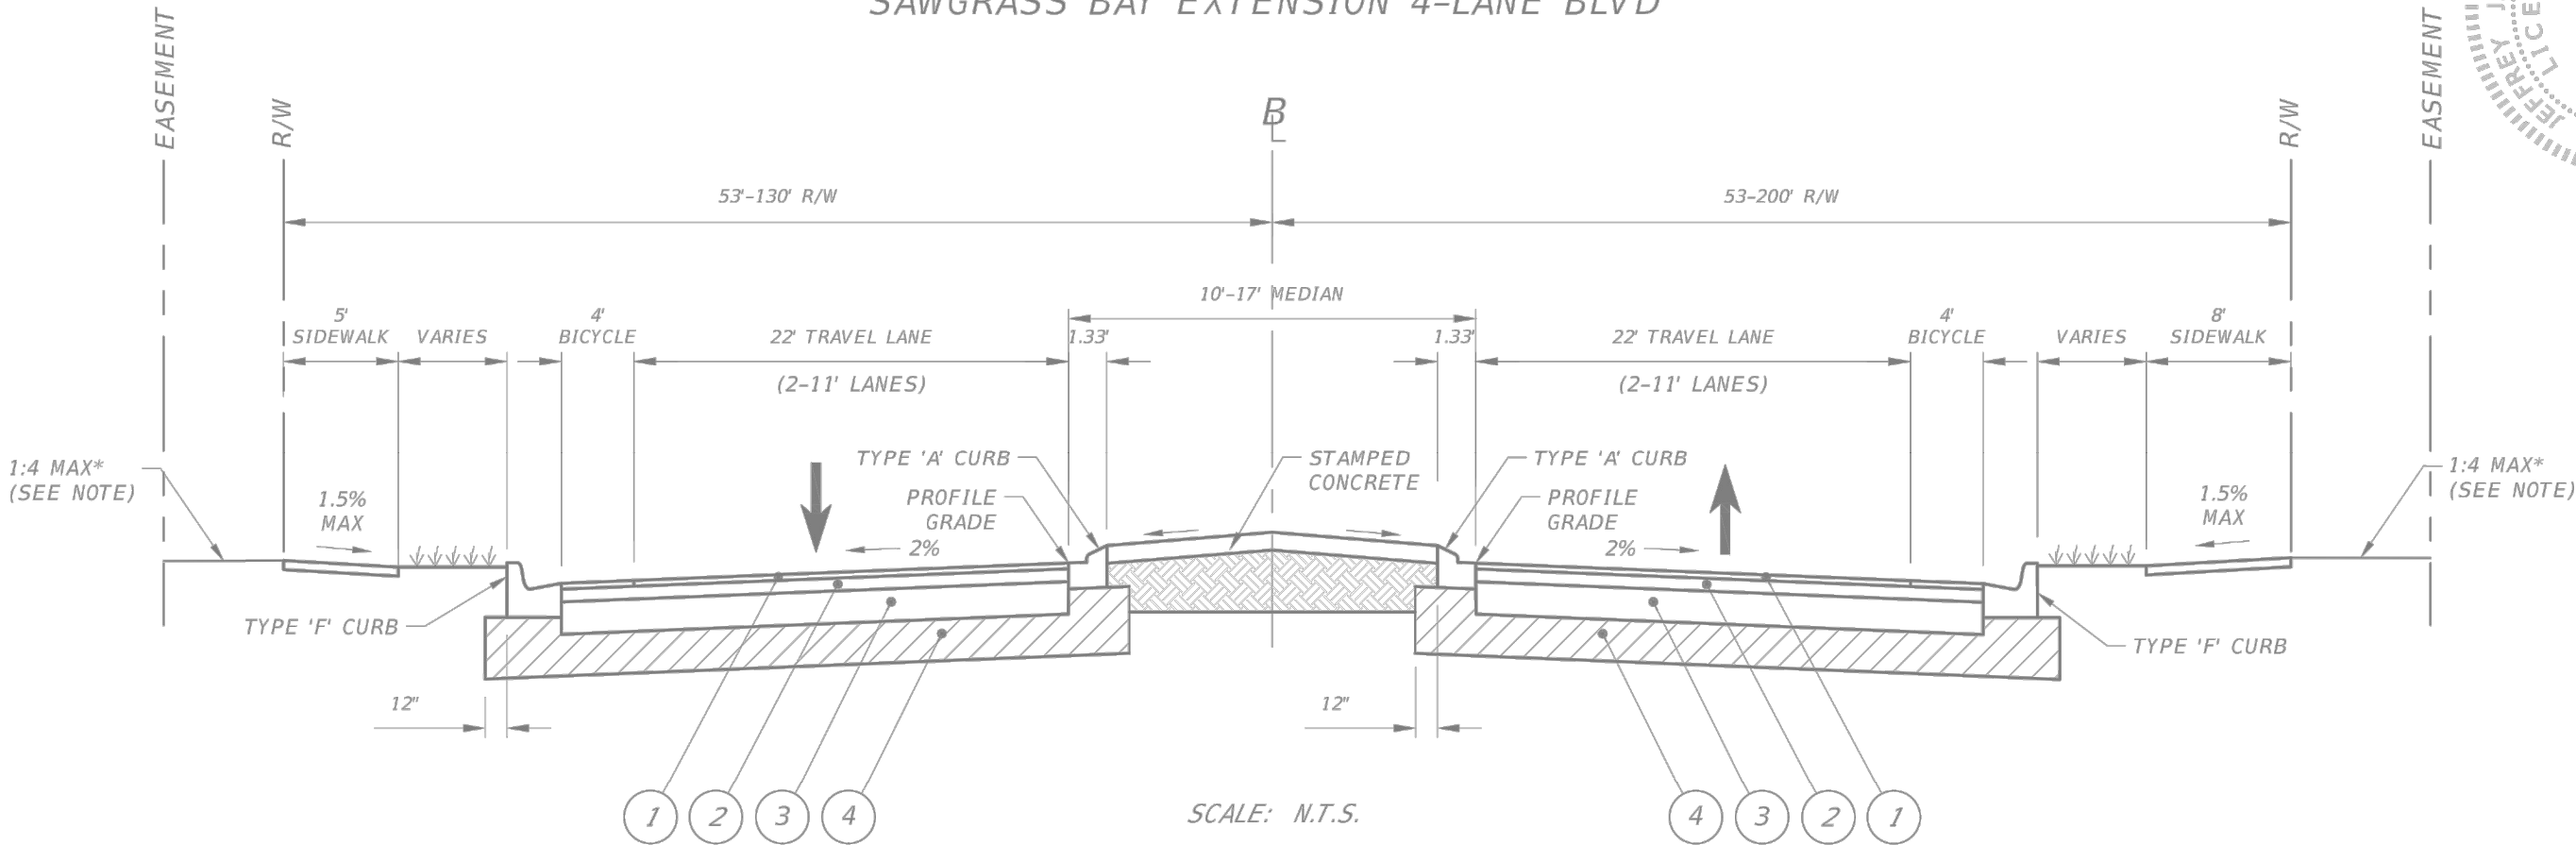


KEY:

1. 1" MIN. FICTION COURSE FC-9.5, ASPHALT TRAFFIC LEVEL C.
2. 2.5" MIN. STRUCTURAL COURSE, SP-12.5
3. 10" LIMEROCK, TO BE INSTALLED IN 2 LIFTS, 98% COMPACTION EACH LIFT, A.A.S.H.T.O. T-180, PRIMED AND SANDED.
4. 12" TYPE B STABILIZED SUBGRADE MIN. LBR 40, 98% COMPACTION, A.A.S.H.T.O. T-180

NOTES:

1. ALL STRIPING TO BE LEAD & SOLVENT FREE THERMOPLASTIC UNLESS OTHERWISE NOTED.
2. SOD ALL DISTURBED AREAS.
3. FINISH GRADE OF SHOULDER TO BE BELOW EDGE OF PAVEMENT TO ALLOW FOR SOD PER FDOT INDEX 570-010.
4. DESIGN SPEED IS 40 MPH. POST SPEED IS 35 MPH.

* TIE-IN SLOPE TO BE 1:4 MAX EXCEPT IN NW QUADRANT NORTH SIDE (EXIT LANE) WHERE TO PROVIDE COVER FOR

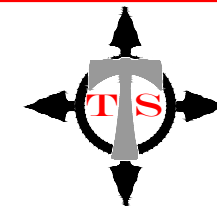

TOMAHAWK SURVEYING

Florida Licensed Business No. LB8449
115 Morningstar Drive
Punta Gorda, FL 33950
(941)-740-0733

DATE	JOB#	DWG	SCALE
06/19/2025	24-79	24-79 ASB	AS SHOWN



DEPARTMENT OF PUBLIC WORKS
ENGINEERING DIVISION
LAKE COUNTY, FL
350 N. SINCLAIR AVE., TAVARES, FLORIDA 32778
JEFFREY J. EARHART P.E. NO. 49935

REVISION:	DATE
S. -24	
T. -245	
R. -26E	
SURVEYED: CM	DATE: 10/14/20
FIELD BOOK: 229	PAGE: 45-46, 51
DESIGNED: OEN	DATE: 4/24/2024
DRAWN: OEN	DATE: 4/24/2024
APPROVED: JE	DATE: 4/24/2024


SAWGRASS BAY BLVD
MULTILANE ROUNDABOUT
SAWGRASS BAY BLVD TYPICAL

JOB NO.:
20032CA

SHEET:
11

O:\2020\20032_SAWGRASS_BAY_BLDV_ROUNDABOUT_TOPO\Engineering\Drawings\Plans\20032CA_SAWGRASS_ROUNDABOUT_6.dwg PLOTTED BY: Nunez, Osvaldo 4/24/2024 8:43 AM

FOR REVIEW ONLY

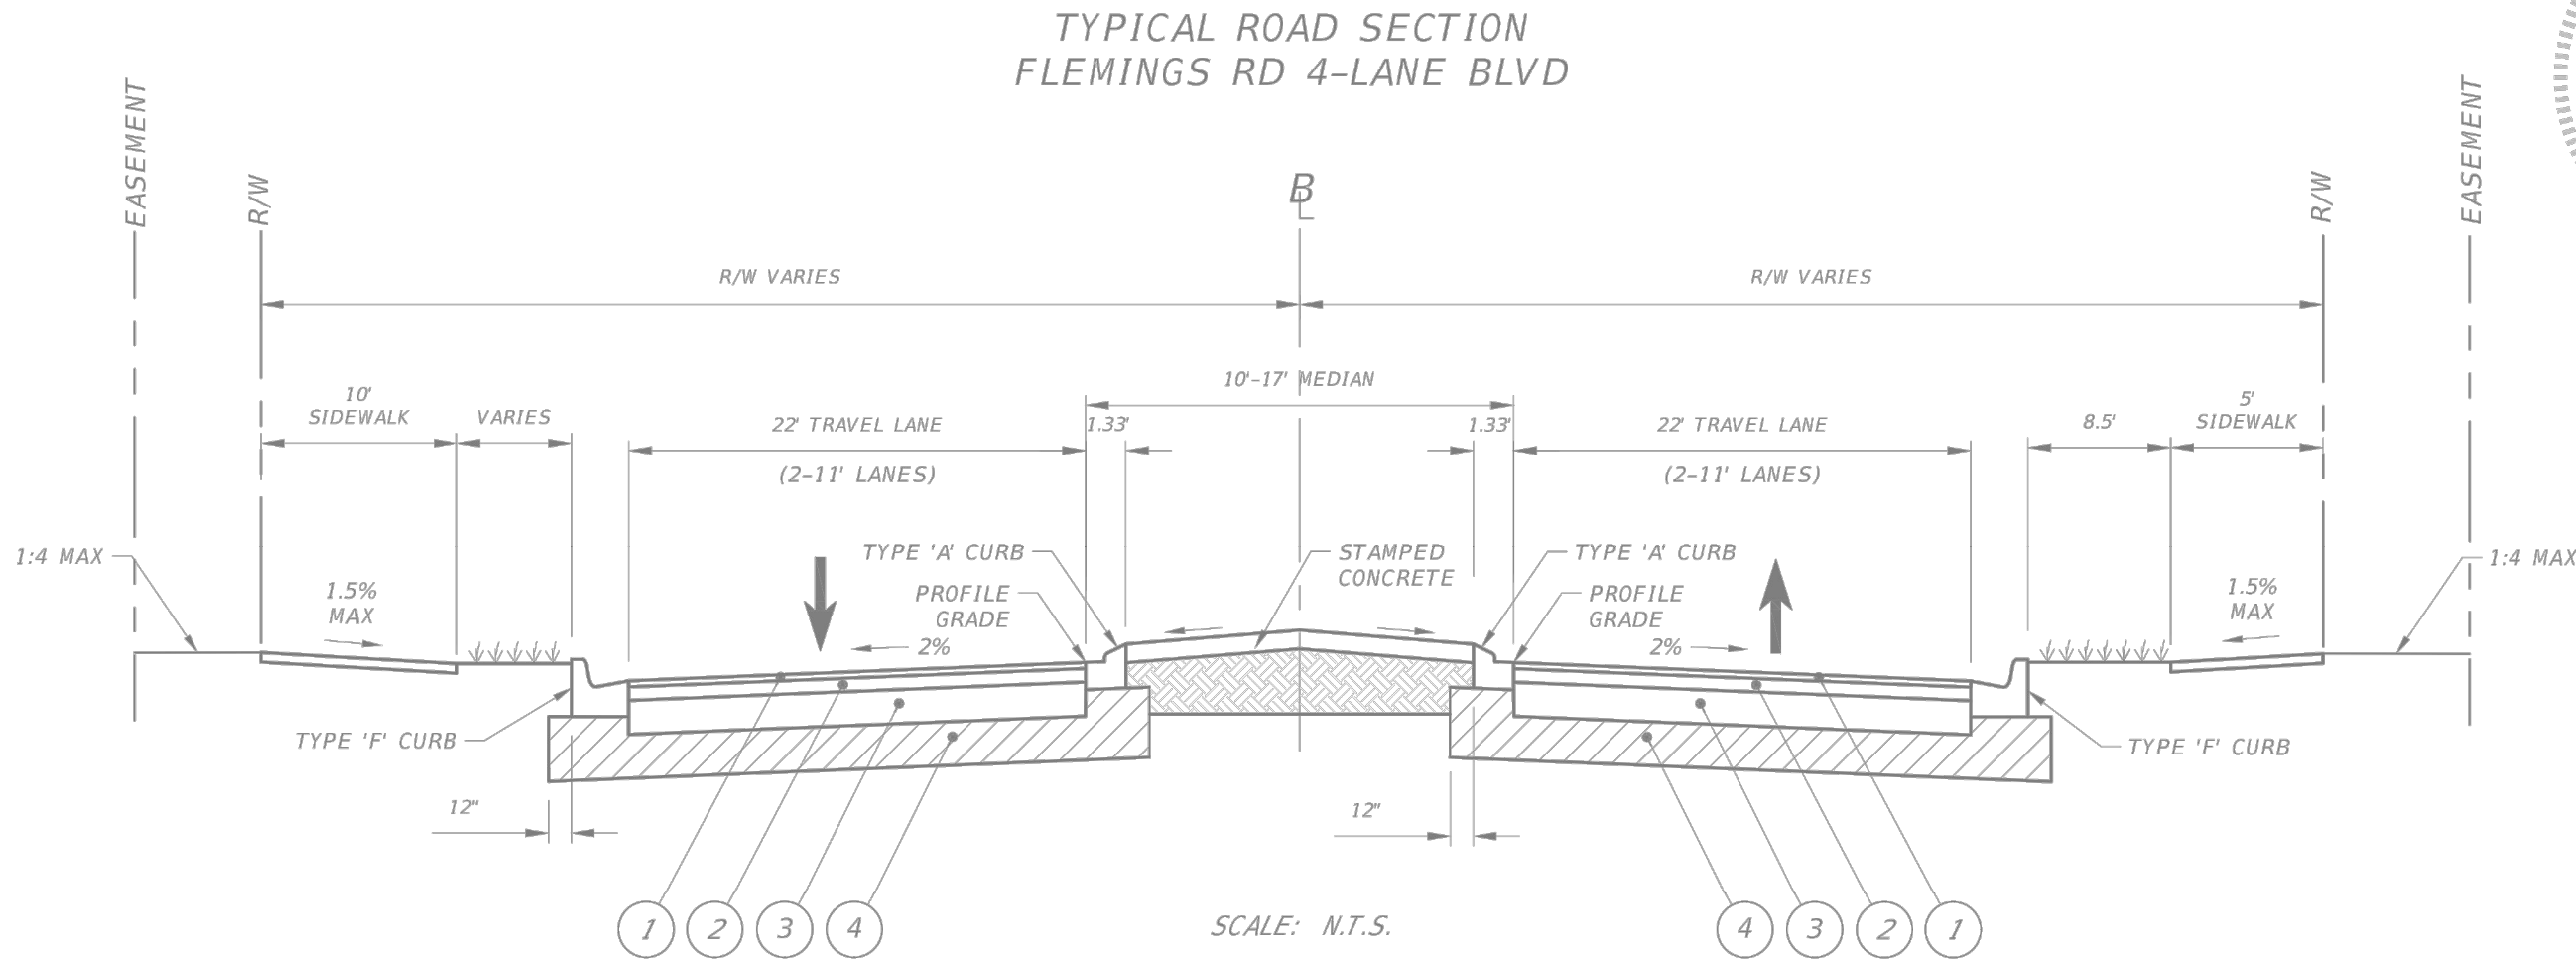


KEY:

- 1" MIN. FICTION COURSE FC-9.5, ASPHALT TRAFFIC LEVEL C.
- 2.5" MIN. STRUCTURAL COURSE, SP-12.5
- 10" LIMEROCK, TO BE INSTALLED IN 2 LIFTS, 98% COMPACTION EACH LIFT, A.A.S.H.T.O. T-180, PRIMED AND SANDED.
- 12" TYPE B STABILIZED SUBGRADE MIN. LBR 40, 98% COMPACTION, A.A.S.H.T.O. T-180

NOTES:

- ALL STRIPING TO BE LEAD & SOLVENT FREE THERMOPLASTIC UNLESS OTHERWISE NOTED.
- SOD ALL DISTURBED AREAS.
- FINISH GRADE OF SHOULDER TO BE BELOW EDGE OF PAVEMENT TO ALLOW FOR SOD PER FDOT INDEX 570-010.
- DESIGN SPEED IS 40 MPH. POST SPEED IS 35 MPH.

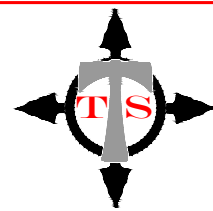

TOMAHAWK SURVEYING

Florida Licensed Business No. LB8449
115 Morningstar Drive
Punta Gorda, FL 33950
(941)-740-0733

DATE	JOB#	DWG	SCALE
06/19/2025	24-79	24-79 ASB	AS SHOWN



DEPARTMENT OF PUBLIC WORKS
ENGINEERING DIVISION

LAKE COUNTY, FL

350 N. SINCLAIR AVE., TAVARES, FLORIDA 32778

JEFFREY J. EARHART P.E. NO. 49935

REVISION:	DATE
S. -24	
T. -245	
R. -26E	
SURVEYED: CM	DATE: 10/14/20
FIELD BOOK: 229	PAGE: 45-46, 51
DESIGNED: OEN	DATE: 4/24/2024
DRAWN: OEN	DATE: 4/24/2024
APPROVED: JE	DATE: 4/24/2024


SAWGRASS BAY BLVD
MULTILANE ROUNDABOUT
FLEMINGS RD TYPICAL

JOB NO.:
20032CA

SHEET:
12

O:\2020\20032_SAWGRASS_BAY_BVLD_ROUNDABOUT_Topo\Engineering\Drawings\Plans\20032CA_SAWGRASS_ROUNDABOUT_6.dwg PLOTTED BY: Nunez, Osvaldo 4/24/2024 8:43 AM

FOR REVIEW ONLY

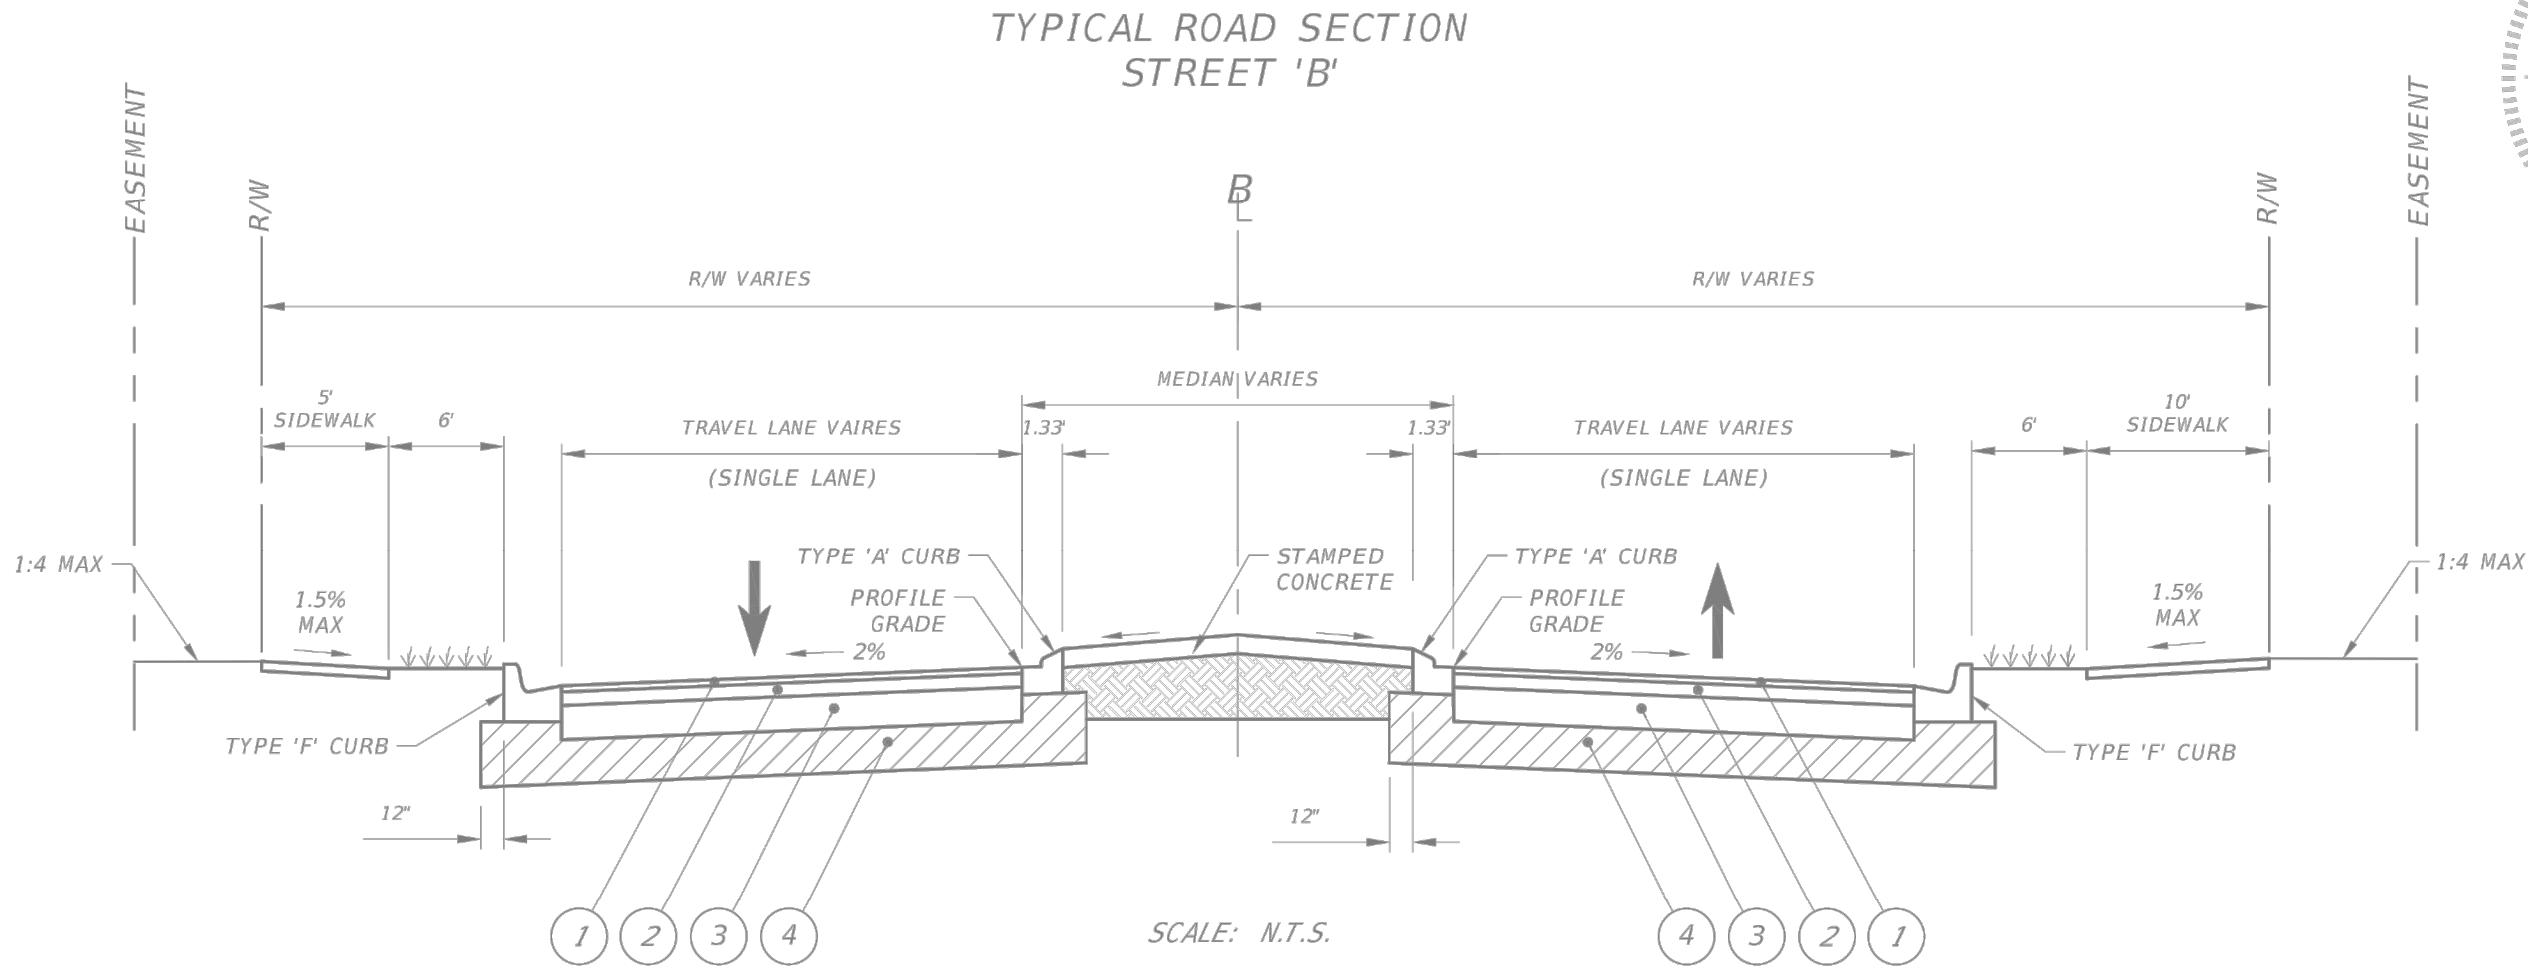

KEY:

1. 1" MIN. FICTION COURSE FC-9.5, ASPHALT TRAFFIC LEVEL C.
2. 2.5" MIN. STRUCTURAL COURSE, SP-12.5
3. 10" LIMEROCK, TO BE INSTALLED IN 2 LIFTS, 98% COMPACTION EACH LIFT, A.A.S.H.T.O. T-180, PRIMED AND SANDED.
4. 12" TYPE B STABILIZED SUBGRADE MIN. LBR 40, 98% COMPACTION, A.A.S.H.T.O. T-180

NOTES:


1. ALL STRIPING TO BE LEAD & SOLVENT FREE THERMOPLASTIC UNLESS OTHERWISE NOTED.
2. SOD ALL DISTURBED AREAS.
3. FINISH GRADE OF SHOULDER TO BE BELOW EDGE OF PAVEMENT TO ALLOW FOR SOD PER FDOT INDEX 570-010.
4. DESIGN SPEED IS 40 MPH. POST SPEED IS 35 MPH.



TOMAHAWK SURVEYING


Florida Licensed Business No. LB8449
115 Morningstar Drive
Punta Gorda, FL 33950
(941)-740-0733

DATE	JOB#	DWG	SCALE
06/19/2025	24-79	24-79 ASB	AS SHOWN

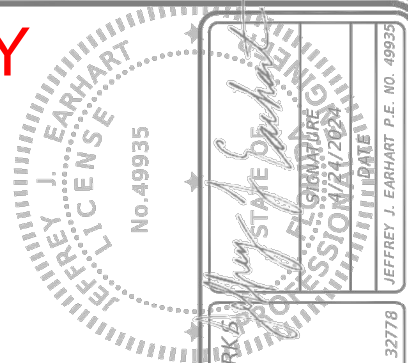

REVISION:	DATE
S. -24	
T. -245	
R. -26E	
SURVEYED: CM	DATE: 10/14/20
FIELD BOOK: 229	PAGE: 45-46, 51
DESIGNED: OEN	DATE: 4/24/2024
DRAWN: OEN	DATE: 4/24/2024
APPROVED: JE	DATE: 4/24/2024

SAWGRASS BAY BLVD MULTILANE ROUNDABOUT STREET 'B' TYPICAL	JOB NO.: 20032CA SHEET: 13
---	-------------------------------------

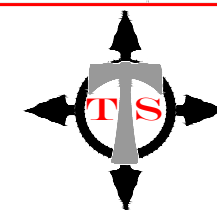

Florida Licensed Business No. LB8449
115 Morningstar Drive
Punta Gorda, FL 33950
(941)-740-0733

DATE	JOB#	DWG	SCALE
06/19/2025	24-79	24-79 ASB	AS SHOWN

JEFFREY J. EARHART
LITIGANT
No. 49935

 LAKE COUNTY, FL	DEPARTMENT OF PUBLIC WORKS	
	ENGINEERING DIVISION	
	STAFF NAME	J. Earhart
	SIGNATURE	[Signature]
	DATE	12/4/2024
	UPDATE	
	JEFFREY J. EARHART P.E. NO. 49935	


S. - 24	T. - 24S	R. - 26E	REVISION:	DATE
SURVEYED: CM	DATE: 10/14/20			
FIELD BOOK: 229	PAGE: 45-46, 51			
DESIGNED: 0EN	DATE: 4/24/2024			
DRAWN: 0EN	DATE: 4/24/2024			
APPROVED: JE	DATE: 4/24/2024			

SAWGRASS BAY BLVD
MULTILANE ROUNDABOUT
SAWGRASS PLAN & PROFILE (1)

JOB NO.:
20032CA

SHEET:
14

 ASPHALT PAVEMENT
 4" CONCRETE

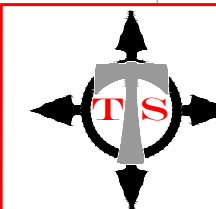

Florida Licensed Business No. LB8449
115 Morningstar Drive
Punta Gorda, FL 33950
(941)-740-0733

DATE	JOB#	DWG	SCALE
06/19/2025	24-79	24-79 ASB	AS SHOWN

SHEET: 15

SURVEYED: CM	DATE: 10/14/20
FIELD BOOK: 229	PAGE: 45-46, 51
DESIGNED: OEN	DATE: 4/24/2024
DRAWN: OEN	DATE: 4/24/2024
APPROVED: JE	DATE: 4/24/2024

[illegible]


LAKE
COUNTY, FL
R AVE., TAVARES, FL

350 N. SINCLAIR AVE., LA VARES, FLORIDA 32118

JEFFREY J. EAKHANI P.E. NO. 49933


O:\2020\20032_SAWGRASS_BAY_BVLD_ROUNDABOUT_TOPO\Engineering\Drawings\Plans\20032CA_SAWGRASS_ROUNDABOUT_6.dwg PLOTTED BY: Nunez, Osvaldo 4/24/2024 8:46 AM

FOR REVIEW ONLY

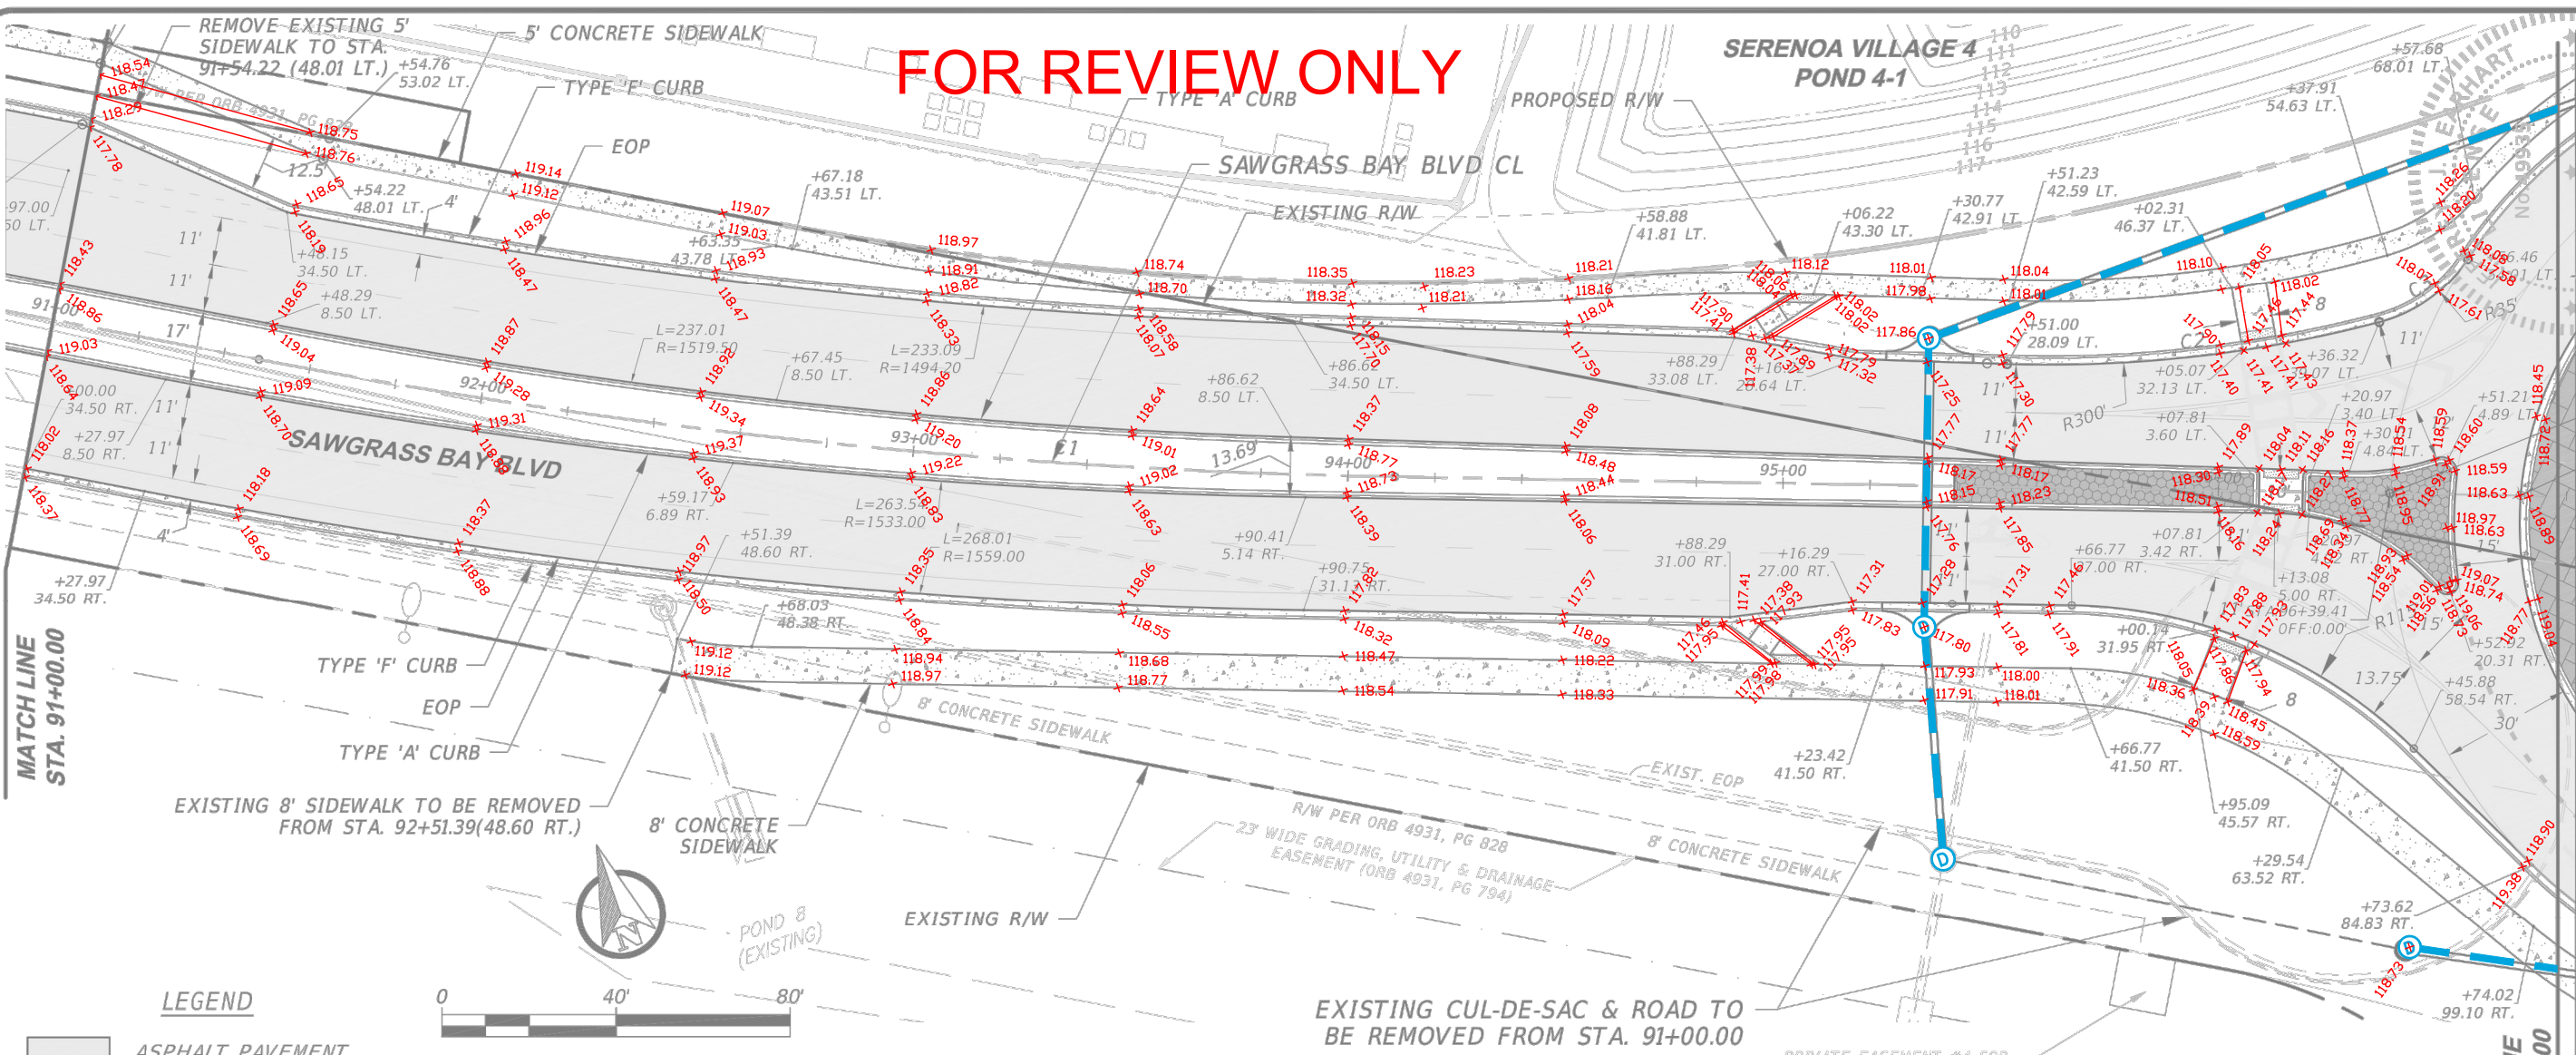

LEGEND

- ASPHALT PAVEMENT
- 4" CONCRETE


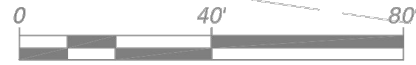


PVI STA: 92+50.00
PVI ELEV: 119.10
K: 133.61
LVC: 120.00

HIGH PT. STA: 92+43.44
HIGH PT ELEV: 118.97

PVI STA: 95+50.00
PVI ELEV: 117.61
K: 66.75
LVC: 100.00

LOW PT. STA: 95+33.25
LOW PT ELEV: 117.77

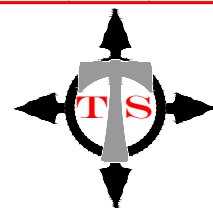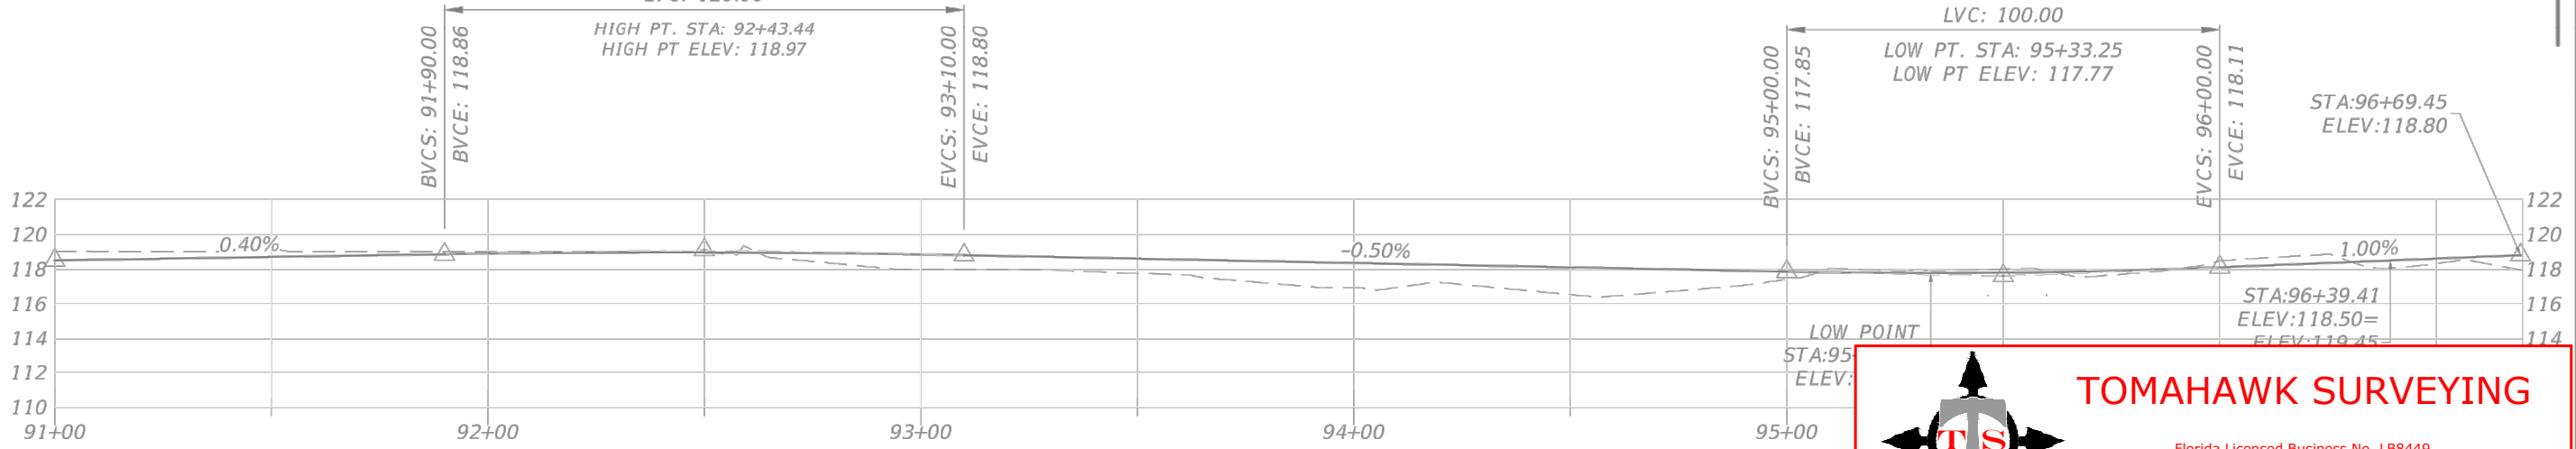

TOMAHAWK SURVEYING

Florida Licensed Business No. LB8449
115 Morningstar Drive
Punta Gorda, FL 33950
(941)-740-0733

DATE	JOB#	DWG	SCALE
06/19/2025	24-79	24-79 ASB	AS SHOWN

DEPARTMENT OF PUBLIC WORKS
ENGINEERING DIVISION

LAKE COUNTY, FL

JEFFREY J. EARHART P.E. NO. 49935
350 N. SINCLAIR AVE., TAVARES, FLORIDA 32778

PROFESSIONAL SEAL
DATE: 4/24/2024
SIGNATURE: [Signature]

DATE: 4/24/2024


S.	T.	R.	REVISION:	DATE
-24	-245	-26E		
SURVEYED:	CM	DATE:	10/14/20	
FIELD BOOK:	229	PAGE:	45-46, 51	
DESIGNED:	OEN	DATE:	4/24/2024	
DRAWN:	OEN	DATE:	4/24/2024	
APPROVED:	JE	DATE:	4/24/2024	

SAWGRASS BAY BLVD
MULTILANE ROUNDABOUT
SAWGRASS PLAN & PROFILE (3)

JOB NO.:
20032CA

SHEET:
16

80 J. EARHART
LICENSE
No. 49935

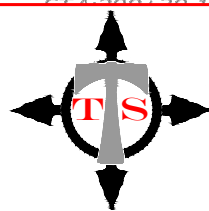

Florida Licensed Business No. LB8449
115 Morningstar Drive
Punta Gorda, FL 33950
(941)-740-0733

DATE	JOB#	DWG	SCALE
06/19/2025	24-79	24-79 ASB	AS SHOWN

DEPARTMENT OF PUBLIC WORKS ENGINEERING DIVISION		LAKE COUNTY FL 		32778 350 N. SINCLAIR AVE., TAVARES, FLORIDA	
<i>Jeffrey J. Earhart</i>		SIGNATURE		DATE	
		EXPIRATION DATE		JEFFREY J. EARTHART P.E. NO. 49935	


S. - 24	T. - 24S	R. - 26E	REVISION:	DATE
SURVEYED: CM	DATE: 10/14/20			
FIELD BOOK: 229	PAGE: 45-46, 51			
DESIGNED: 0EN	DATE: 4/24/2024			
DRAWN: 0EN	DATE: 4/24/2024			
APPROVED: JE	DATE: 4/24/2024			

SAWGRASS BAY BLVD
MULTILANE ROUNDABOUT
RA FLEMINGS PLAN & PROFILE

JOB NO.: 20032CA
SHEET: 17

O:\2020\20032_SAWGRASS_BAY_BLVD_ROUNDABOUT_TOPO\Engineering\Drawings\Plans\20032CA_SAWGRASS_ROUNDABOUT_6.dwg PLOTTED BY: Nunez, Osvaldo 4/24/2024 8:48 AM

FOR REVIEW ONLY

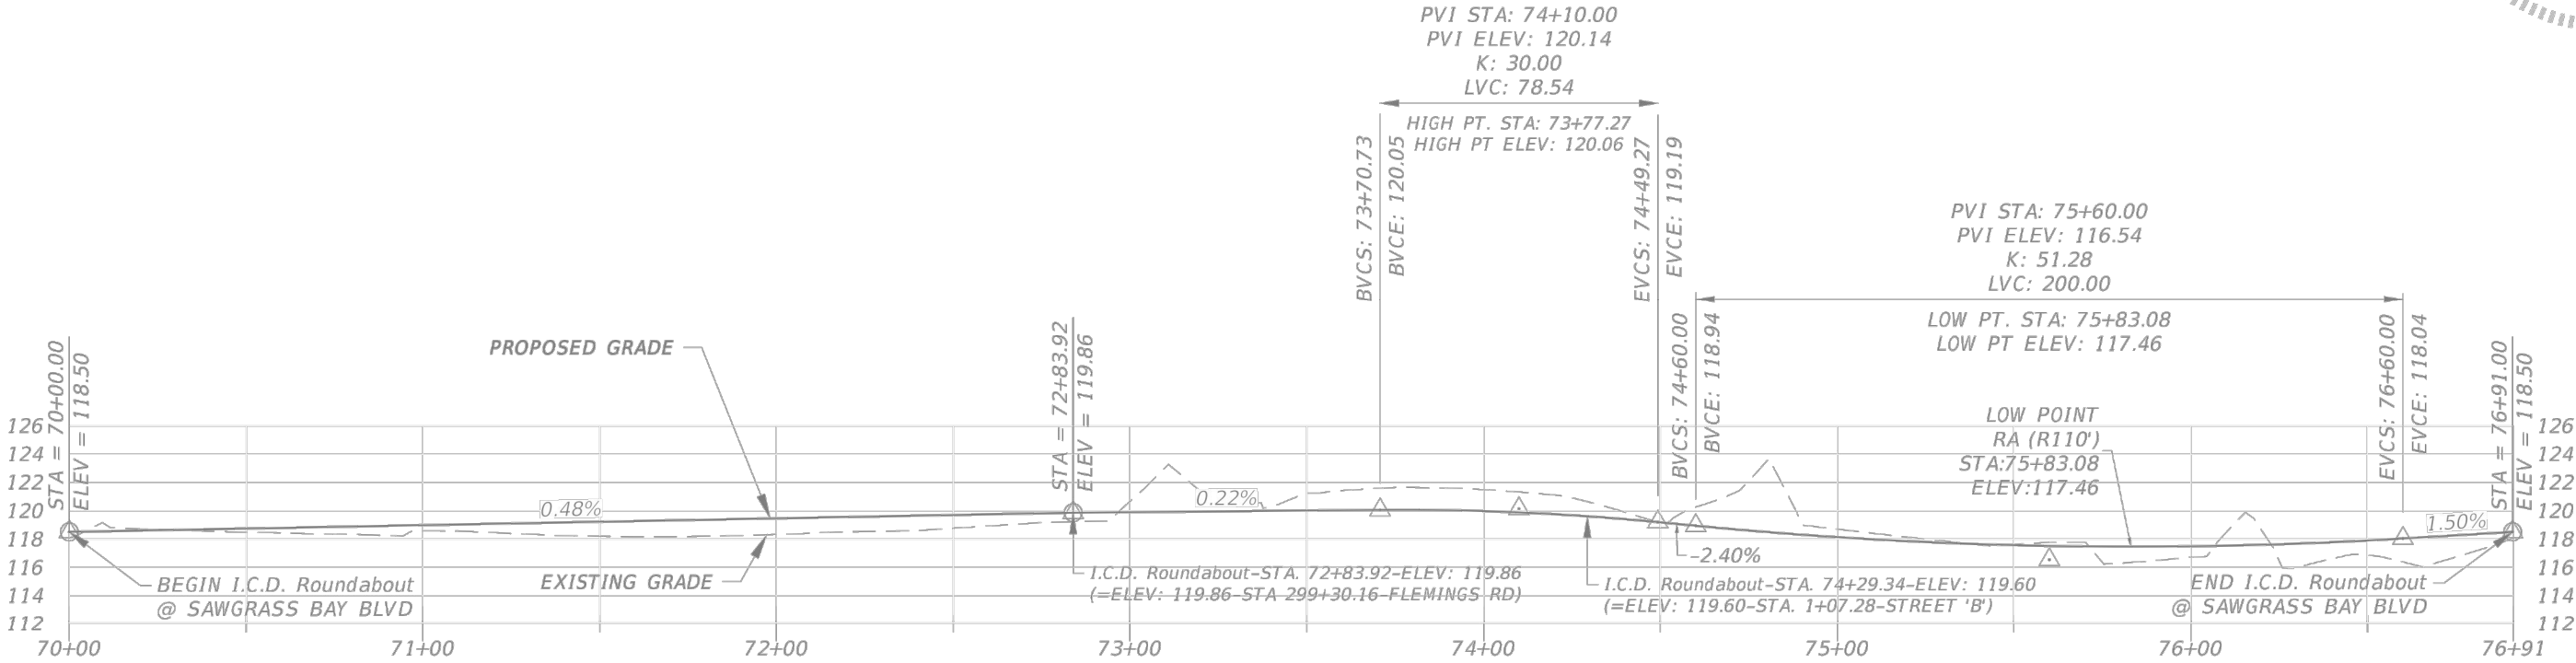

I.C.D. ROUNDABOUT PROFILE



TOMAHAWK SURVEYING
Florida Licensed Business No. LB8449
115 Morningstar Drive
Punta Gorda, FL 33950
(941)-740-0733

DATE 06/19/2025	JOB# 24-79	DWG 24-79 ASB	SCALE AS SHOWN
--------------------	---------------	------------------	-------------------











JEFFREY J. EARTHART
No. 49935
DATE: 4/24/2024
SIGNATURE: [Signature]

DEPARTMENT OF PUBLIC WORKS
ENGINEERING DIVISION
LAKE COUNTY, FL
350 N. SINCLAIR AVE., TAVARES, FLORIDA 32778
JEFFREY J. EARTHART P.E. NO. 49935

SAWGRASS BAY BLVD MULTILANE ROUNDABOUT I.C.D. ROUNDABOUT PROFILE	REVISION:		DATE
	S. -24	T. -24S	R. -26E
	SURVEYED: CM	DATE: 10/14/20	
	FIELD BOOK: 229	PAGE: 45-46, 51	
	DESIGNED: OEN	DATE: 4/24/2024	
	DRAWN: OEN	DATE: 4/24/2024	
	APPROVED: JE	DATE: 4/24/2024	
JOB NO.: 20032CA			
SHEET: 18			

0:\2020\20032_SAWGRASS_BAY_BVLD_ROUNDABOUT_TOPO\Engineering\Drawings\Plans\20032CA_SAWGRASS_ROUNDABOUT_6.dwg PLOTTED BY: Nunez, Osvaldo 4/24/2024 8:52 AM

FOR REVIEW ONLY

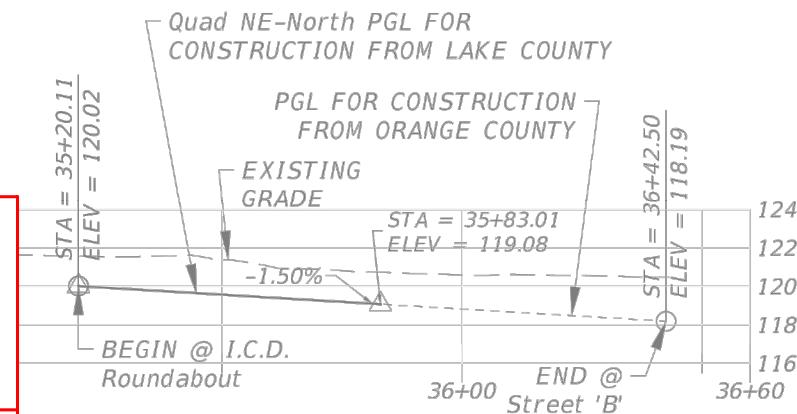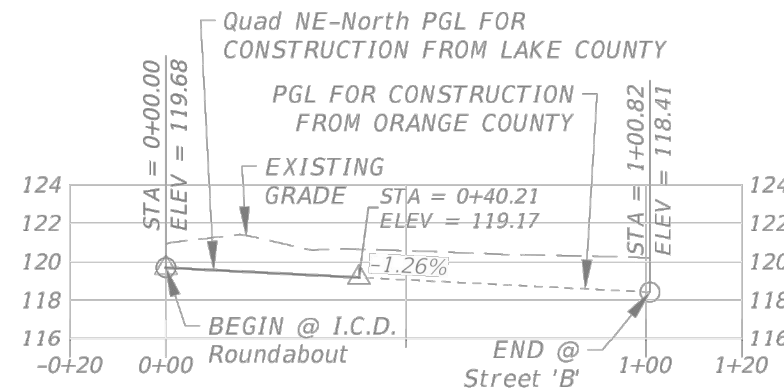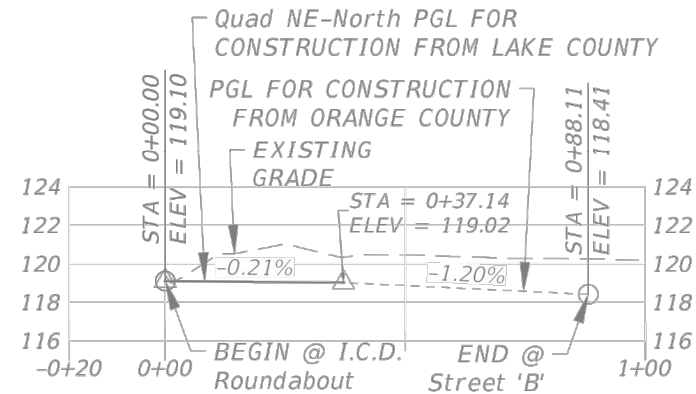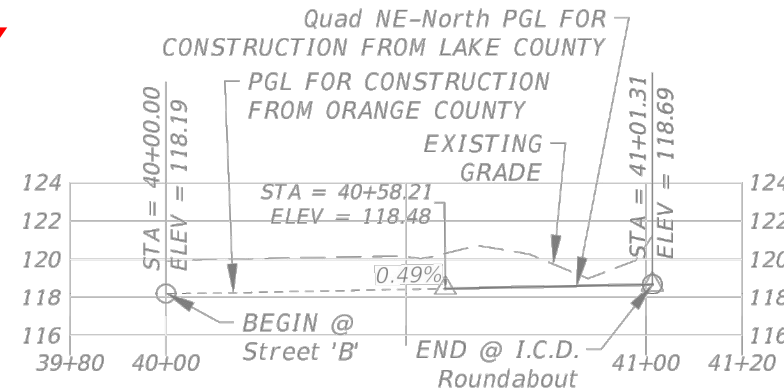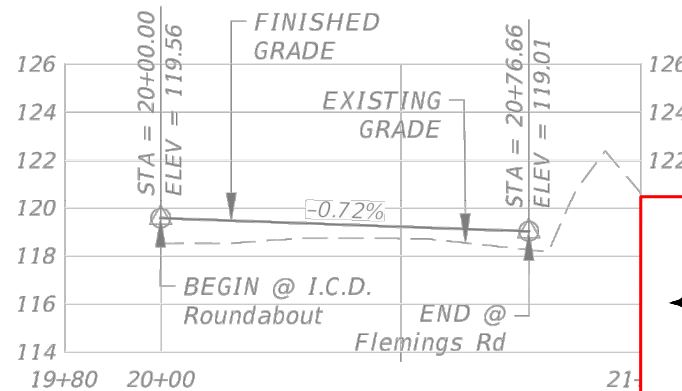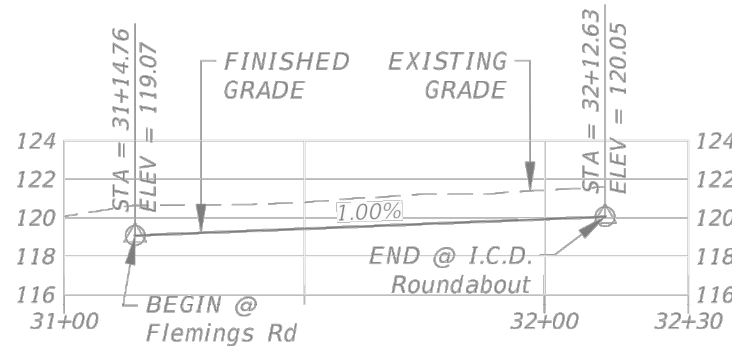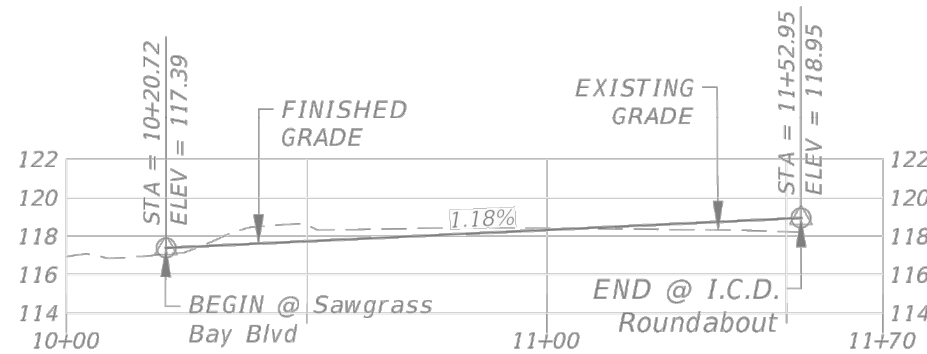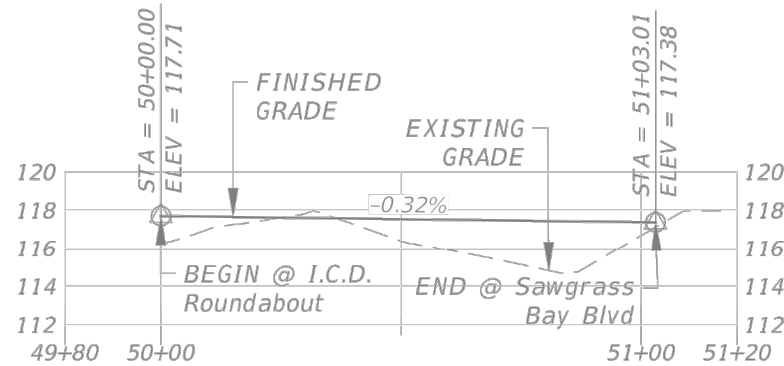

PROFILE SCALE

HORIZ. SCALE 1"=40'
VERT. SCALE 1"=10'



TOMAHAWK SURVEYING

Florida Licensed Business No. LB8449
115 Morningstar Drive
Punta Gorda, FL 33950
(941)-740-0733

DATE	JOB#	DWG	SCALE
06/19/2025	24-79	24-79 ASB	AS SHOWN



REVISION:	DATE
S. -24	
T. -24S	
R. -26E	
SURVEYED: CM	DATE: 10/14/20
FIELD BOOK: 229	PAGE: 45-46, 51
DESIGNED: OEN	DATE: 4/24/2024
DRAWN: OEN	DATE: 4/24/2024
APPROVED: JE	DATE: 4/24/2024



SAWGRASS BAY BLVD
MULTILANE ROUNDABOUT
QUADRANT PROFILES

JOB NO.:
20032CA

SHEET:
19

0:\2020\20032_SAWGRASS_BAY_BLD_ROUNDABOUT_TOPO\Engineering\Drawings\Plans\20032CA_SAWGRASS_ROUNDABOUT_6.dwg PLOTTED BY: Nunez, Osvaldo 4/24/2024 8:52 AM

FOR REVIEW ONLY

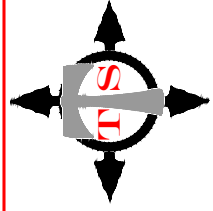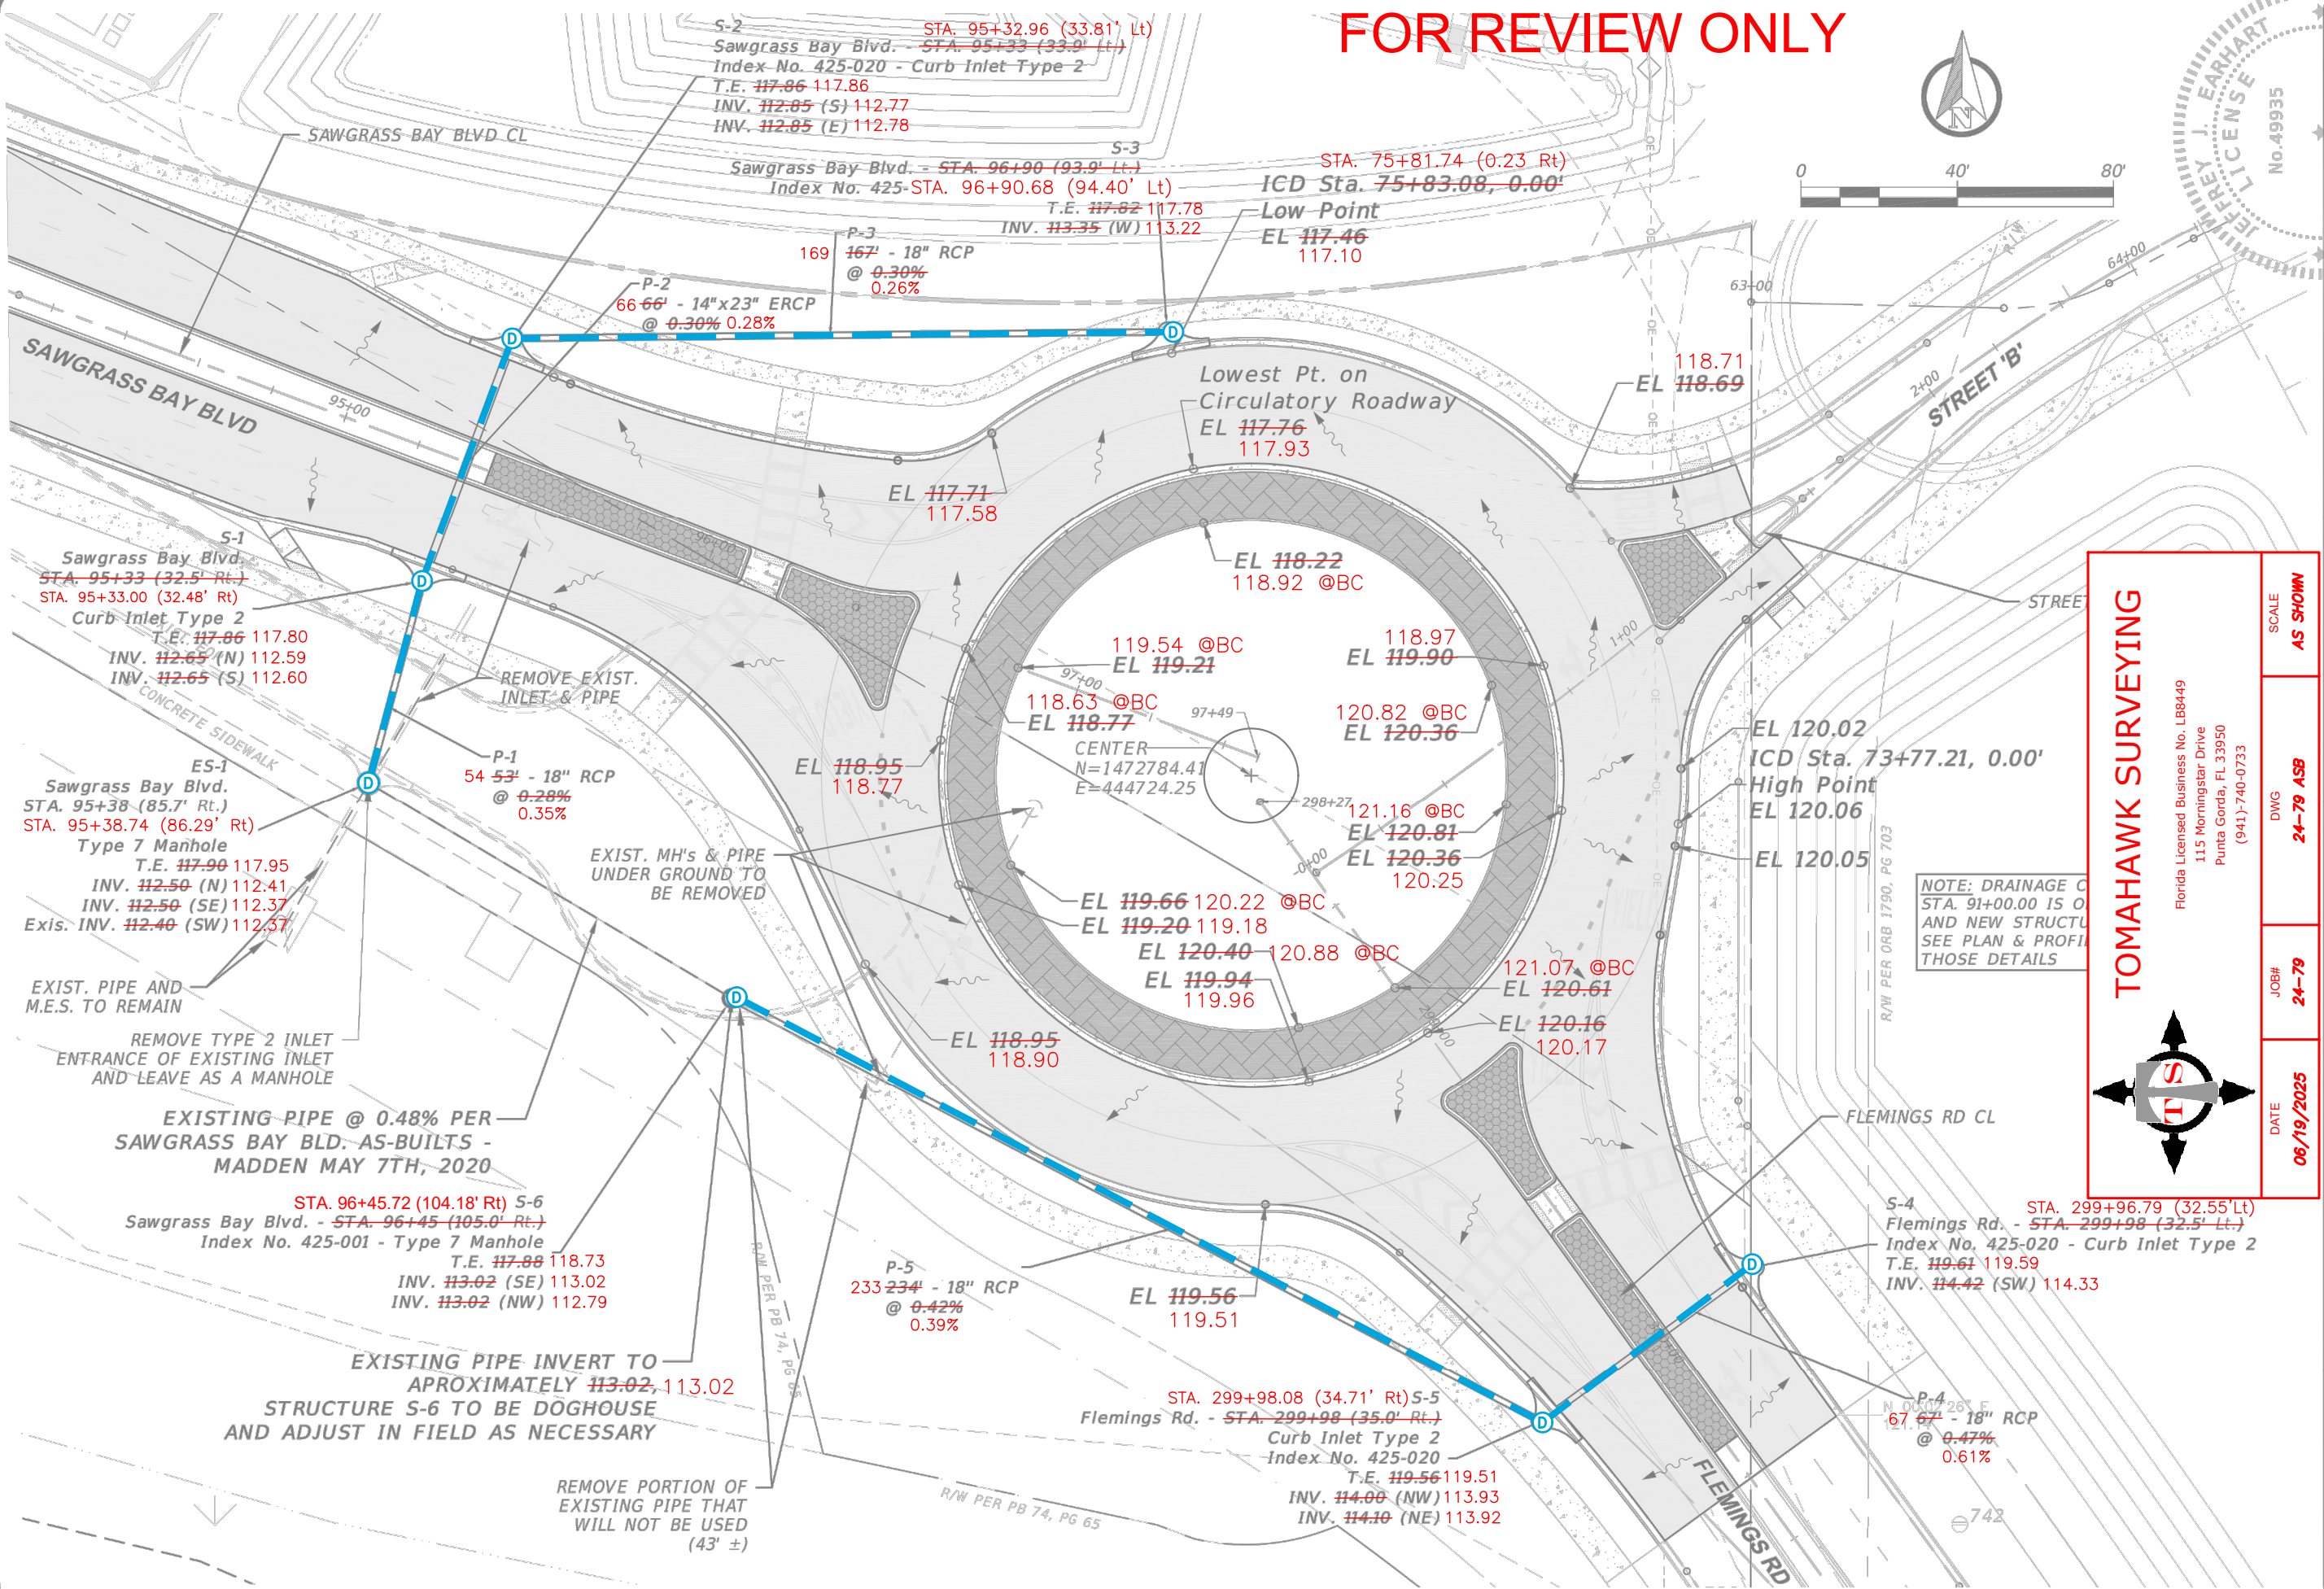

TOMAHAWK SURVEYING

Florida Licensed Business No. LB8449
115 Morningstar Drive
Punta Gorda, FL 33950
(941) 740-0733

JEFFREY J. EARHART
No. 49935
DATE: 4/24/2024







SAWGRASS BAY BLVD MULTILANE ROUNDABOUT DRAINAGE & GRADING DETAIL		JOB NO.: 20032CA		SHEET: 20	
S. -24	T. -245	R. -26E	DATE: 10/14/20	REVISION:	DATE
SURVEYED: CM	FIELD BOOK: 229	PAGE: 45-46, 51	DATE: 10/14/20		
DESIGNED: OEN	OEN	DATE: 4/24/2024	DATE: 4/24/2024		
DRAWN: OEN	OEN	DATE: 4/24/2024	DATE: 4/24/2024		
APPROVED: JE	JE	DATE: 4/24/2024	DATE: 4/24/2024		

DEPARTMENT OF PUBLIC WORKS
ENGINEERING DIVISION

LAKE
COUNTY, FL


350 N. SINCLAIR AVE., TAVARES, FLORIDA 32778
JEFFREY J. EARHART P.E. NO. 49935

0:\2020\20032_SAWGRASS_BAY_BIVD_ROUNDABOUT_TOPO\Engineering\Drawings\Plans\20032CA_SAWGRASS_ROUNDABOUT_6.dwg PLOTTED BY: Nunez, Osvaldo 4/24/2024 8:53 AM

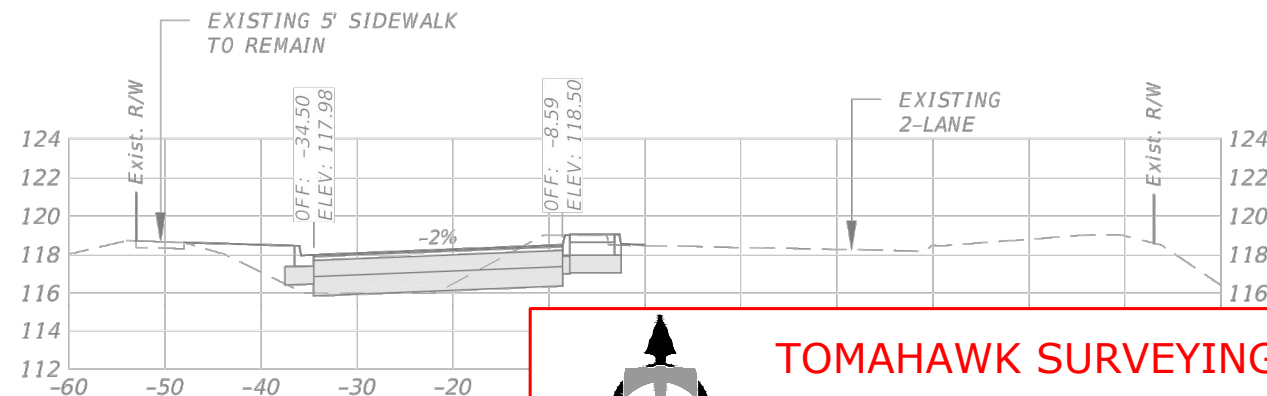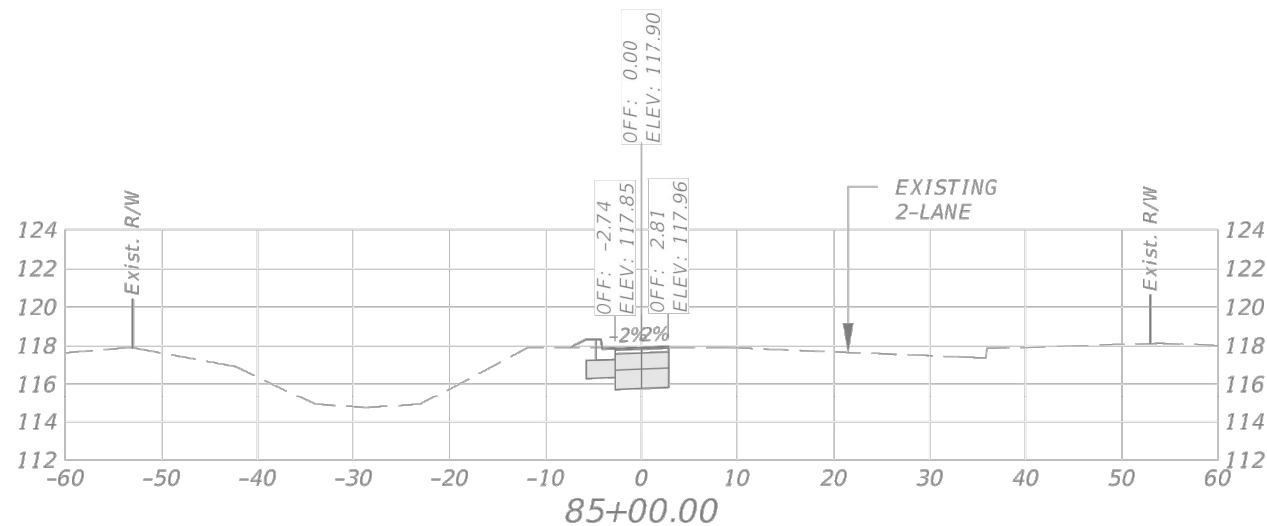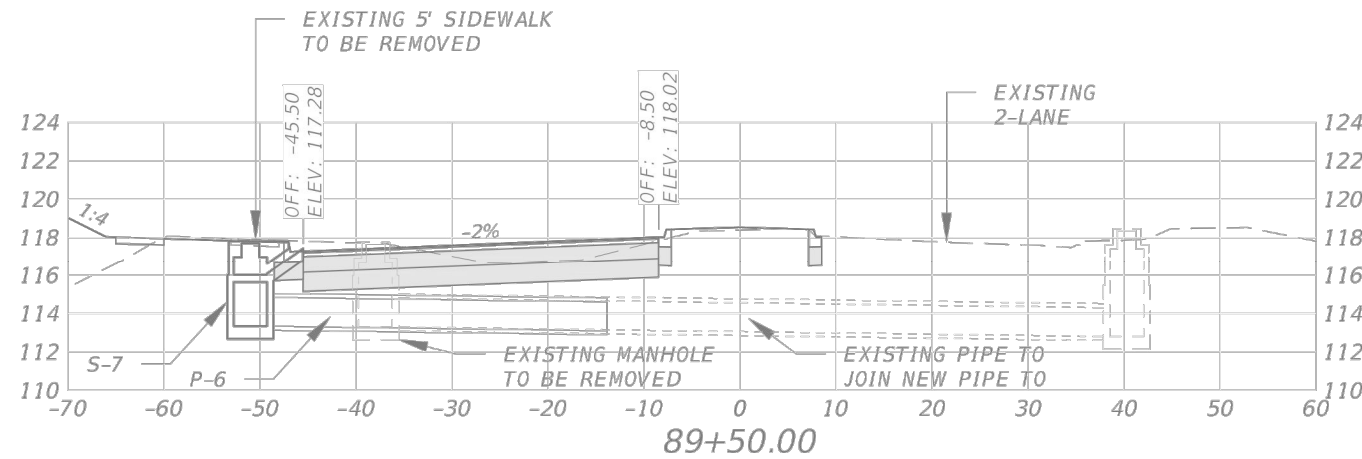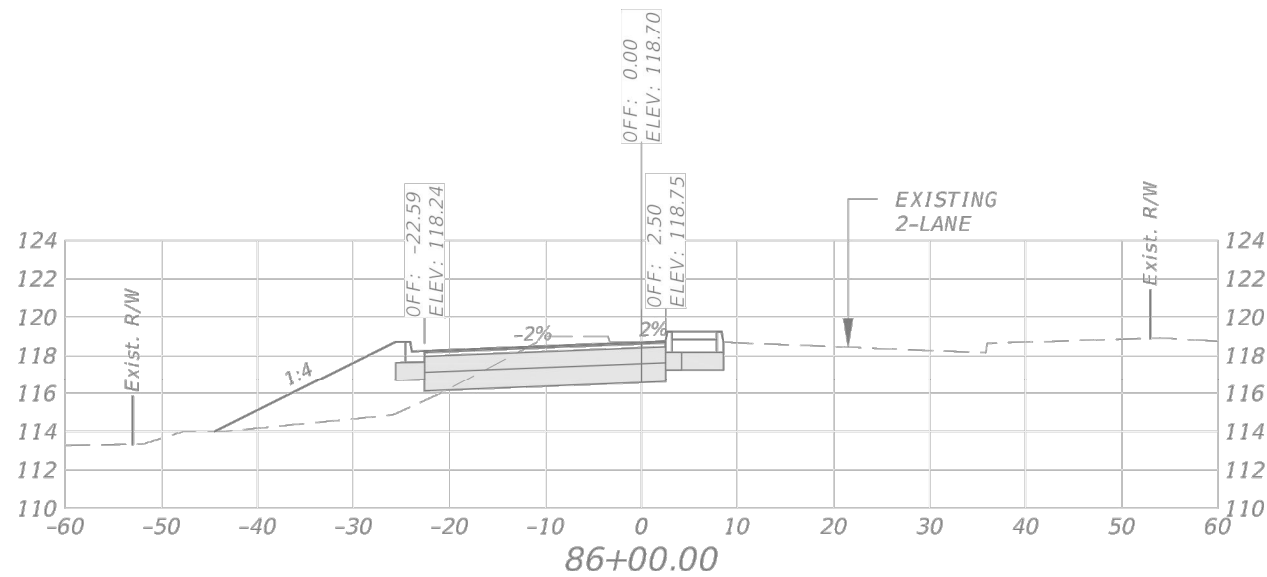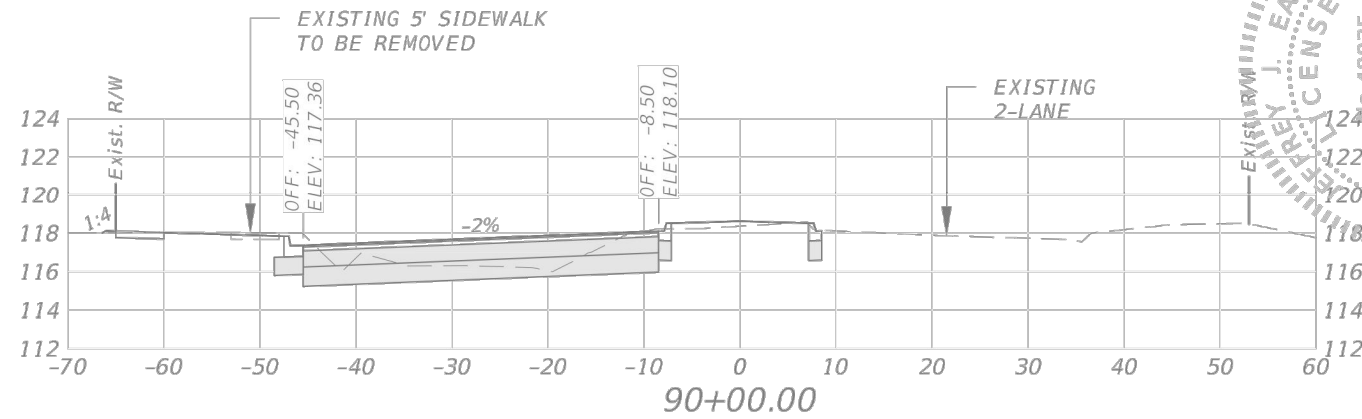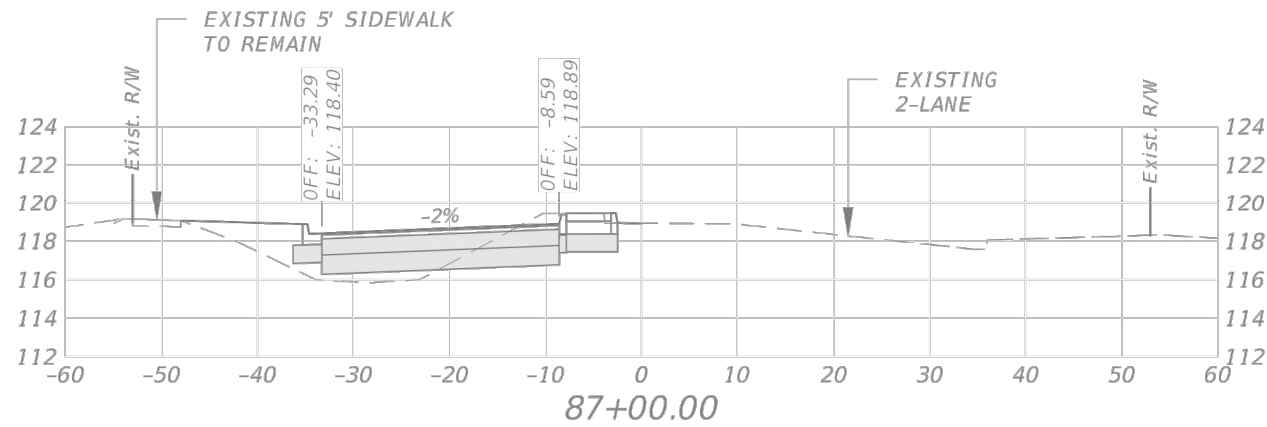

CROSS SECTION SCALE
HORIZ. SCALE 1"=20'
VERT. SCALE 1"=10'

FOR REVIEW ONLY

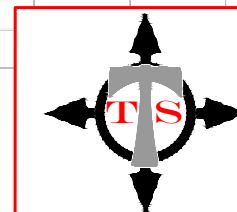

TOMAHAWK SURVEYING

Florida Licensed Business No. LB8449
115 Morningstar Drive
Punta Gorda, FL 33950
(941)-740-0733

DATE	JOB#	DWG	SCALE
06/19/2025	24-79	24-79 ASB	AS SHOWN

DEPARTMENT OF PUBLIC WORKS
ENGINEERING DIVISION

LAKE COUNTY, FL

350 N. SINCLAIR AVE., TAVARES, FLORIDA 32778

JEFFREY J. EARHART P.E. NO. 49935


FLORIDA PROFESSIONAL ENGINEERING EXAMINATION DATE: 4/24/2024

JEFFREY J. EARHART No. 49935

DATE	REVISION:	R - 26E	T - 24S	S - 24	SURVEYED: CM	FIELD BOOK: 229	DESIGNED: OEN	DRAWN: OEN	APPROVED: JE	JOB NO.: 20032CA	SHEET: 21
10/14/20	DATE: 10/14/20	PAGE: 45-46, 51	DATE: 4/24/2024	DATE: 4/24/2024	DATE: 4/24/2024	DATE: 4/24/2024	DATE: 4/24/2024	DATE: 4/24/2024	DATE: 4/24/2024		



SAWGRASS BAY BLVD
MULTILANE ROUNDABOUT
SAWGRASS CROSS SECTIONS (1)

O:\2020\20032_SAWGRASS_BAY_BVLD_ROUNDABOUT_TOPO\Engineering\Drawings\Plans\20032CA_SAWGRASS_ROUNDABOUT_6.dwg PLOTTED BY: Nunez, Osvaldo 4/24/2024 8:54 AM

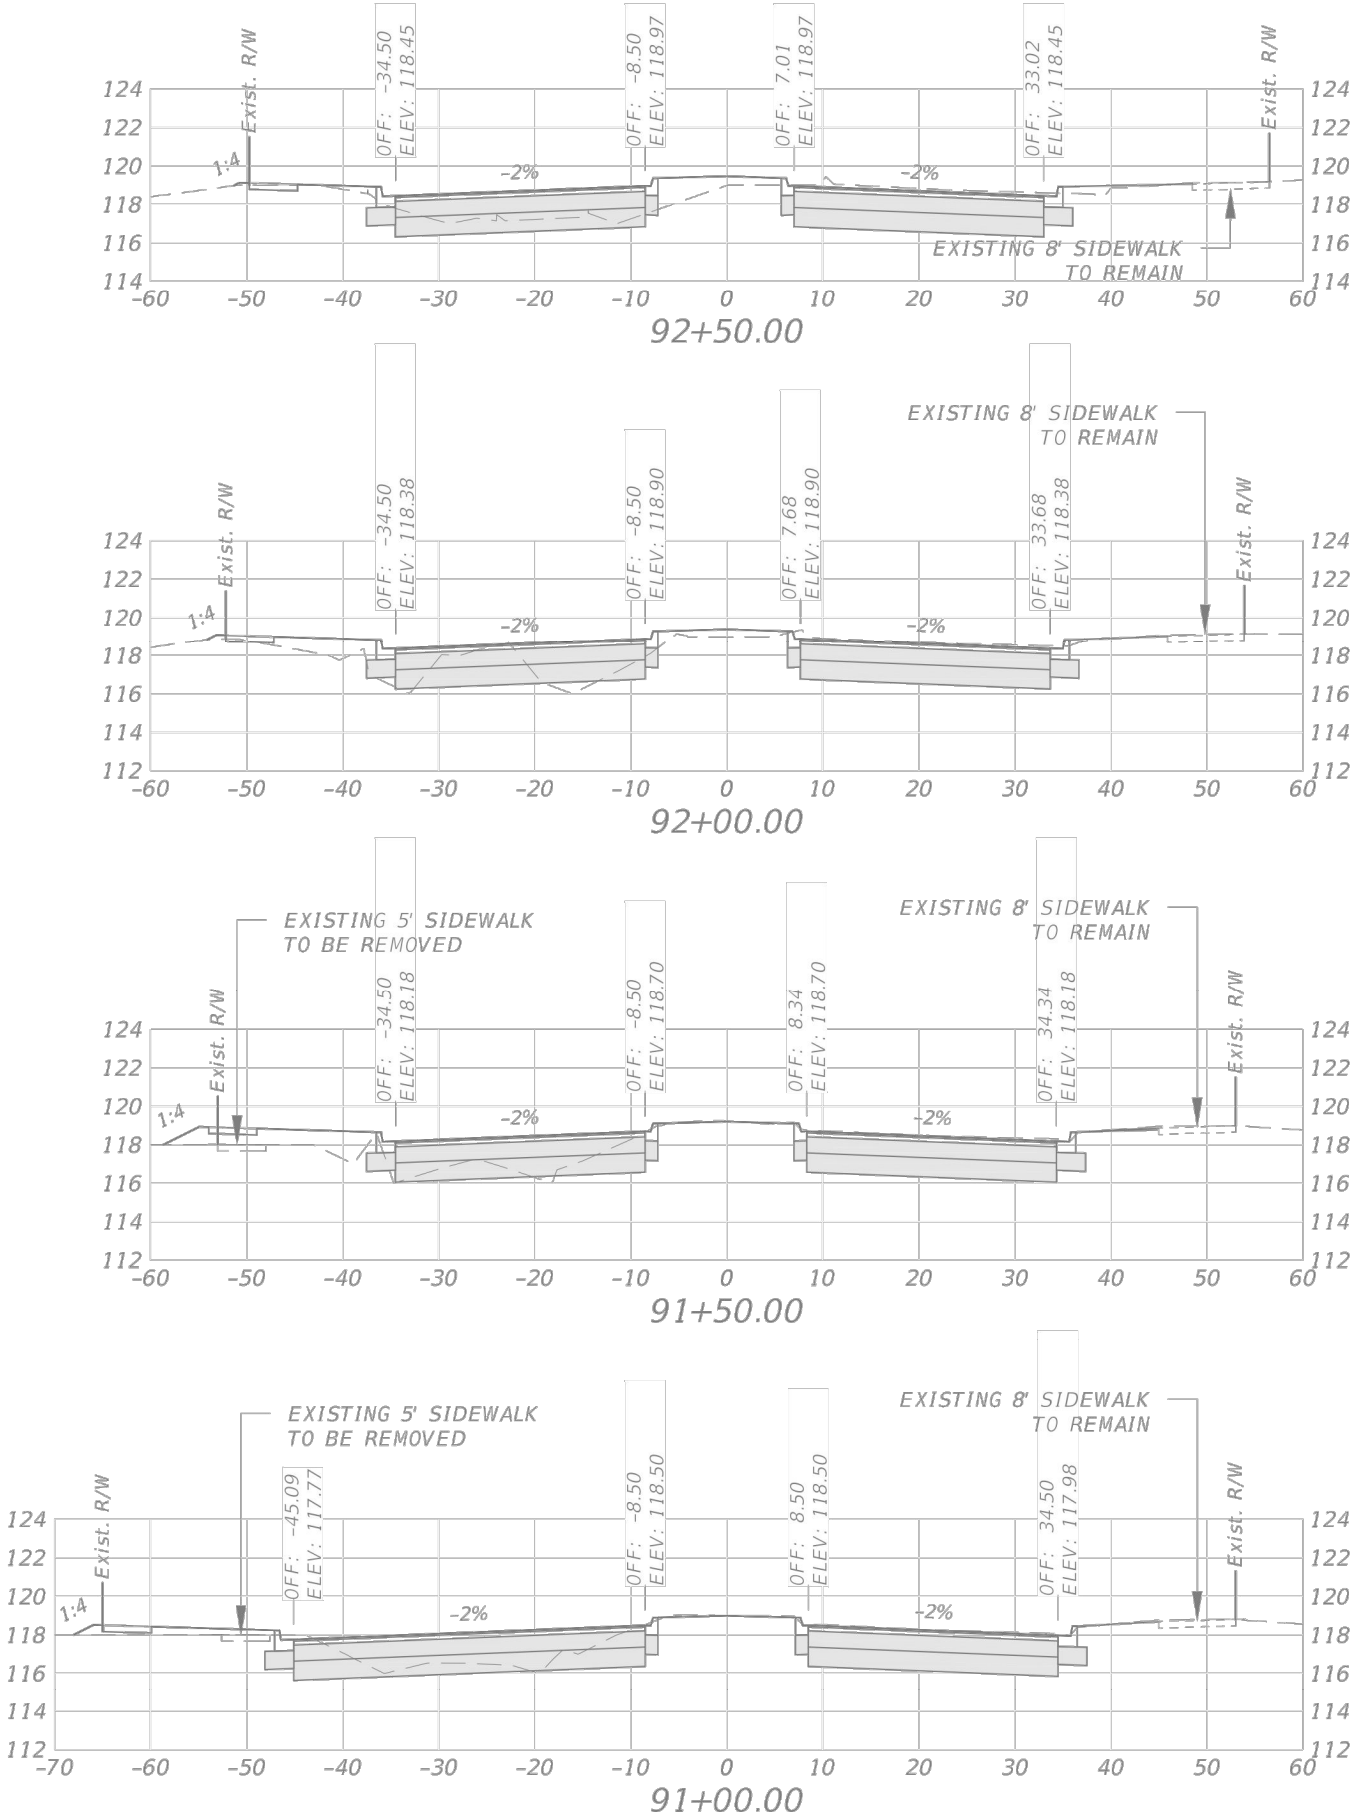

FOR REVIEW ONLY

CROSS SECTION SCALE
HORIZ. SCALE 1"=20'
VERT. SCALE 1"=10'

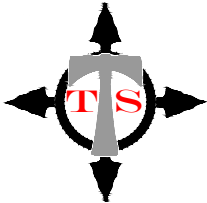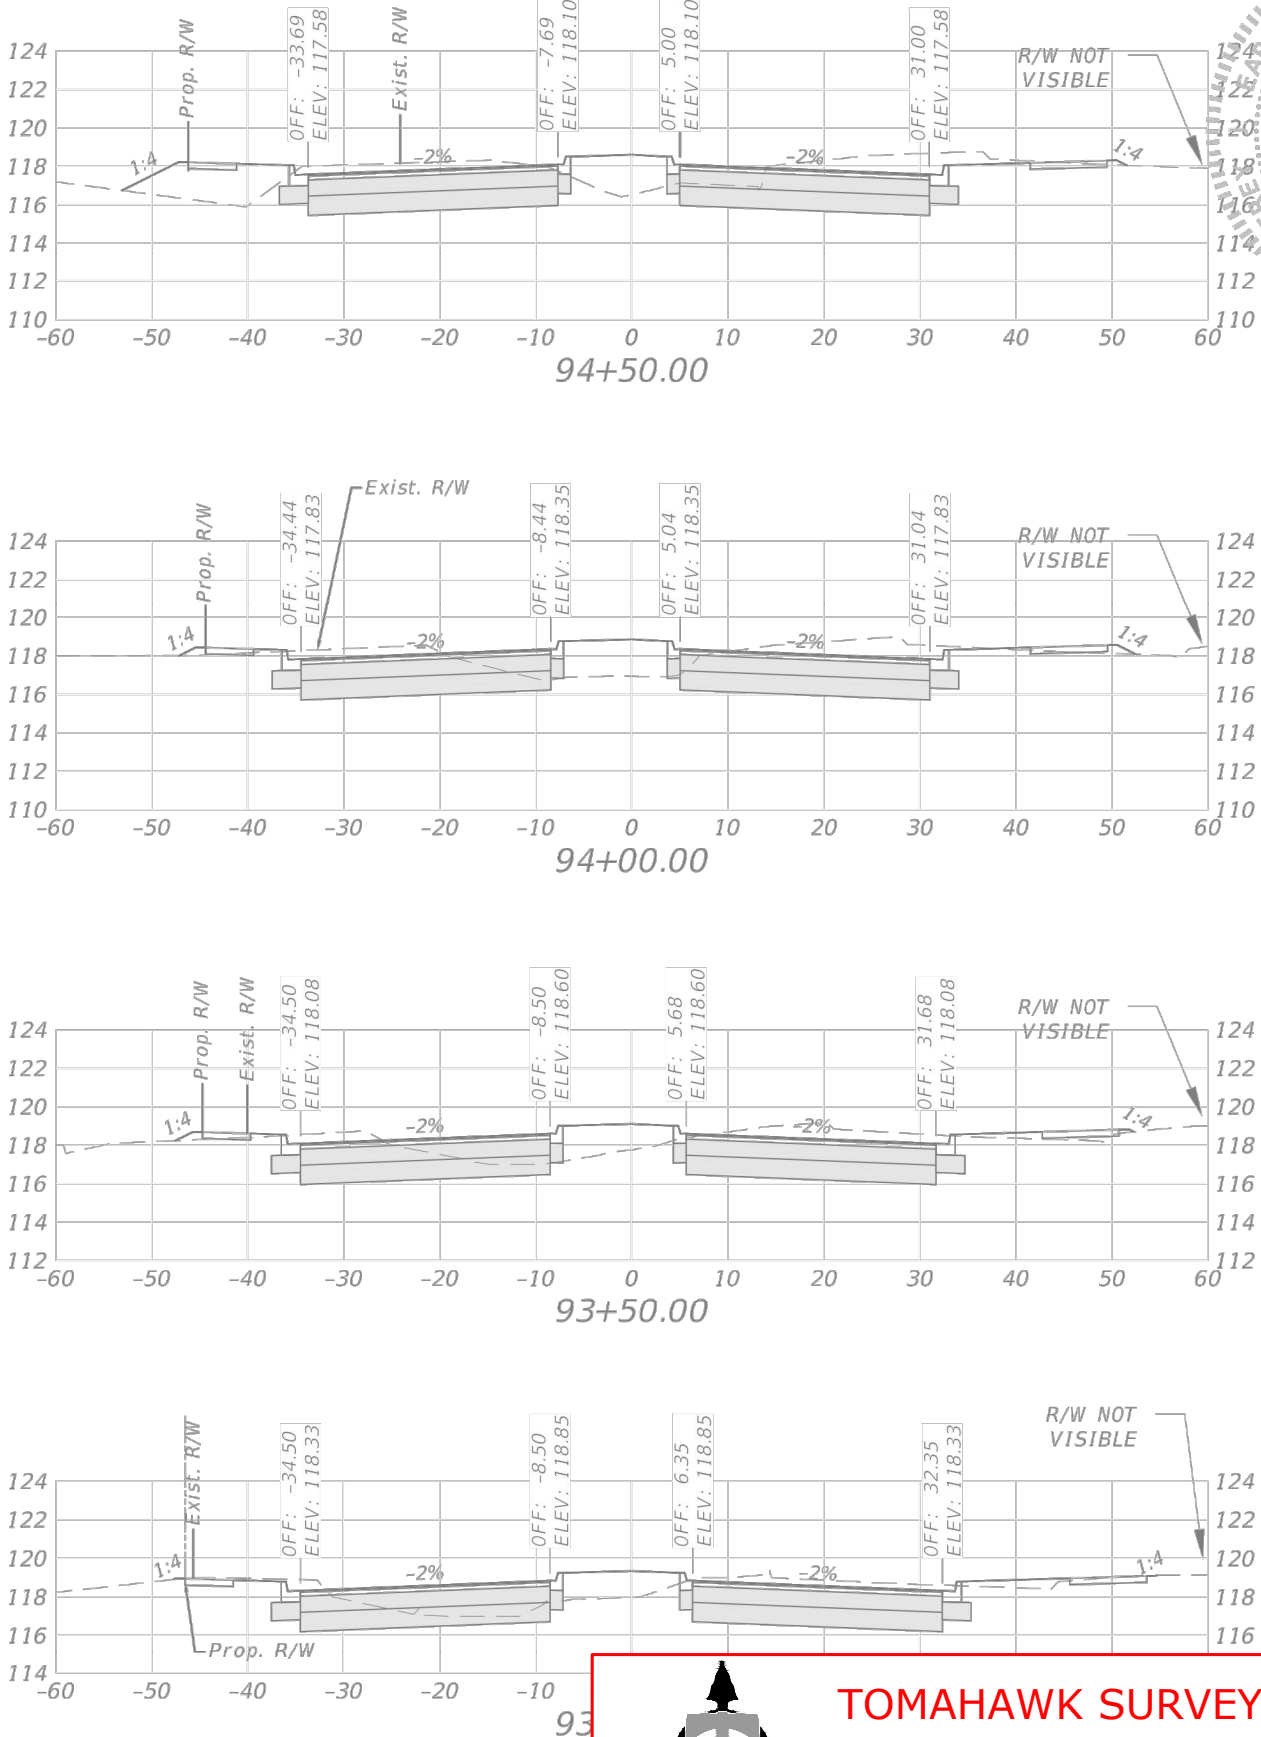

TOMAHAWK SURVEYING

Florida Licensed Business No. LB8449
115 Morningstar Drive
Punta Gorda, FL 33950
(941)-740-0733

DATE	JOB#	DWG	SCALE
06/19/2025	24-79	24-79 ASB	AS SHOWN

JEFFREY J. EARTHART
No. 49935

SAWGRASS BAY BLVD
MULTILANE ROUNDABOUT
SAWGRASS CROSS SECTIONS (2)

DATE: 10/14/20
PAGE: 45-46, 51
OEN: 4/24/2024
DATE: 4/24/2024

REVISION: T. -245 R. -26E






SURVEYED: CM
FIELD BOOK: 229
DESIGNED: OEN
DRAWN: OEN
APPROVED: JE

JOB NO.: 20032CA
SHEET: 22


DEPARTMENT OF PUBLIC WORKS
ENGINEERING DIVISION
LAKE COUNTY, FL
350 N. SINCLAIR AVE., TAVARES, FLORIDA 32778
JEFFREY J. EARTHART P.E. NO. 49935

O:\2020\20032_SAWGRASS_BAY_BIVD_ROUNDABOUT_TOPO\Engineering\Drawings\Plans\20032CA_SAWGRASS_ROUNDABOUT_6.dwg PLOTTED BY: Nunez, Osvaldo 4/24/2024 8:55 AM

FOR REVIEW ONLY

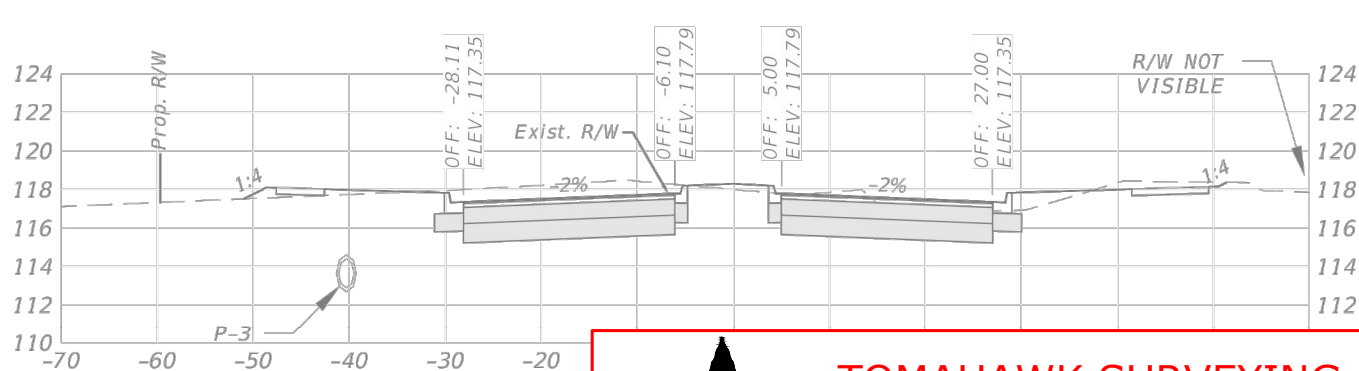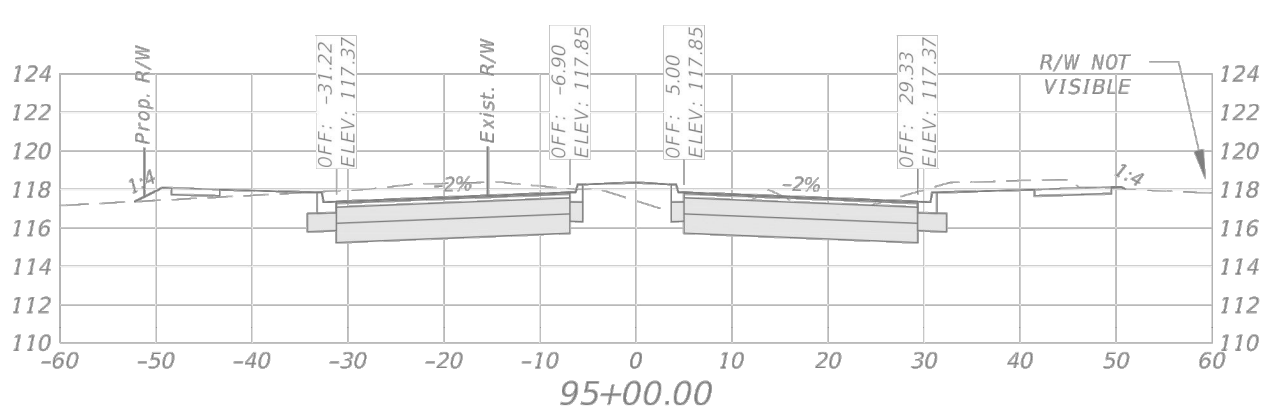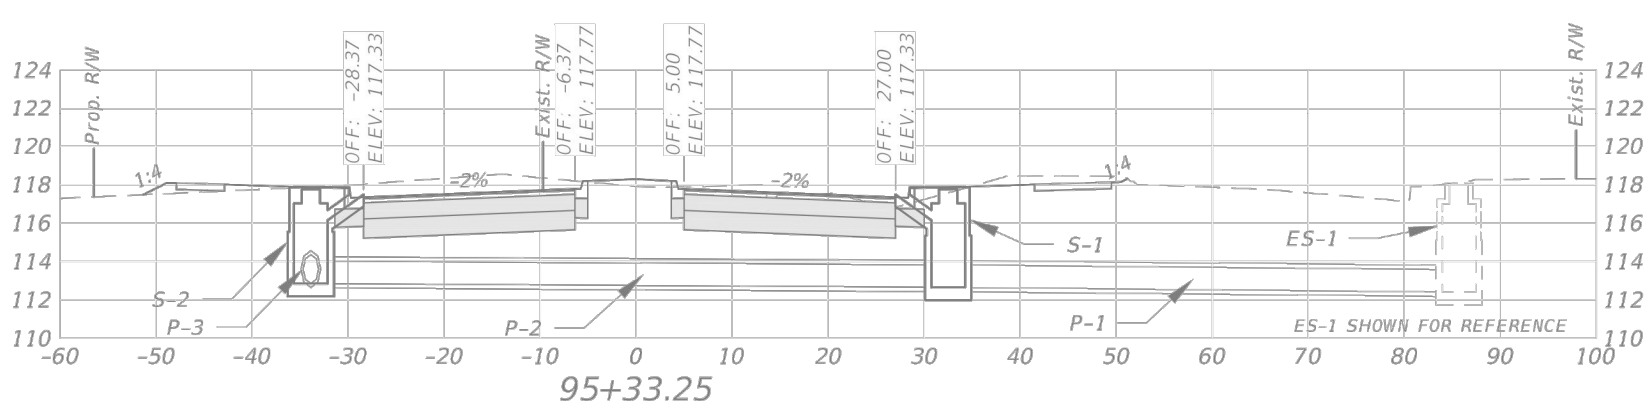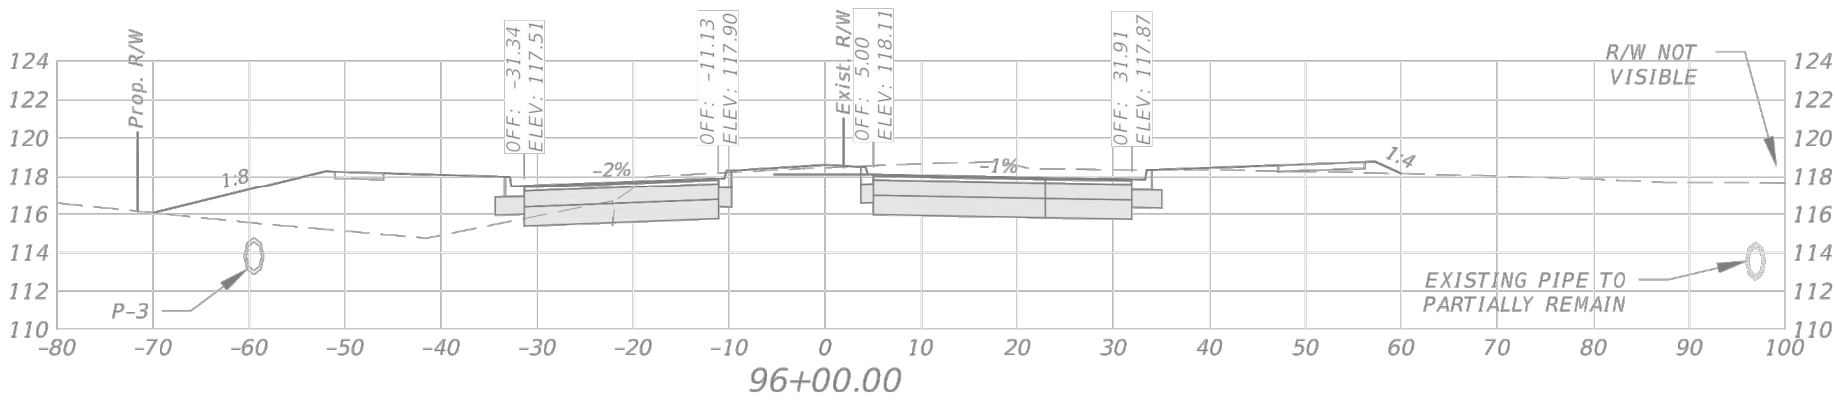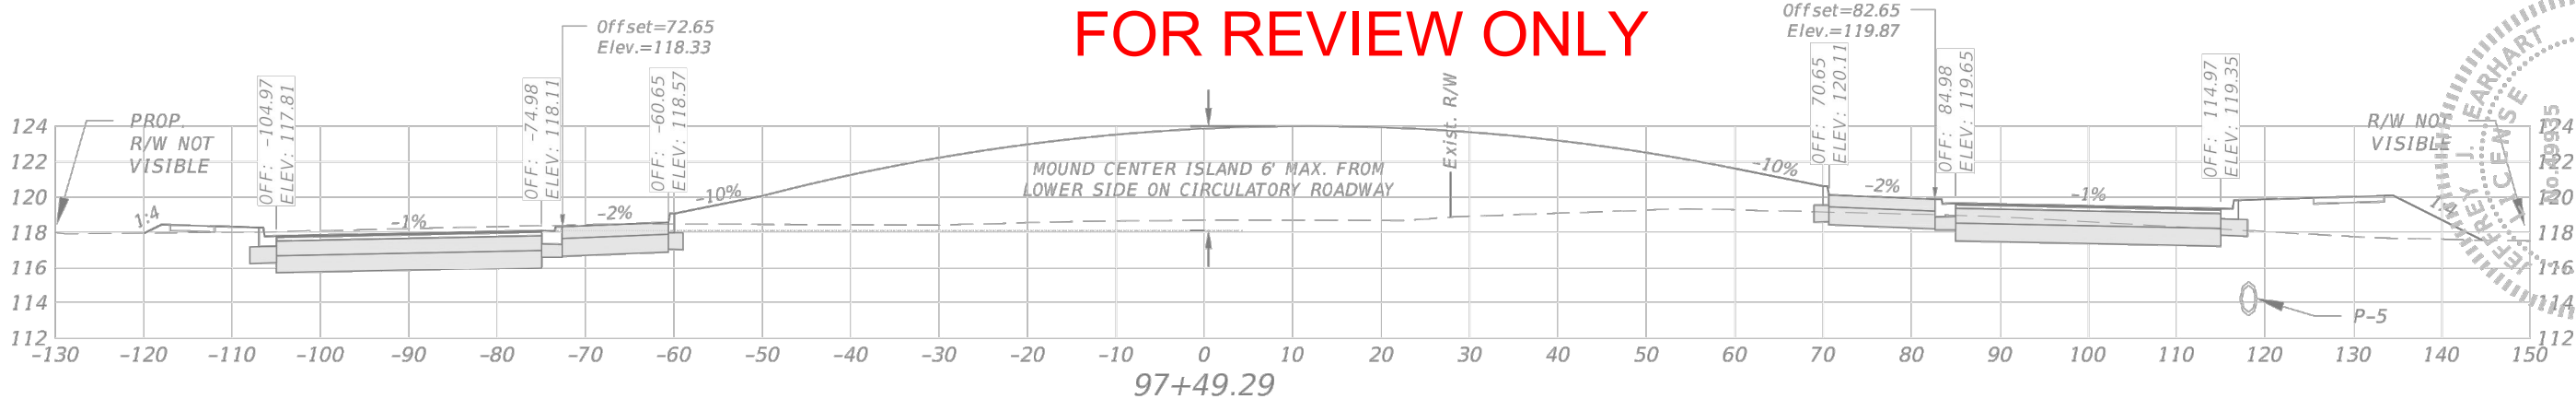

CROSS SECTION SCALE
HORIZ. SCALE 1"=20'
VERT. SCALE 1"=10'

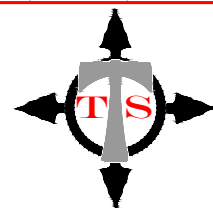

TOMAHAWK SURVEYING

Florida Licensed Business No. LB8449
115 Morningstar Drive
Punta Gorda, FL 33950
(941)-740-0733

DATE	JOB#	DWG	SCALE
06/19/2025	24-79	24-79 ASB	AS SHOWN

DEPARTMENT OF PUBLIC WORKS
ENGINEERING DIVISION

LAKE
COUNTY, FL

350 N. SINCLAIR AVE., TAVARES, FLORIDA 32778

JEFFREY J. EARHART
P.E. NO. 49935

DATE	REVISION:	S.	T.	R.	CM	DATE	CM	DATE	CM	DATE	CM
		-24	-245	-26E	CM	10/14/20	CM	45-46, 51	CM	4/24/2024	CM
					DESIGNED:	OEN	OEN	OEN	OEN	OEN	OEN
					DRAWN:	OEN	OEN	OEN	OEN	OEN	OEN
					APPROVED:	JE	JE	JE	JE	JE	JE


SAWGRASS BAY BLVD
MULTILANE ROUNDABOUT
SAWGRASS CROSS SECTIONS (3)

JOB NO.:
20032CA


SHEET:
23

O:\2020\20032_SAWGRASS_BAY_BVLD_ROUNDABOUT_TOPO\Engineering\Drawings\Plans\20032CA_SAWGRASS_ROUNDABOUT_6.dwg PLOTTED BY: Nunez, Osvaldo 4/24/2024 8:56 AM


FLEMINGS RD
CROSS SECTIONS

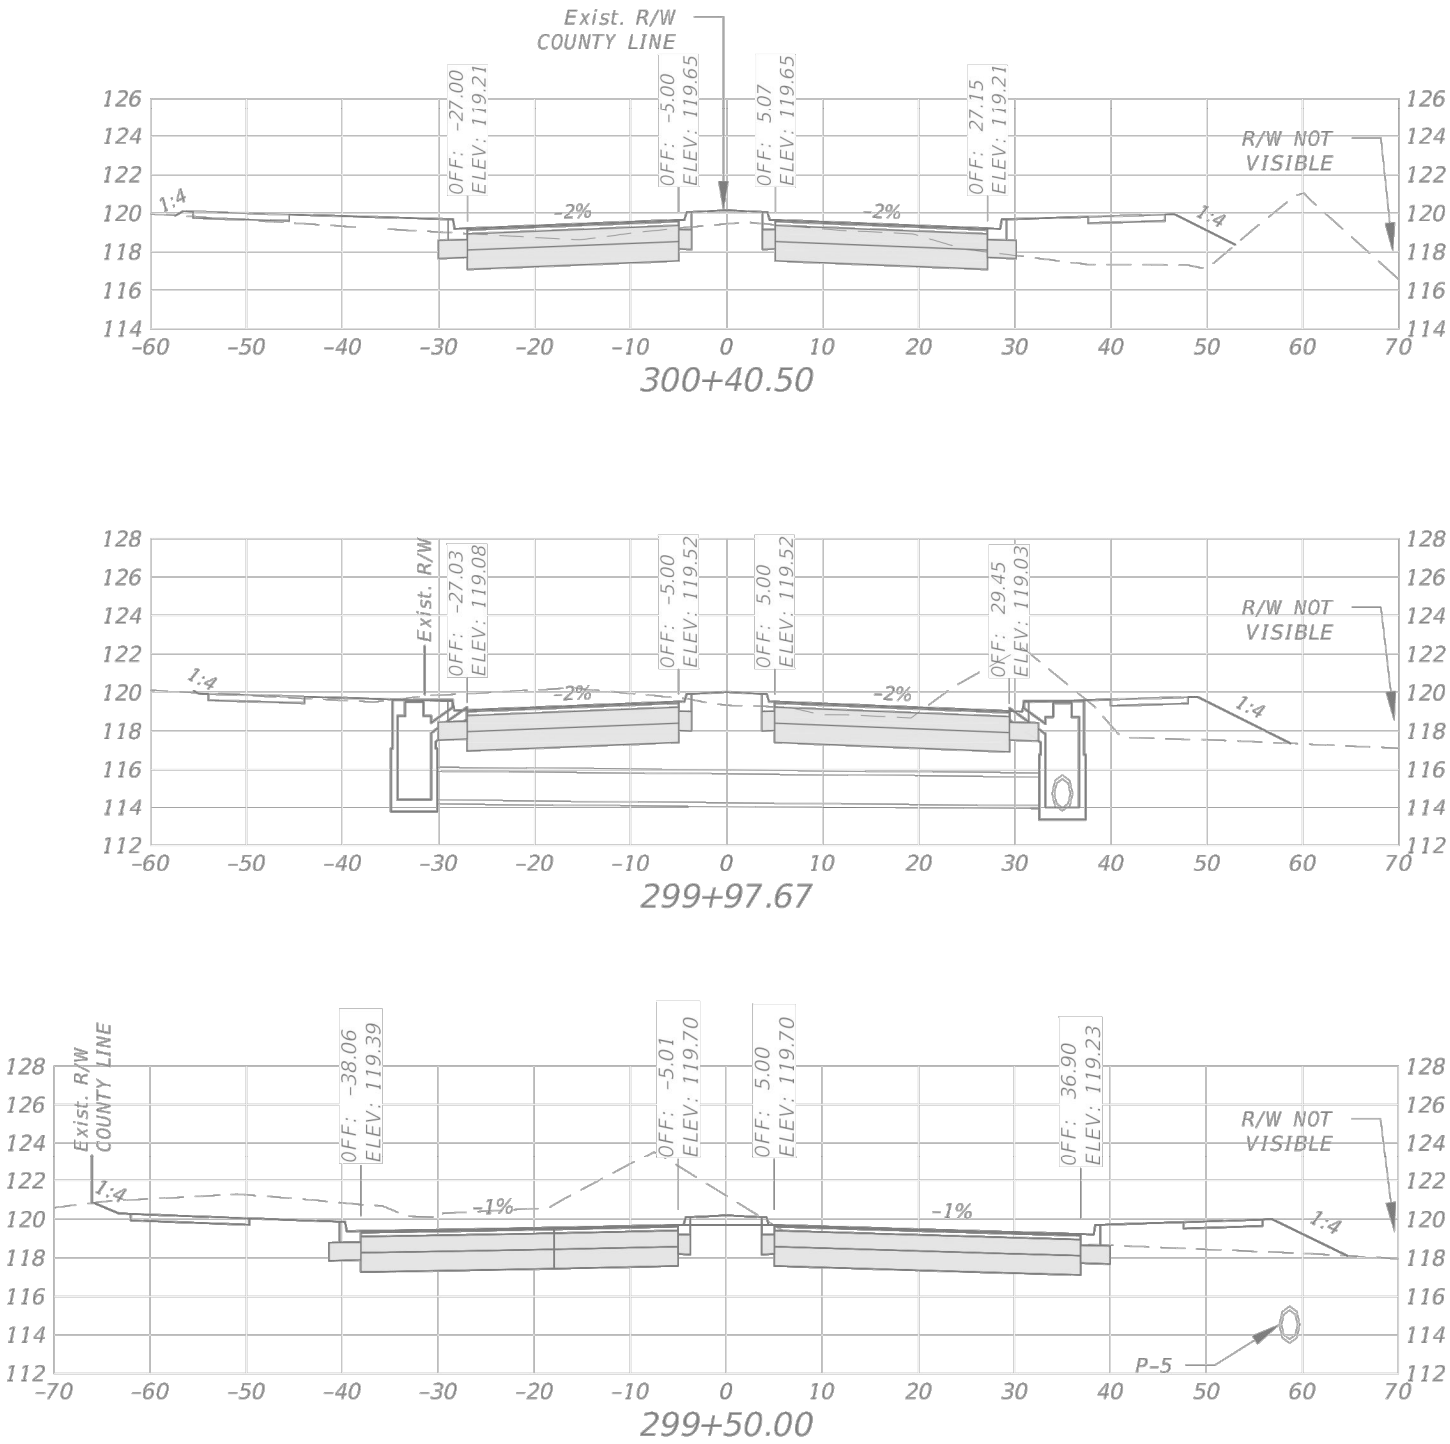

STREET 'B'
CROSS SECTION

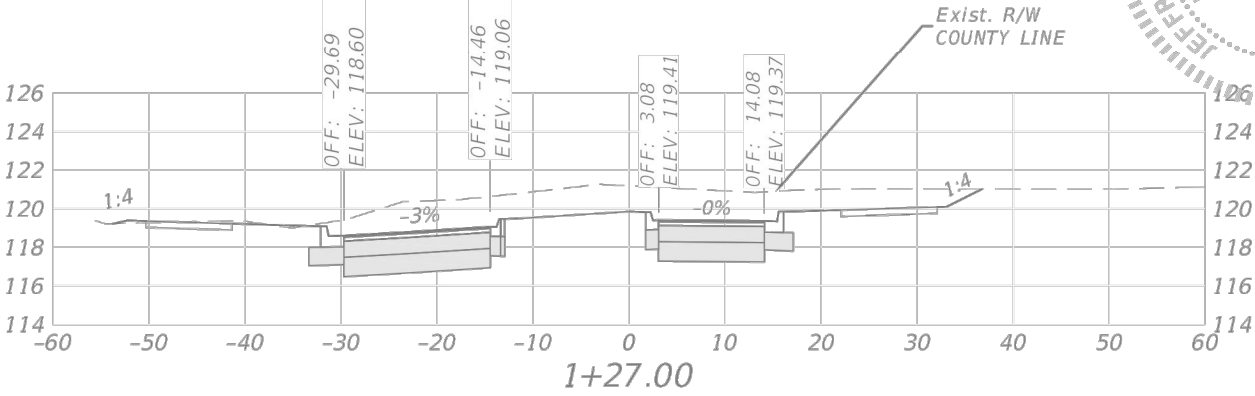

FOR REVIEW ONLY

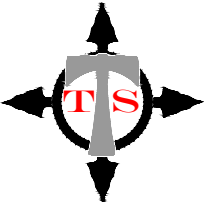

TOMAHAWK SURVEYING

Florida Licensed Business No. LB8449
115 Morningstar Drive
Punta Gorda, FL 33950
(941)-740-0733

DATE	JOB#	DWG	SCALE
06/19/2025	24-79	24-79 ASB	AS SHOWN



DEPARTMENT OF PUBLIC WORKS
ENGINEERING DIVISION

LAKE
COUNTY, FL

350 N. SINCLAIR AVE., TAVARES, FLORIDA 32778

JEFFREY J. EARHART P.E. NO. 49935

REVISION:	DATE
S. -24	
T. -245	
R. -26E	
SURVEYED: CM	DATE: 10/14/20
FIELD BOOK: 229	PAGE: 45-46, 51
DESIGNED: OEN	DATE: 4/24/2024
DRAWN: OEN	DATE: 4/24/2024
APPROVED: JE	DATE: 4/24/2024


SAWGRASS BAY BLVD
MULTILANE ROUNDABOUT
FLEMINGS STREET B X-SECTIONS

JOB NO.:
20032CA

SHEET:
24

0:\2020\20032_SAWGRASS_BAY_BVLD_ROUNDABOUT_TOPO\Engineering\Drawings\Plans\20032CA_SAWGRASS_ROUNDABOUT_6.dwg PLOTTED BY: Nunez, Osvaldo 4/24/2024 8:58 AM

FOR REVIEW ONLY

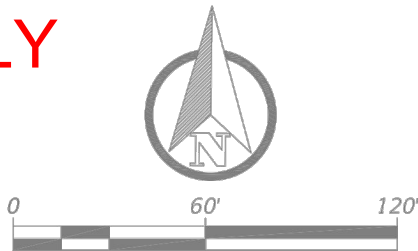

DEPARTMENT OF PUBLIC WORKS
ENGINEERING DIVISION

LAKE
COUNTY, FL


350 N. SINCLAIR AVE., TAVARES, FLORIDA 32778
JEFFREY J. EARHART P.E. NO. 49935

DATE	REVISION:	S.	T.	R.	CM	CM	CM	CM	CM
		-24	-24S	-26E					

SAWGRASS BAY BLVD
MULTILANE ROUNDABOUT
SIGN & STRIPING PLAN (1)

JOB NO.:
20032CA

SHEET:
25

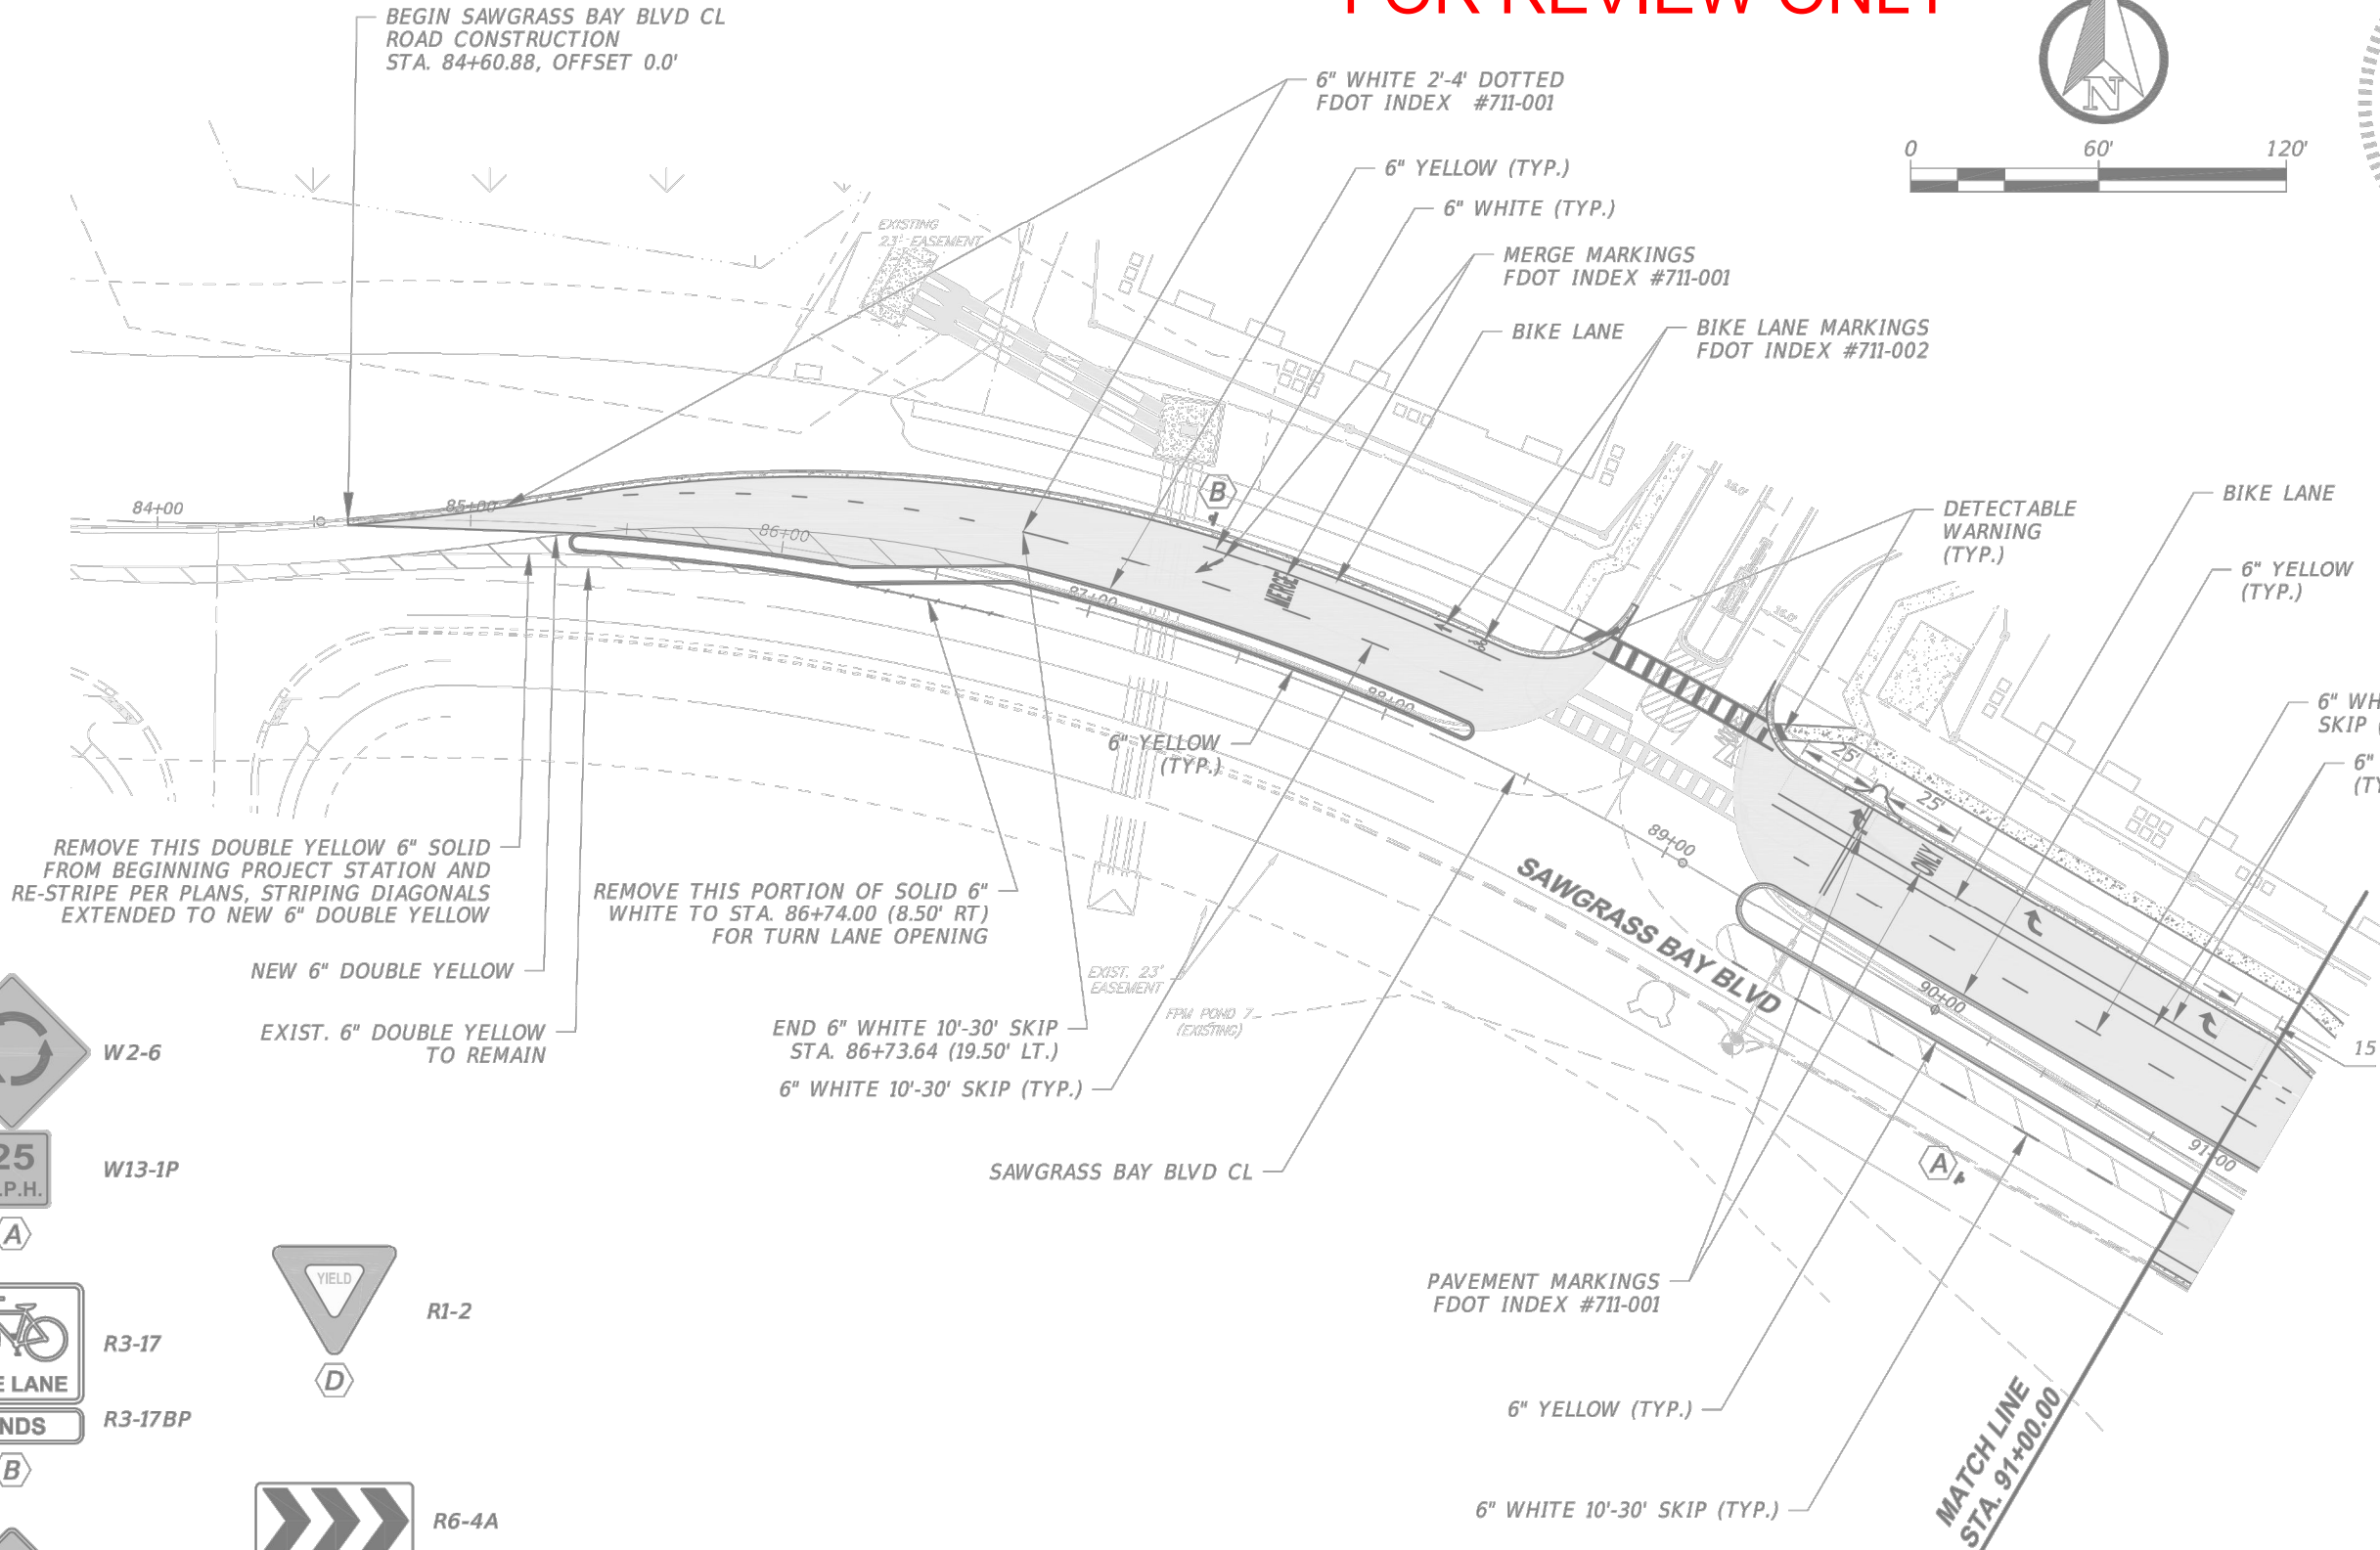

W2-6



W13-1P



R3-17



R3-17BP



W11-2




W16-7



R1-2



R6-4A

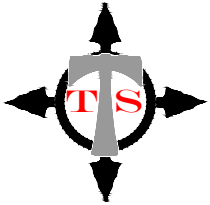


TOMAHAWK SURVEYING

Florida Licensed Business No. LB8449
115 Morningstar Drive
Punta Gorda, FL 33950
(941)-740-0733

DATE	JOB#	DWG	SCALE
06/19/2025	24-79	24-79 ASB	AS SHOWN

6" WHITE 2'-4" DOTTED
FDOT INDEX #711-001

FOR REVIEW ONLY

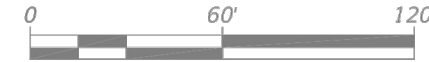

JEFFREY J. EARHART
LITIGANT
No. 49935

DEPARTMENT OF PUBLIC WORKS
ENGINEERING DIVISION





JEFFREY J. EARTH P.E. NO. 49935

350 N SINCLAIR AVE TAVARES FLORIDA 32778

S. - 24	T. - 245	R. - 26E	REVISION:	DATE
SURVEYED: CM	DATE: 10/14/20			
FIELD BOOK: 229	PAGE: 45-46, 51			
DESIGNED: 0EN	DATE: 4/24/2024			
DRAWN: 0EN	DATE: 4/24/2024			
APPROVED: JF	DATE: 4/24/2024			

SAWGRASS BAY BLVD
MULTILANE ROUNDABOUT
SIGN & STRIPING PLAN (2)

JOB NO.: 20032CA
SHEET: 26

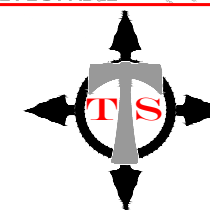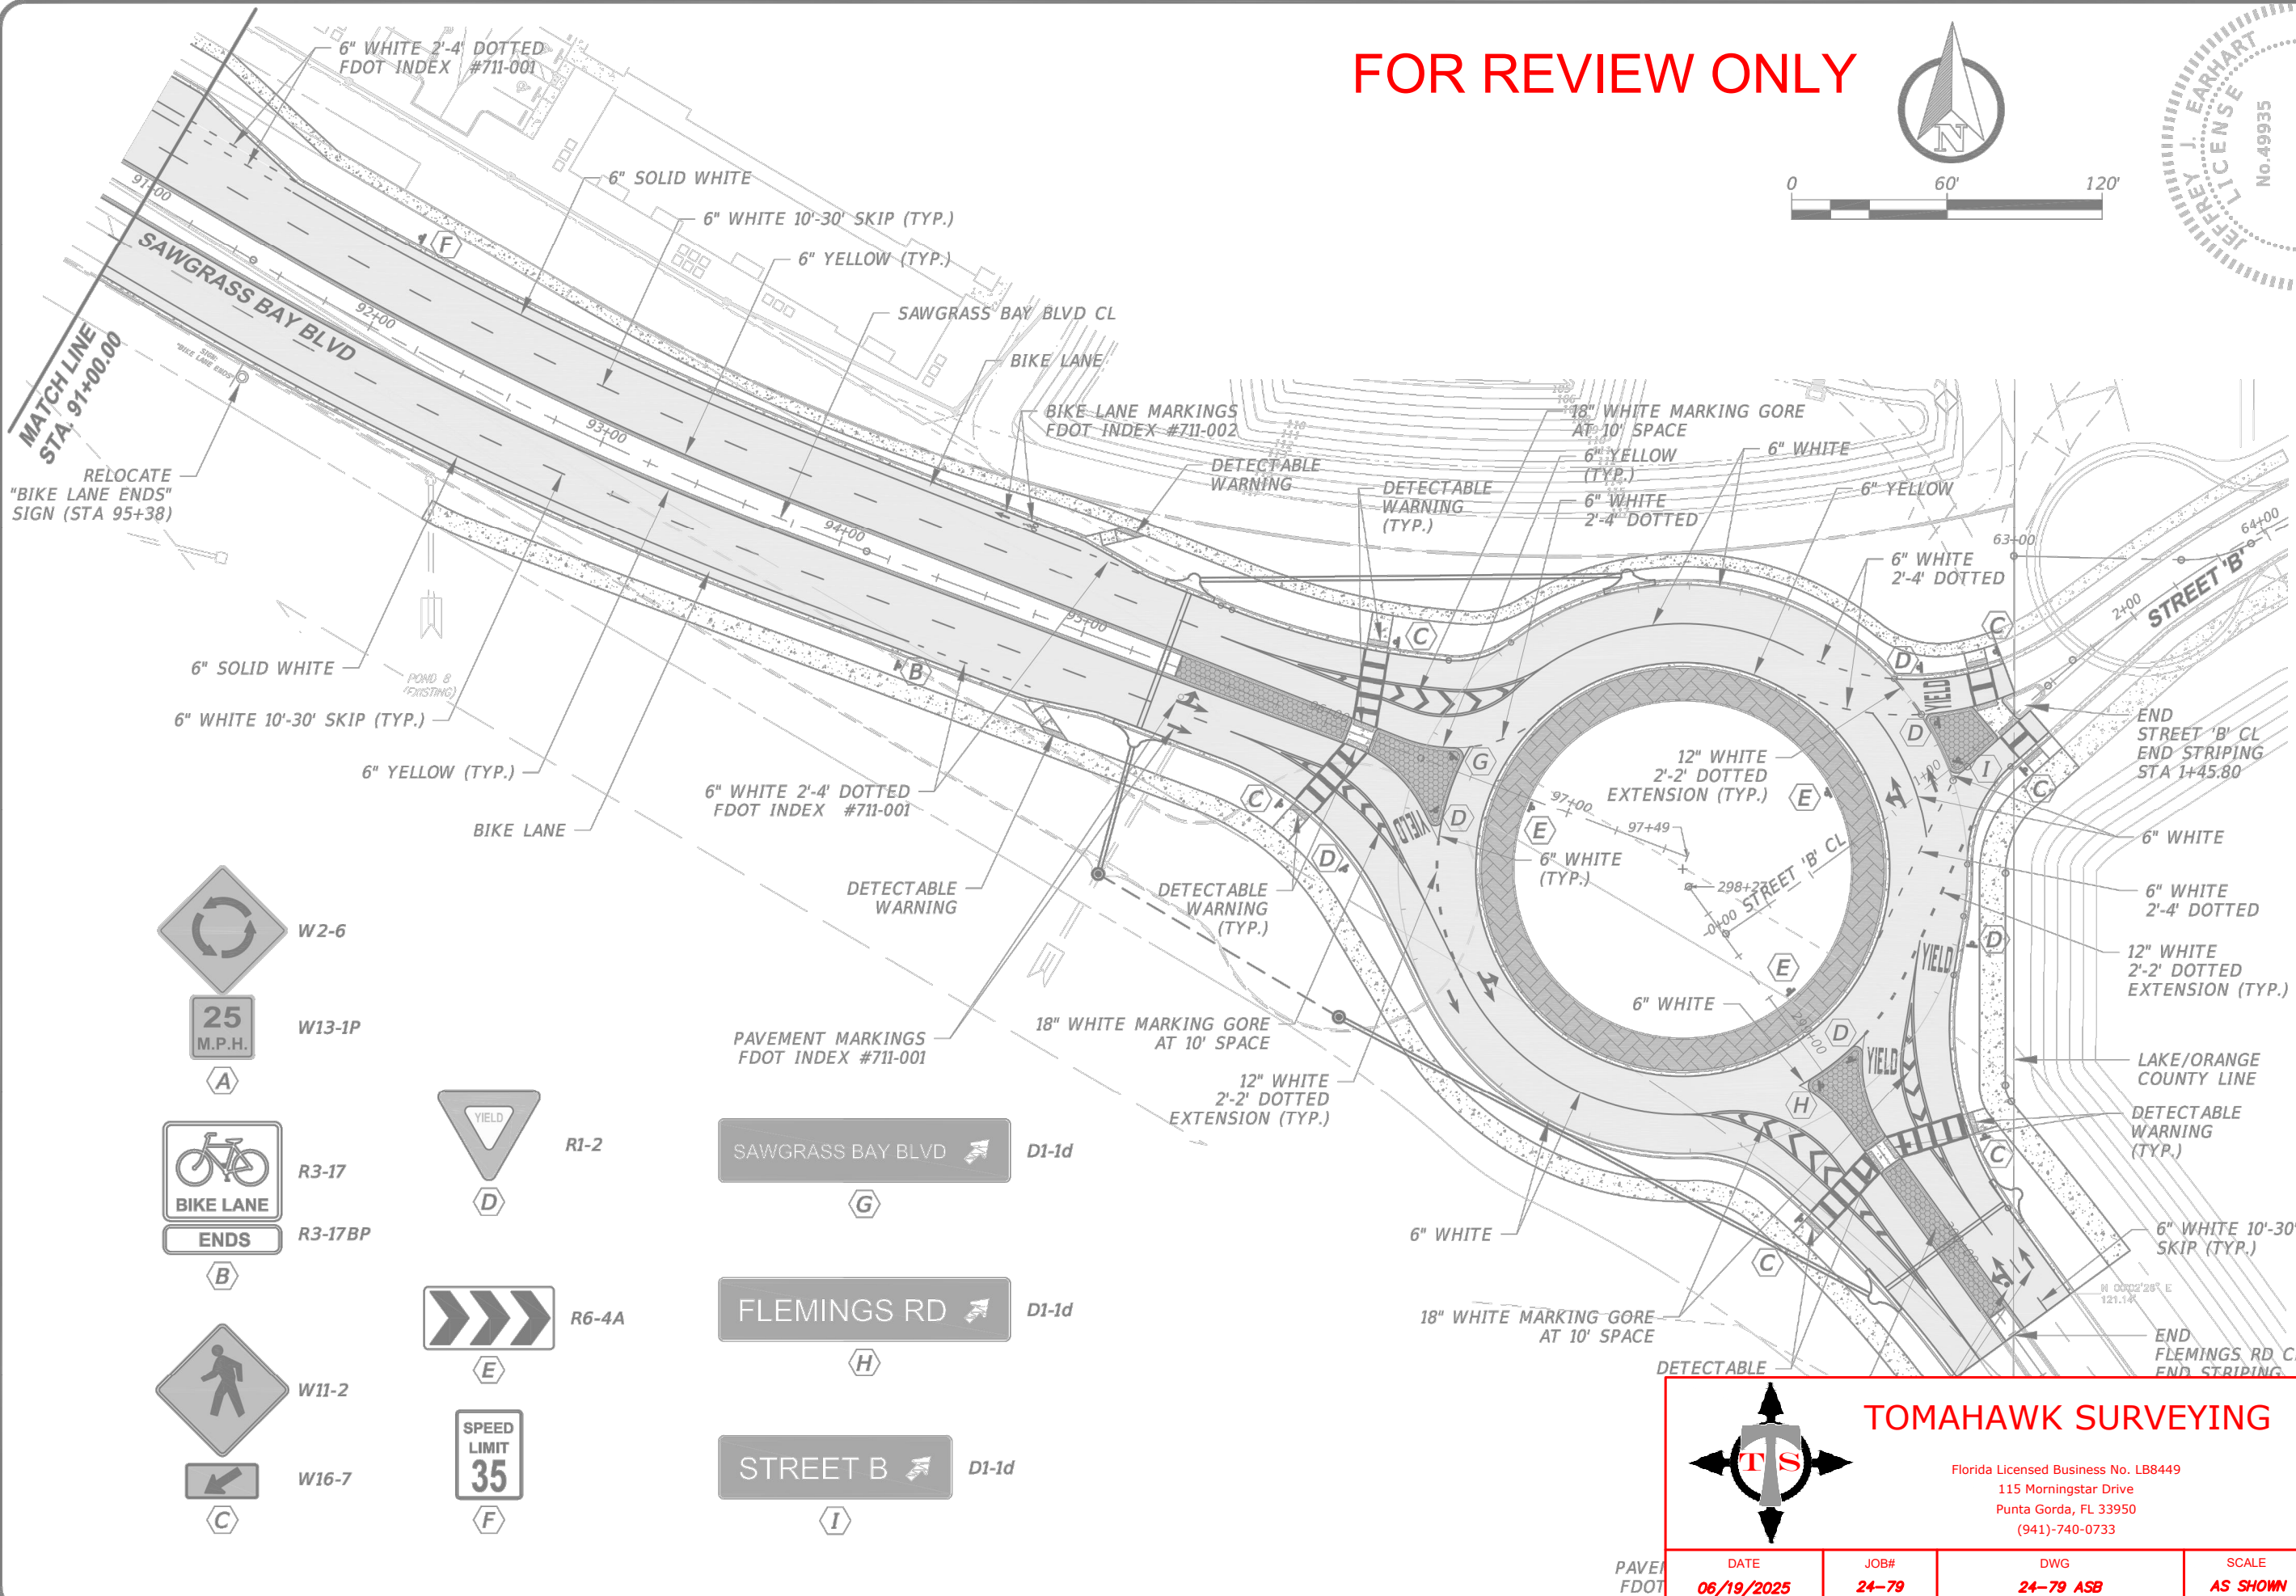

TOMAHAWK SURVEYING

Florida Licensed Business No. LB8449
115 Morningstar Drive
Punta Gorda, FL 33950
(941)-740-0733

PAVE FDOT	DATE 06/19/2025	JOB# 24-79	DWG 24-79 ASB	SCALE AS SHOWN
--------------	--------------------	---------------	------------------	-------------------