


# 2-2427 O'BRIEN ROAD AS BUILT

LAKE COUNTY, FLORIDA  
PUBLIC WORKS DEPARTMENT  
PROJECT No. 16-87




| SHEET No. | INDEX                    |
|-----------|--------------------------|
| 1         | KEY SHEET                |
| 2         | PLAN VIEW, ROAD SECTIONS |

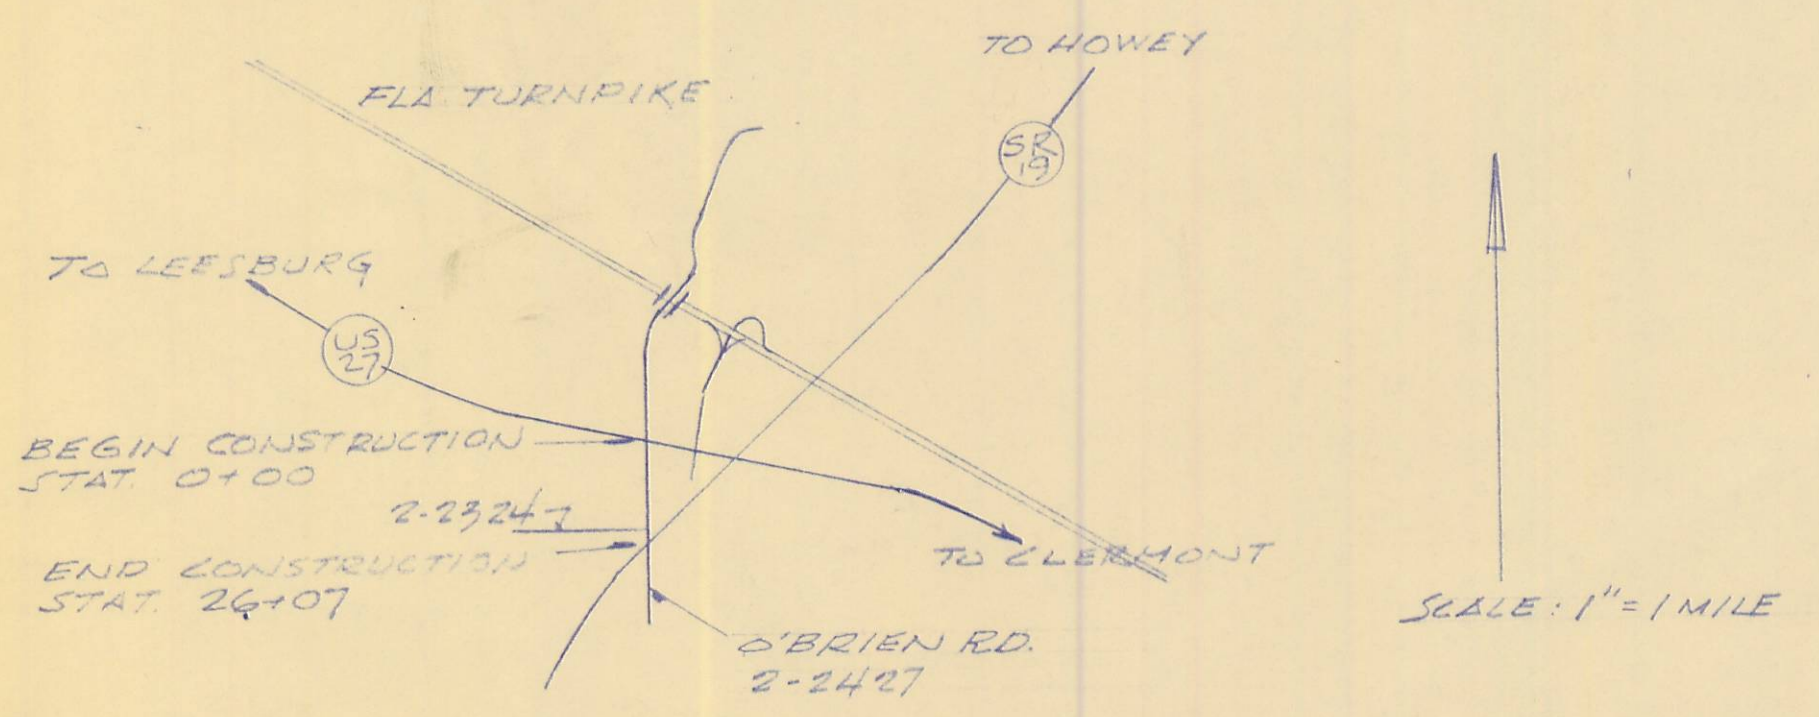

Chad B. Bahr  
7/31/87

TRAC ROADBUILDERS, INC.

JULY 1987

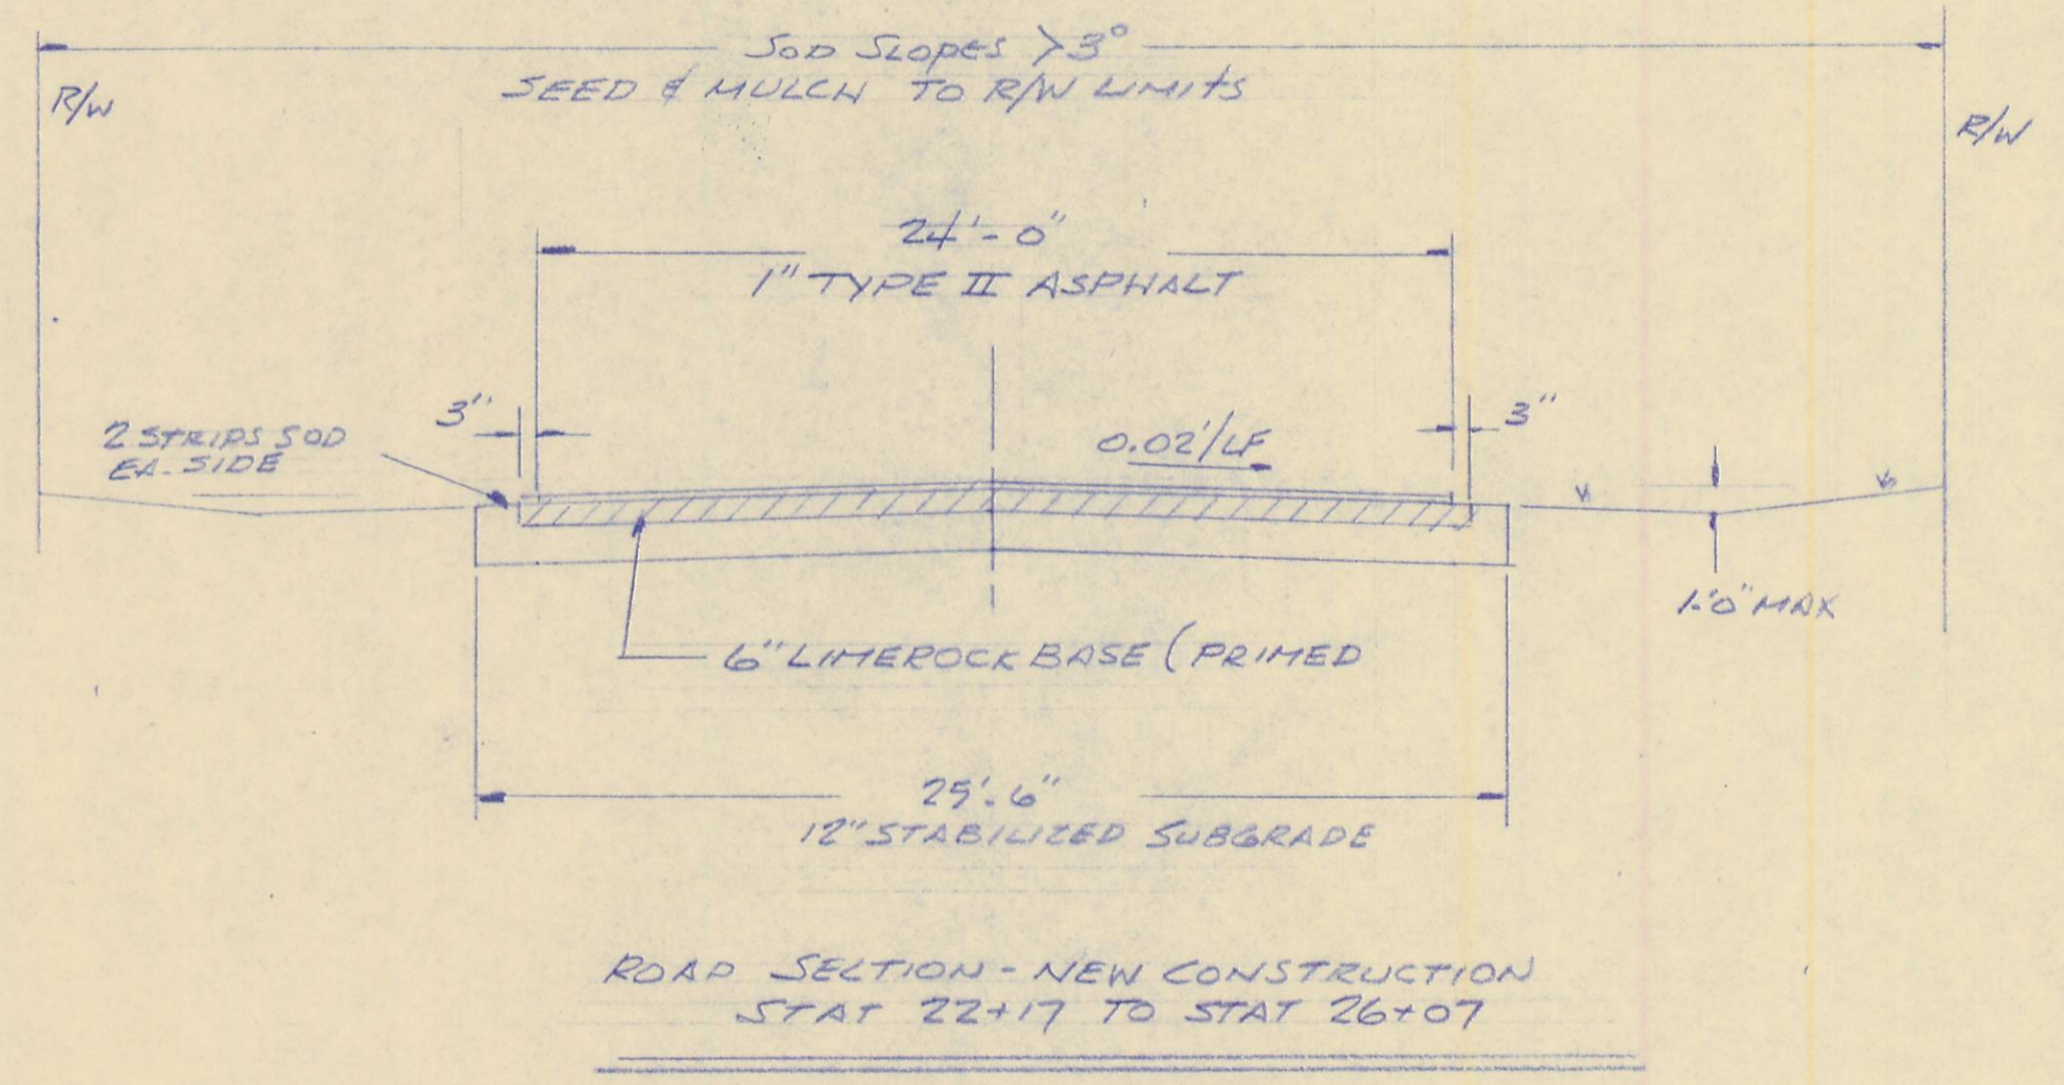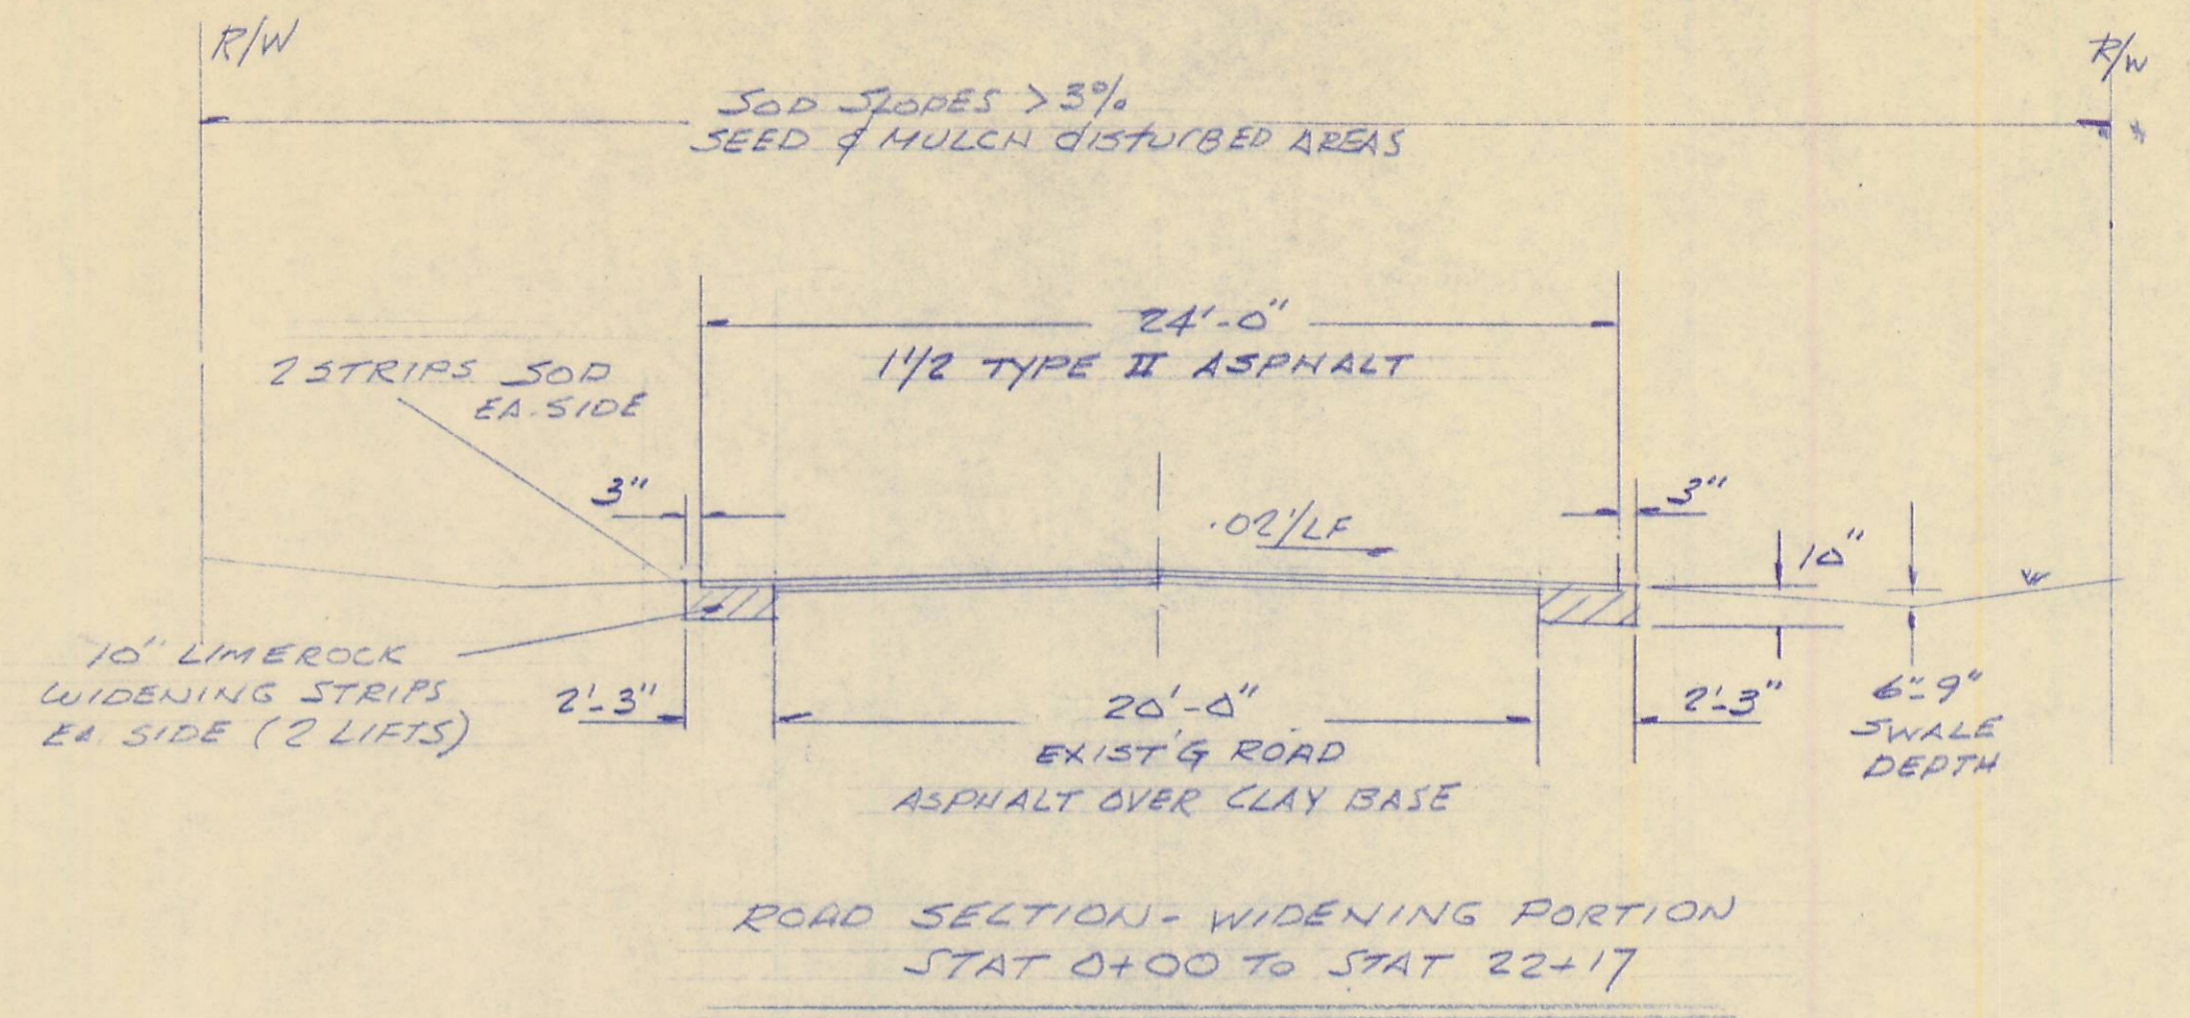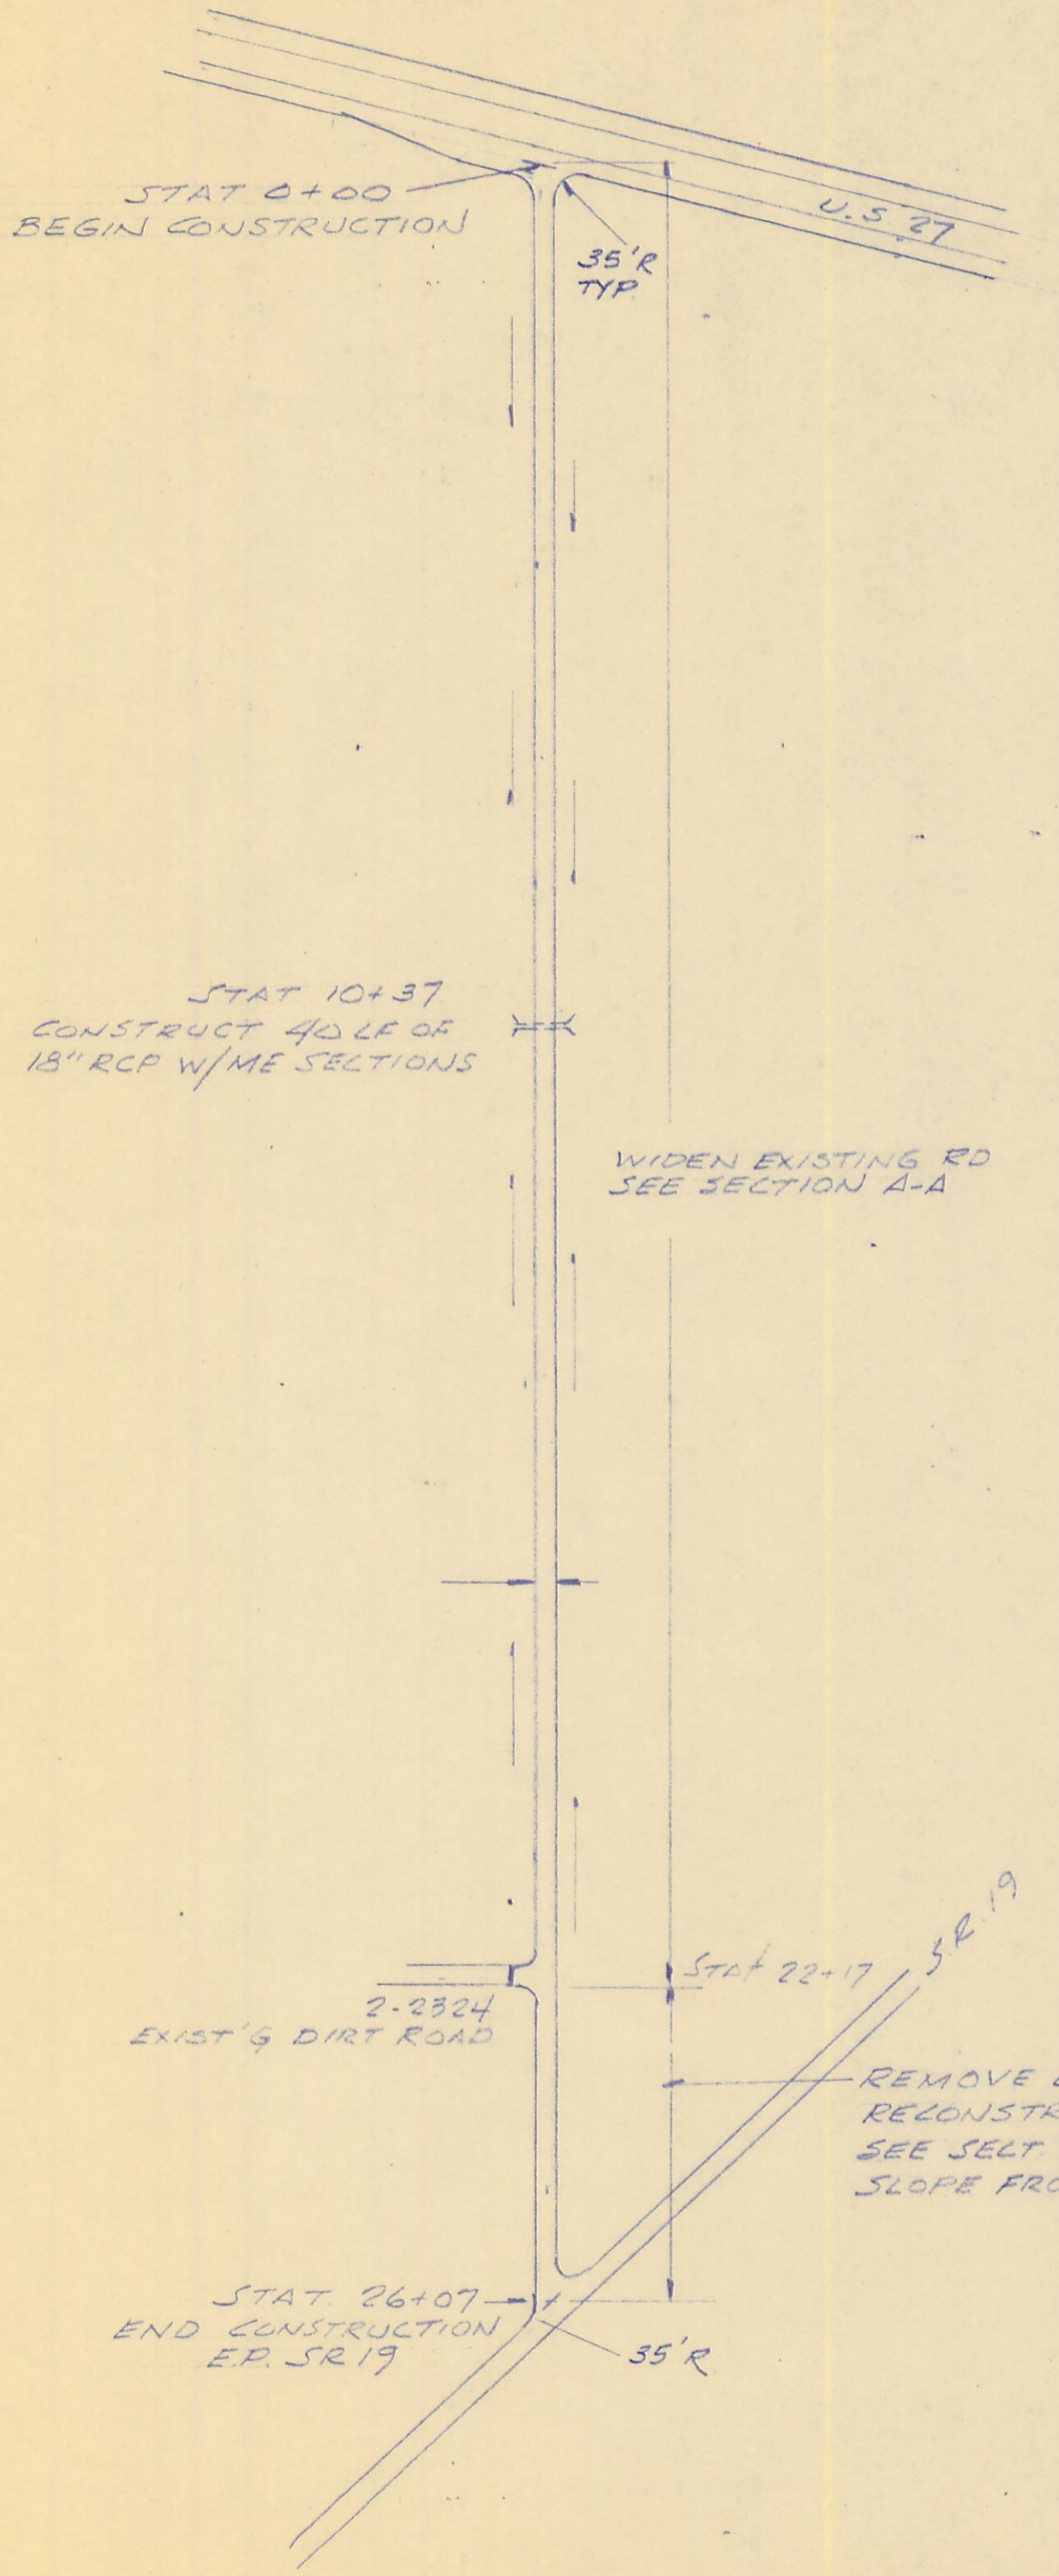

Clark B. Baker  
7/31/87