


Hook St. Ph.3 C/L Elevations

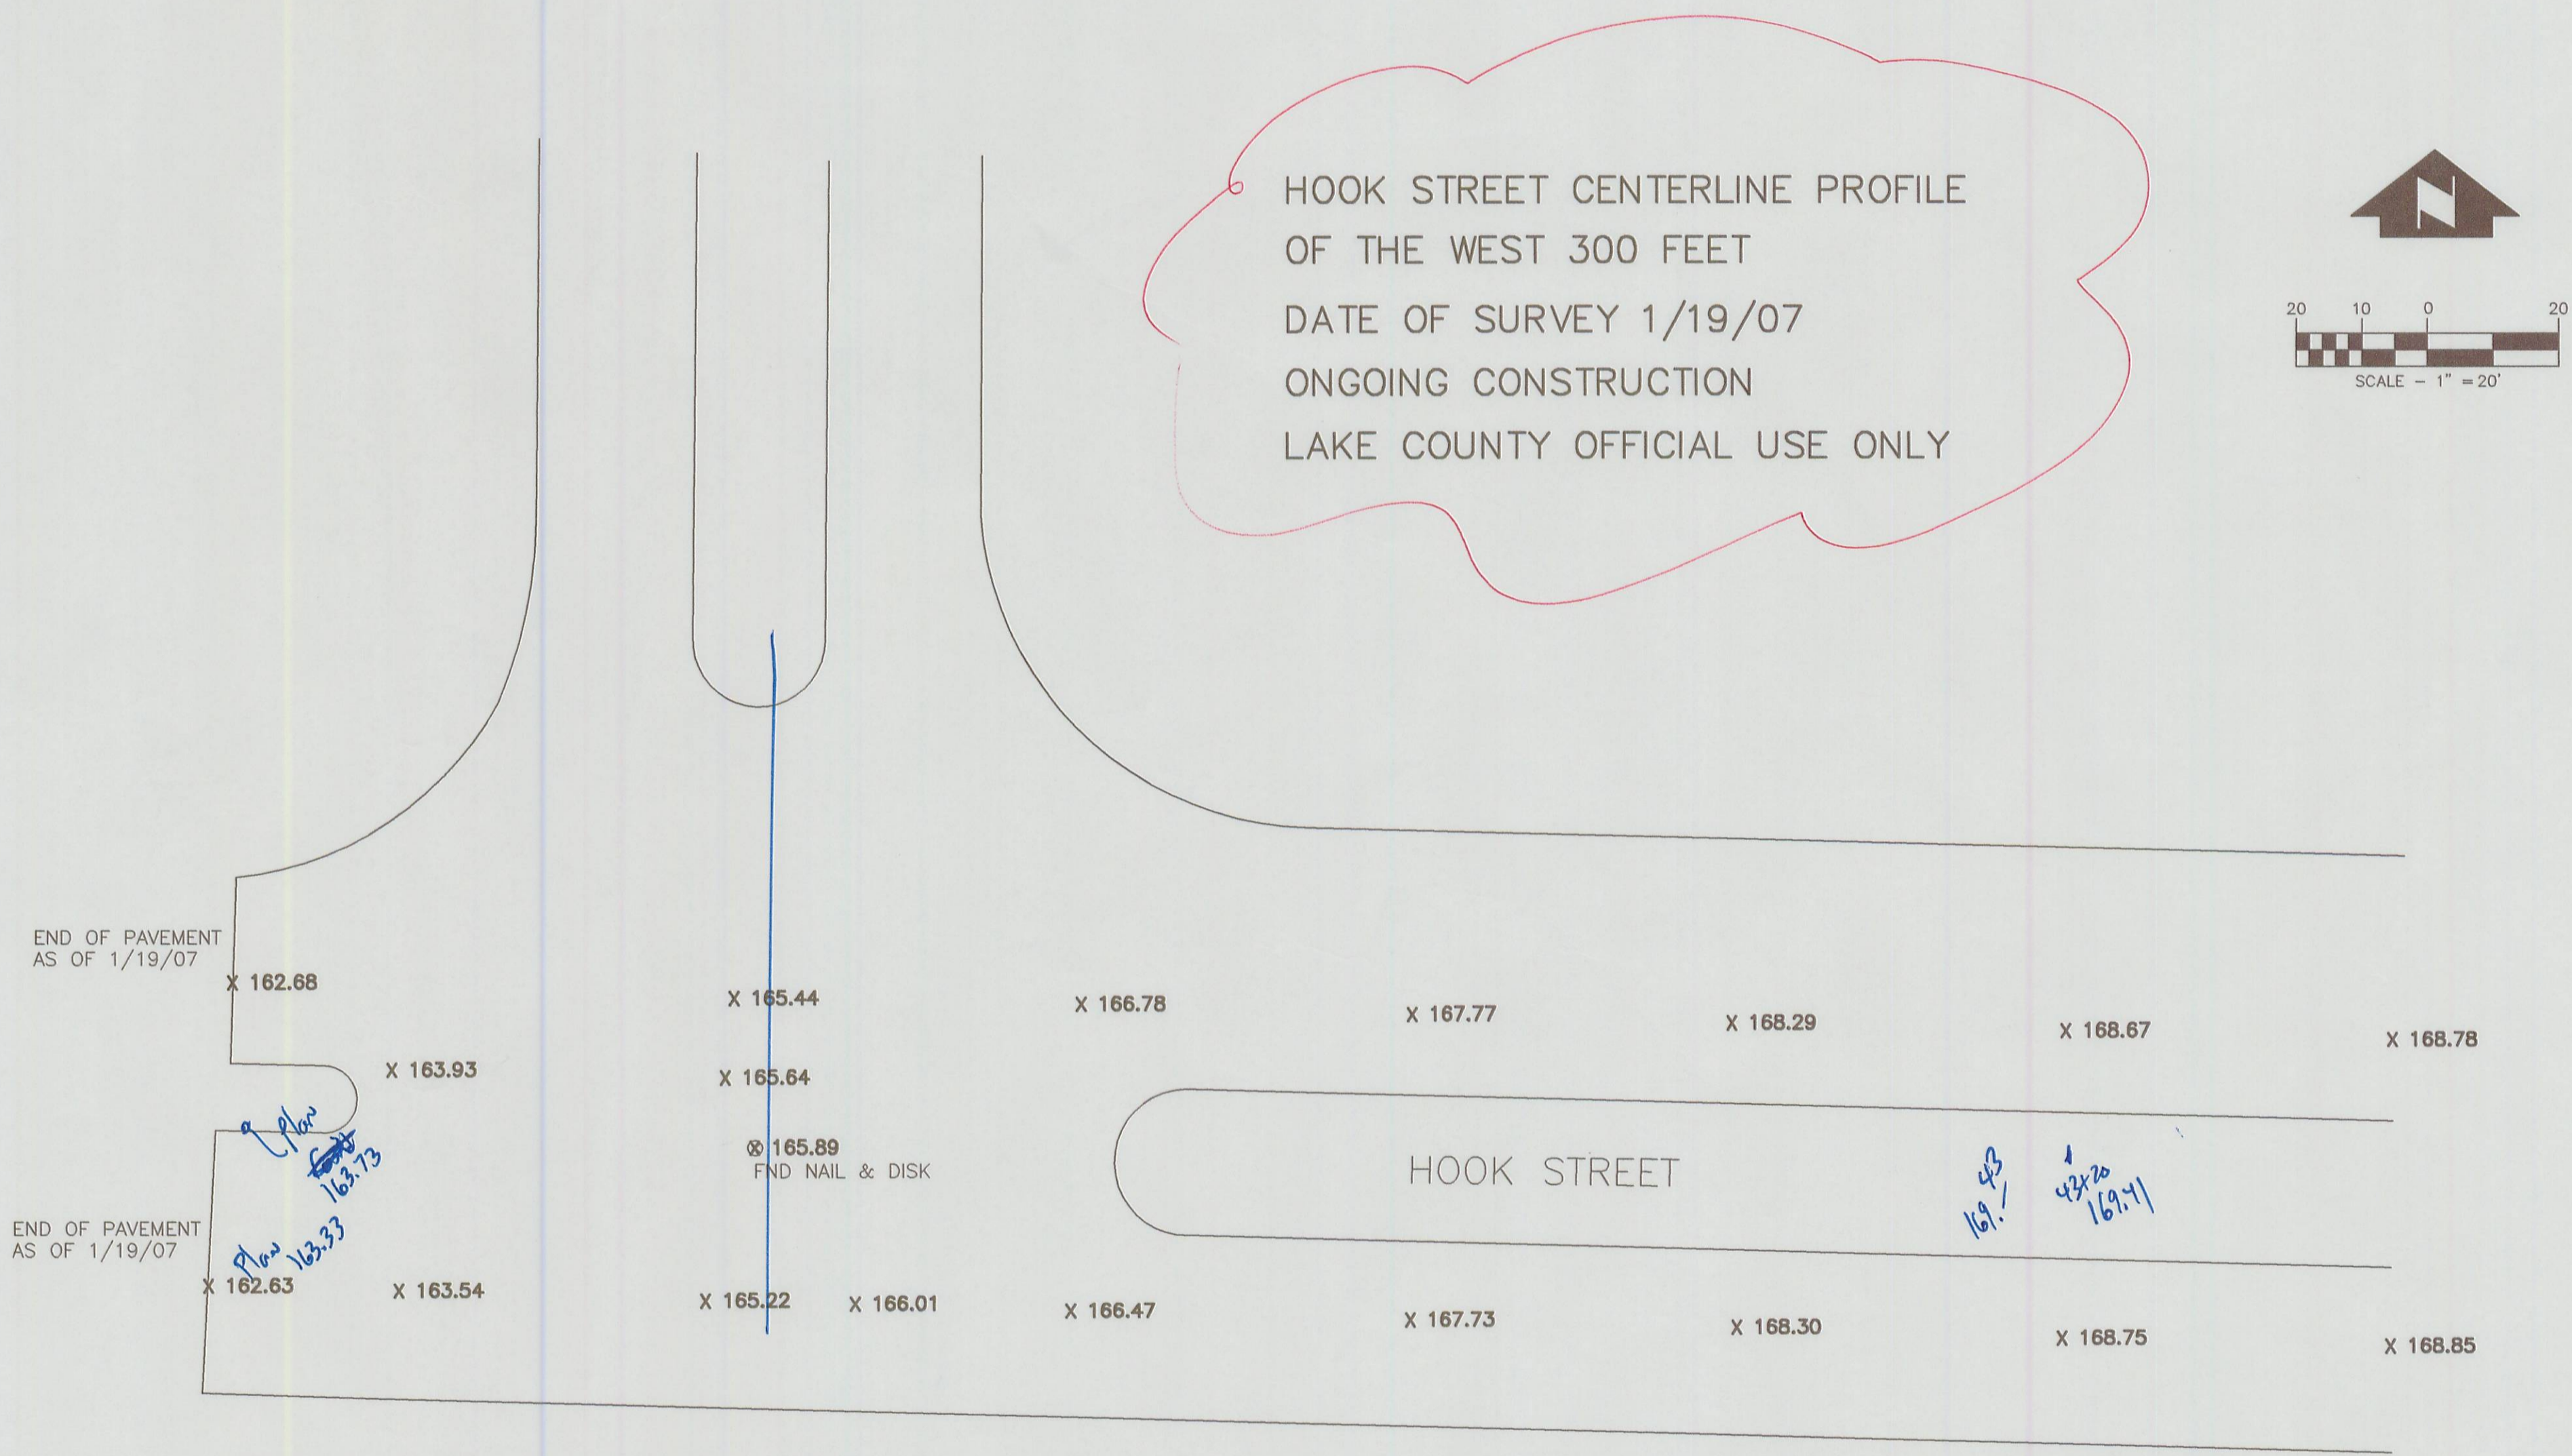

JEFF - AS - BOLT PER FRED
 DON'T HAVE CONSTRUCTION PLANS
 TO COMPARE -
 Sam