

RECORD DRAWING CERTIFICATION FOR PHASE


CONTRACTOR HEREBY CERTIFIES THAT THIS DRAWING HAS BEEN MODIFIED TO SHOW ALL CHANGES TO THE ORIGINAL CONSTRUCTION DRAWINGS AND ACCURATELY REPRESENTS THE FINISHED CONSTRUCTION AS DETAIL OF CONTINUOUS CONSTRUCTION OF ON-SITE CONSTRUCTION WORK MEASUREMENTS, BUT HAS MADE PERIODIC VISUAL OBSERVATIONS AND HAS RESPONSIBILITY OF THE BUILDER AND IS NOT INCLUDED IN THIS CERTIFICATION.

BY: *Donald W. McIntosh* DATE: 3/18/98


NOTES:
NOT A RECORD DRAWING UNLESS THIS BLOCK IS COMPLETED

REVISIONS


NO.	DATE	DESCRIPTION
1	7-22-96	REV. WATER AND SEWER NOTE 10
2	7-22-96	REV. CONTROL STRUCTURE SMA-2
3	8-1-96	DELETE TEMP. DITCH CONVEYANCE SECTION & EDIT TYPICAL POND SECTION
4	9-5-96	ADDED FIG. & D NOTES 27 & 28 DELETED WATER PVC SPEC. EXIST. UNIFORM BASE & PAV. ASPHALT.

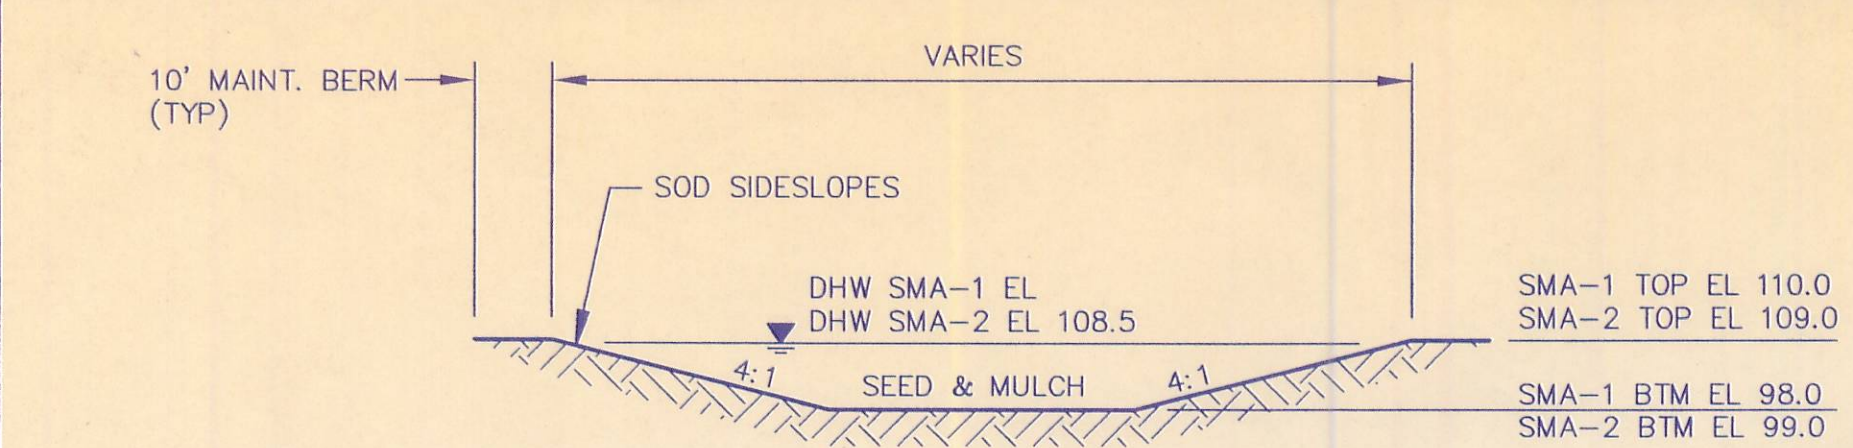


TYPICAL POND SECTION

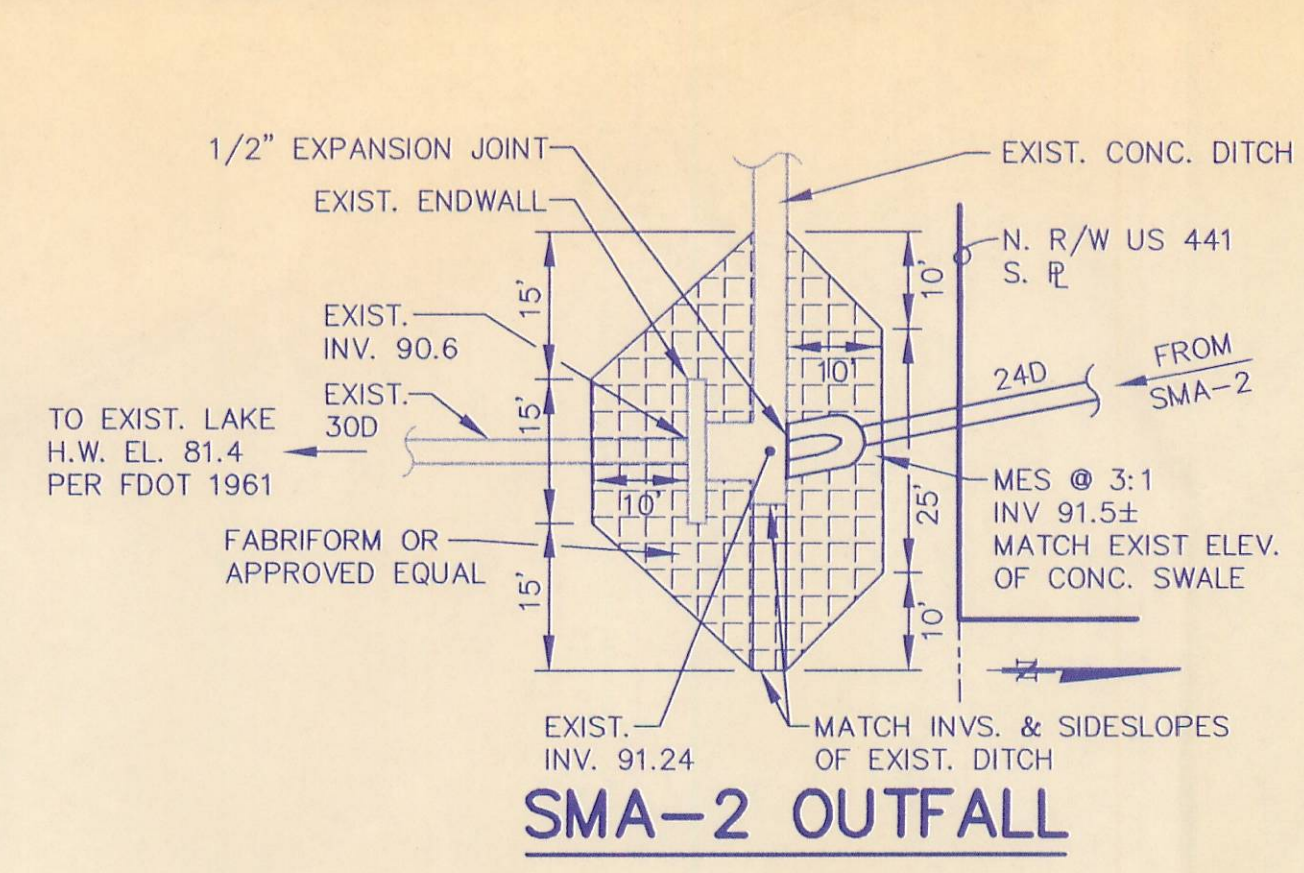


SMA-2 OUTFALL

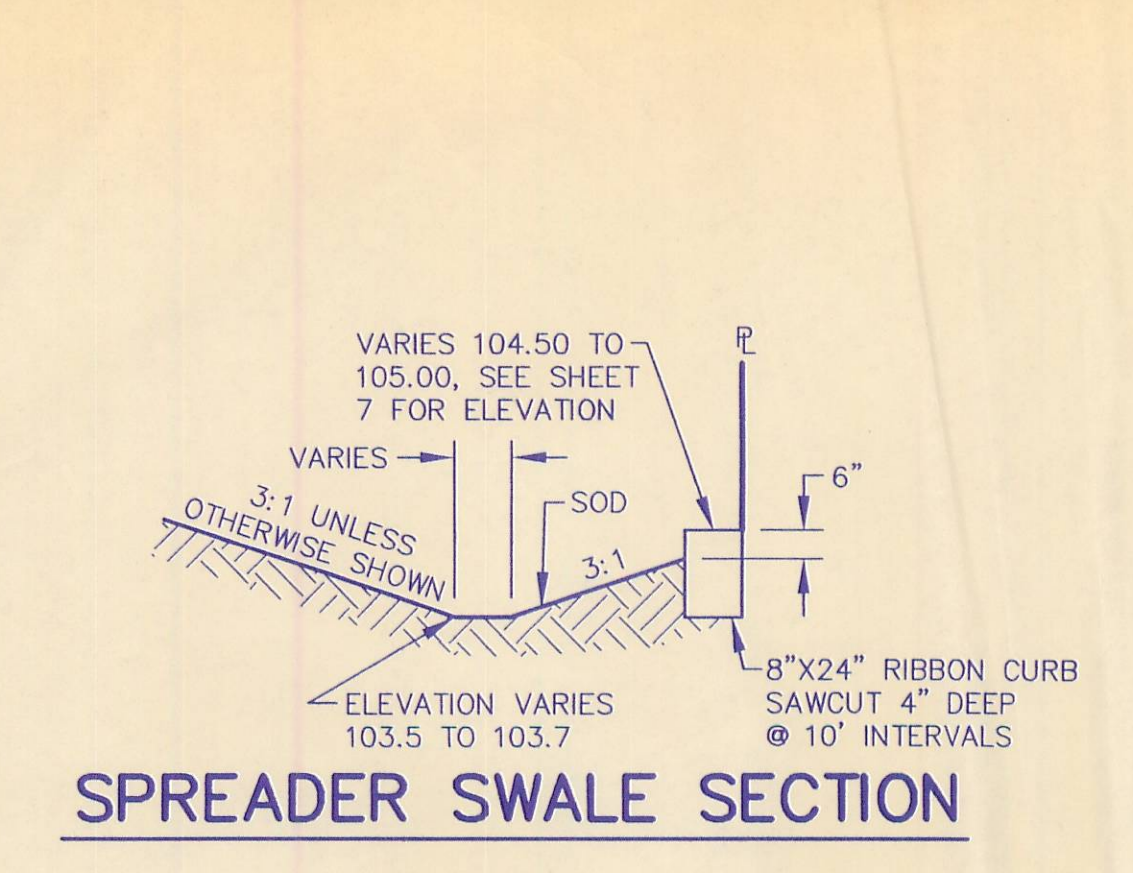


SPREADER SWALE SECTION

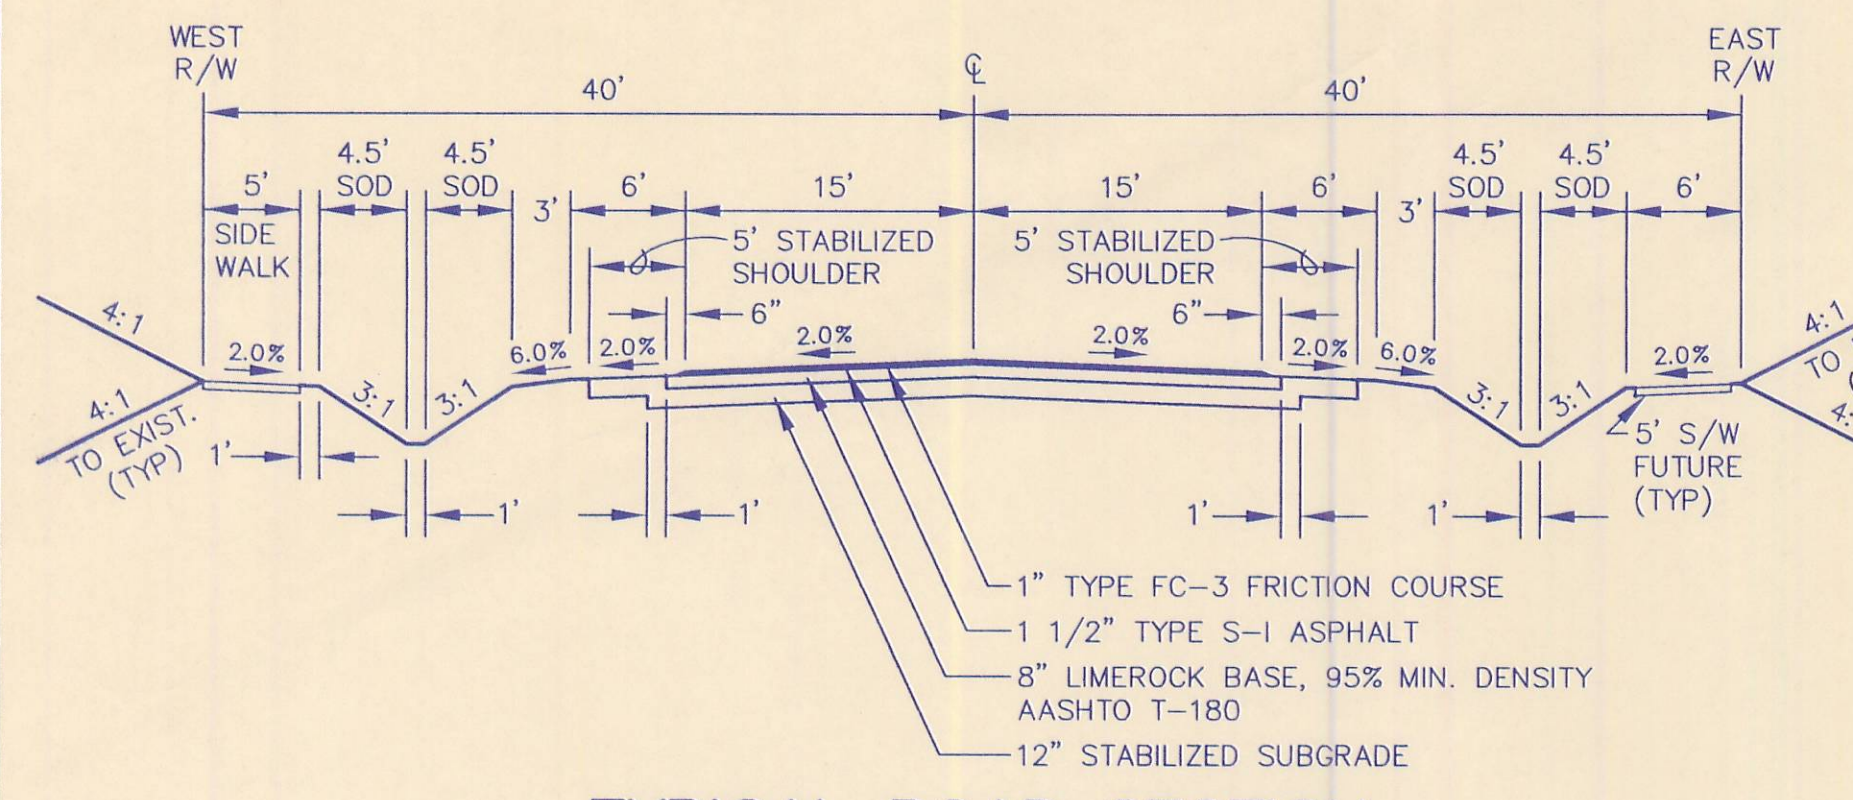


TYPICAL ROAD SECTION

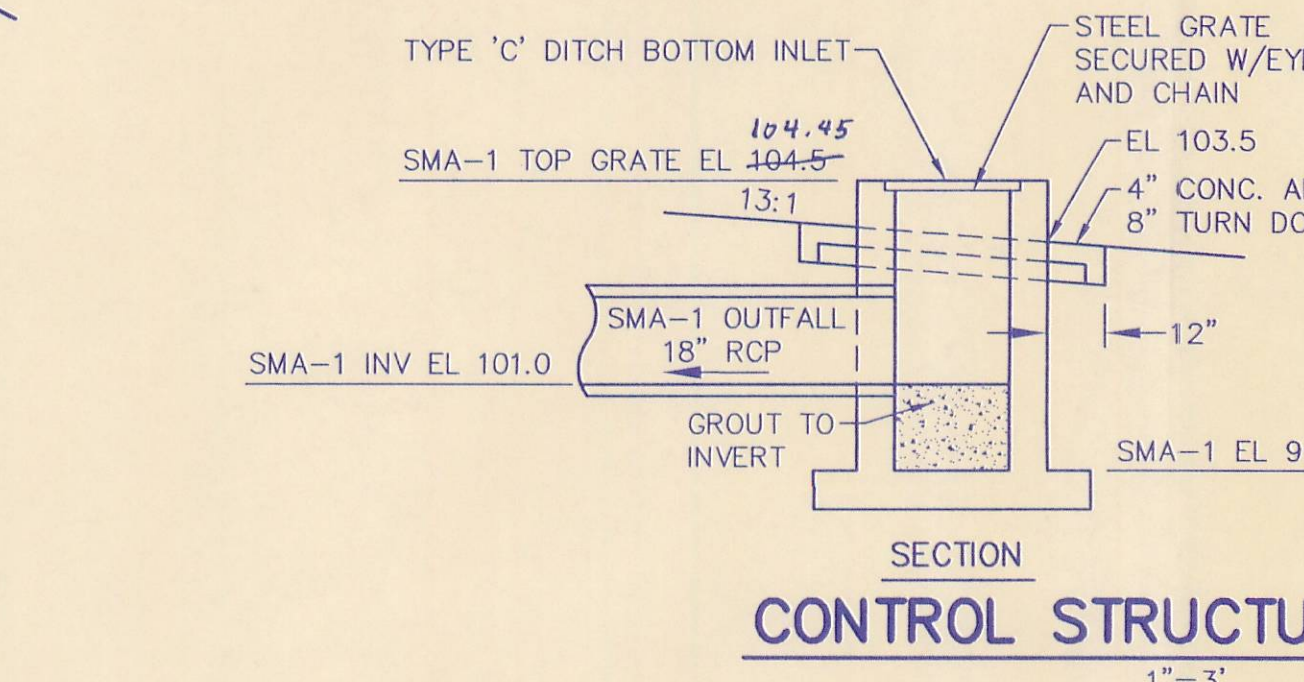


CONTROL STRUCTURE SMA-1

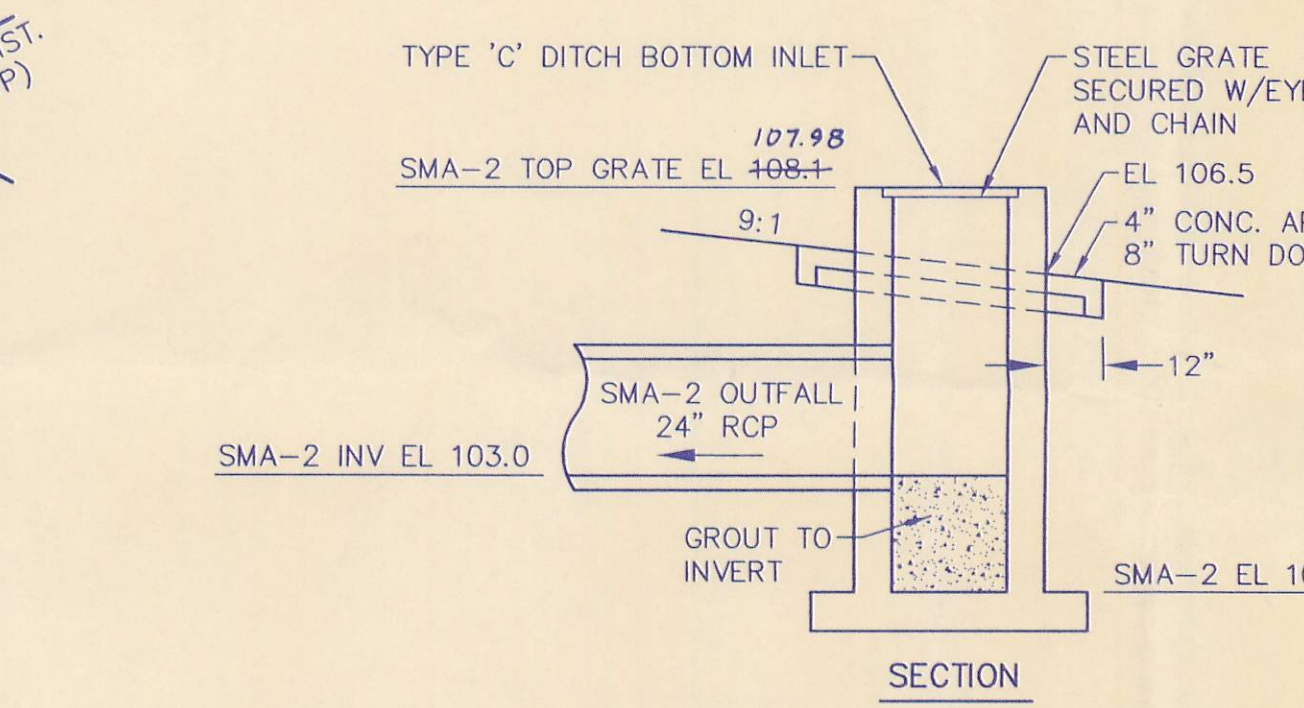


CONTROL STRUCTURE SMA-2

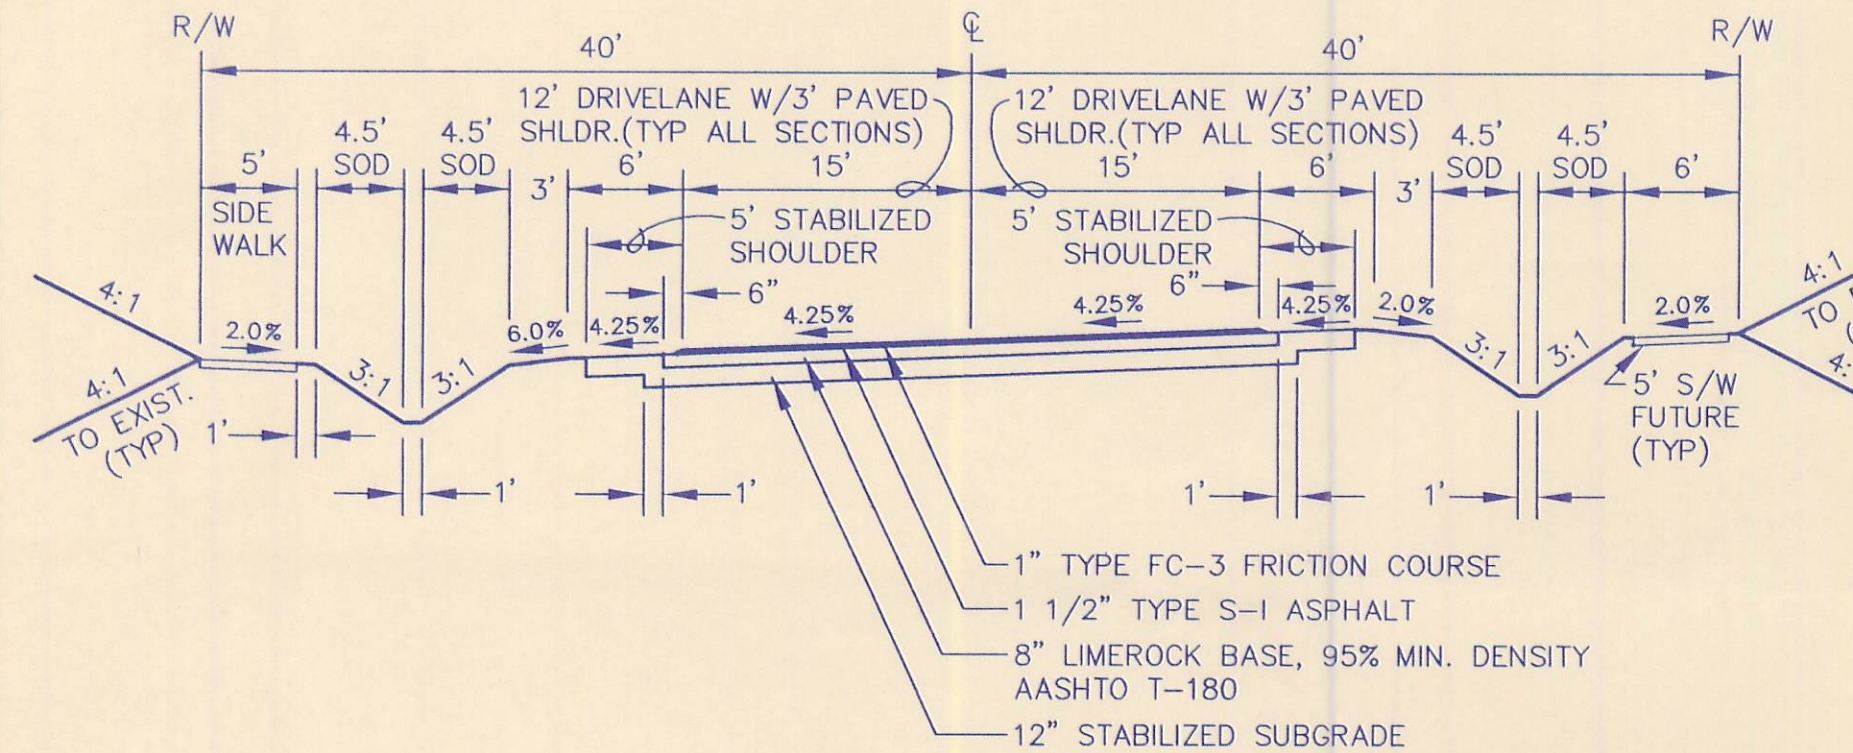


TYPICAL SUPERELEVATION ROAD SECTION

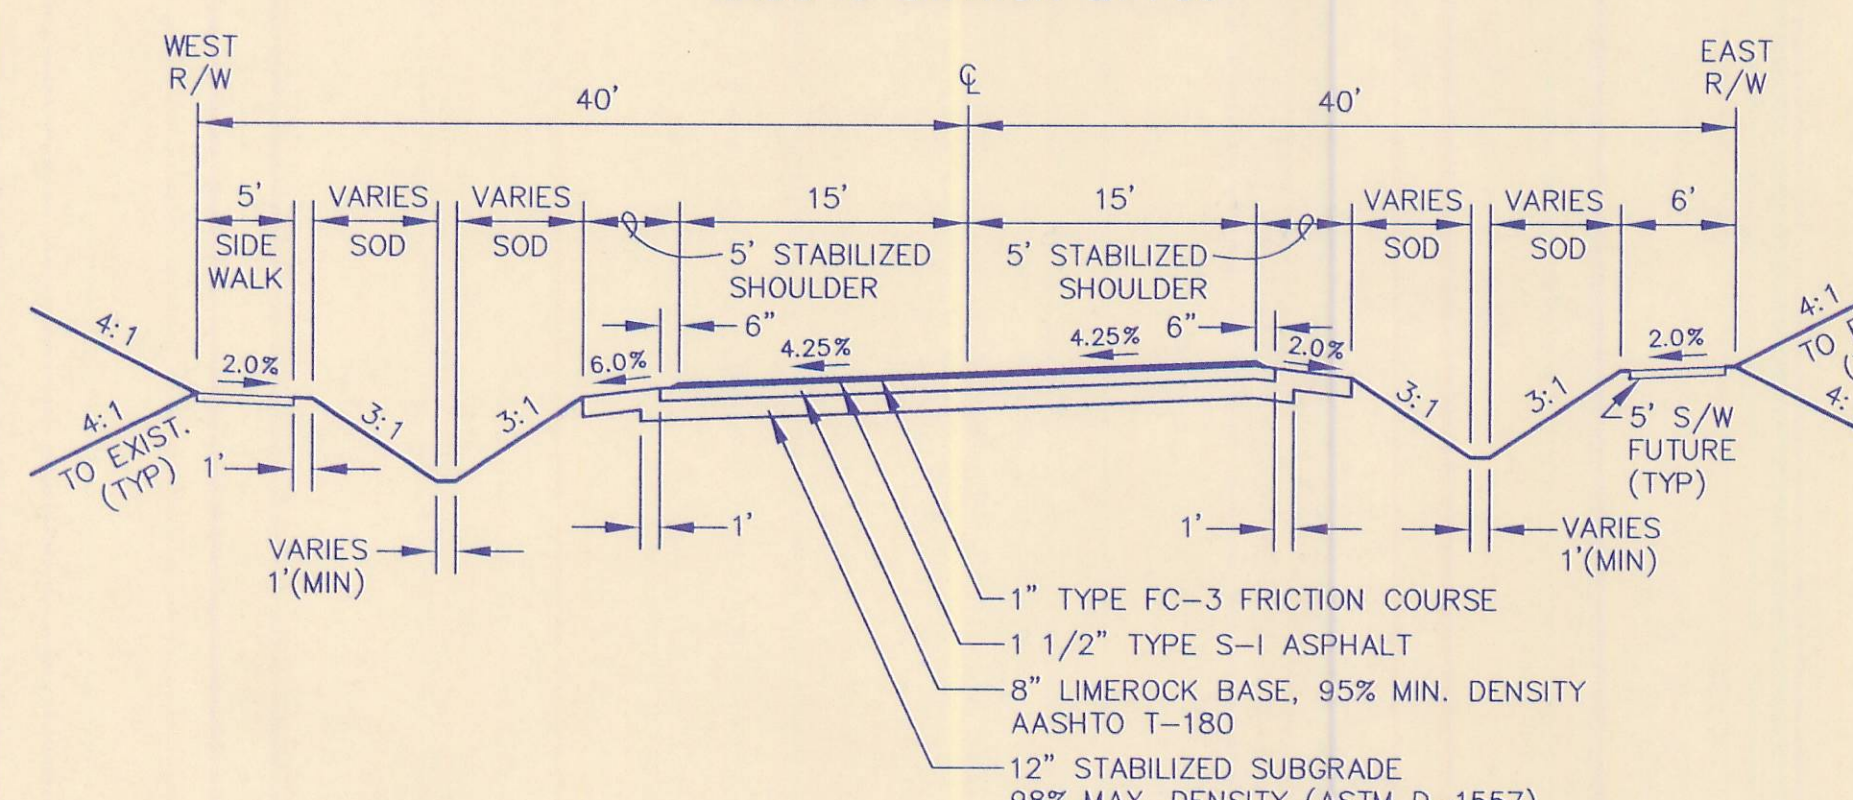


TYPICAL SUPERELEVATION ROAD SECTION

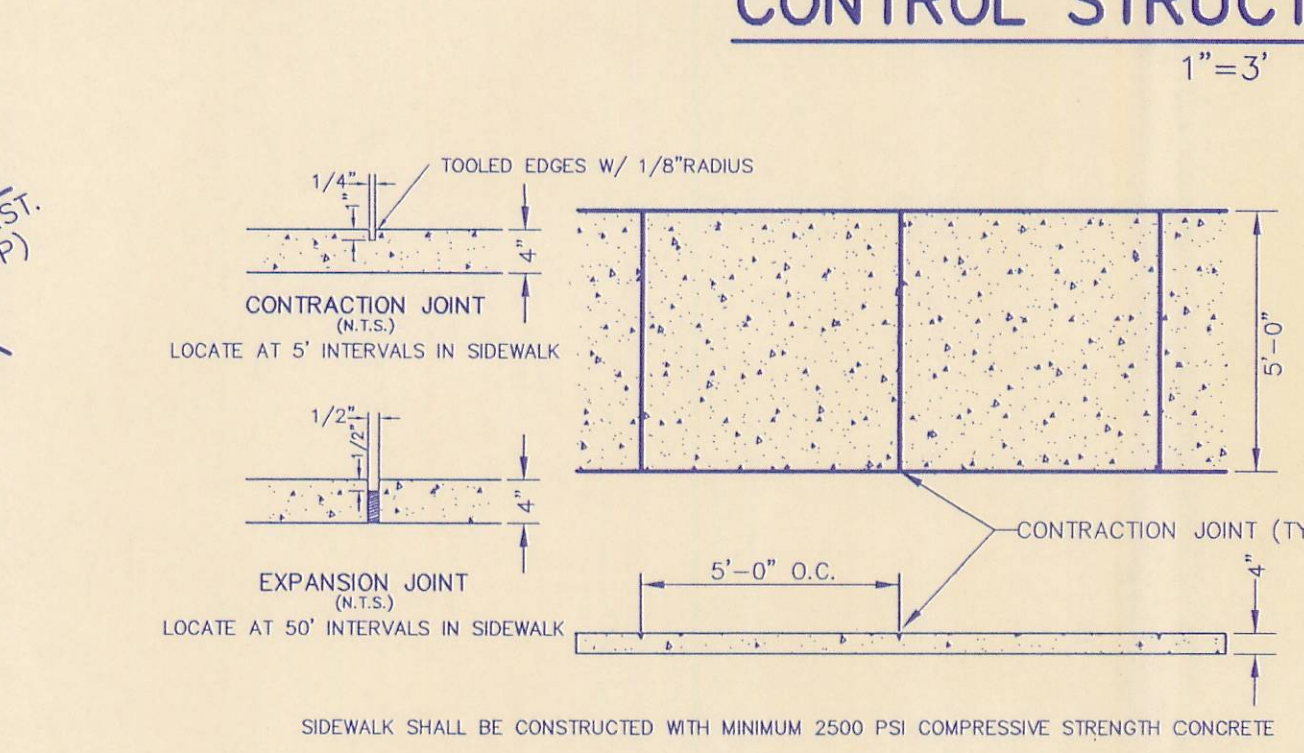

TYPICAL SIDEWALK DETAIL

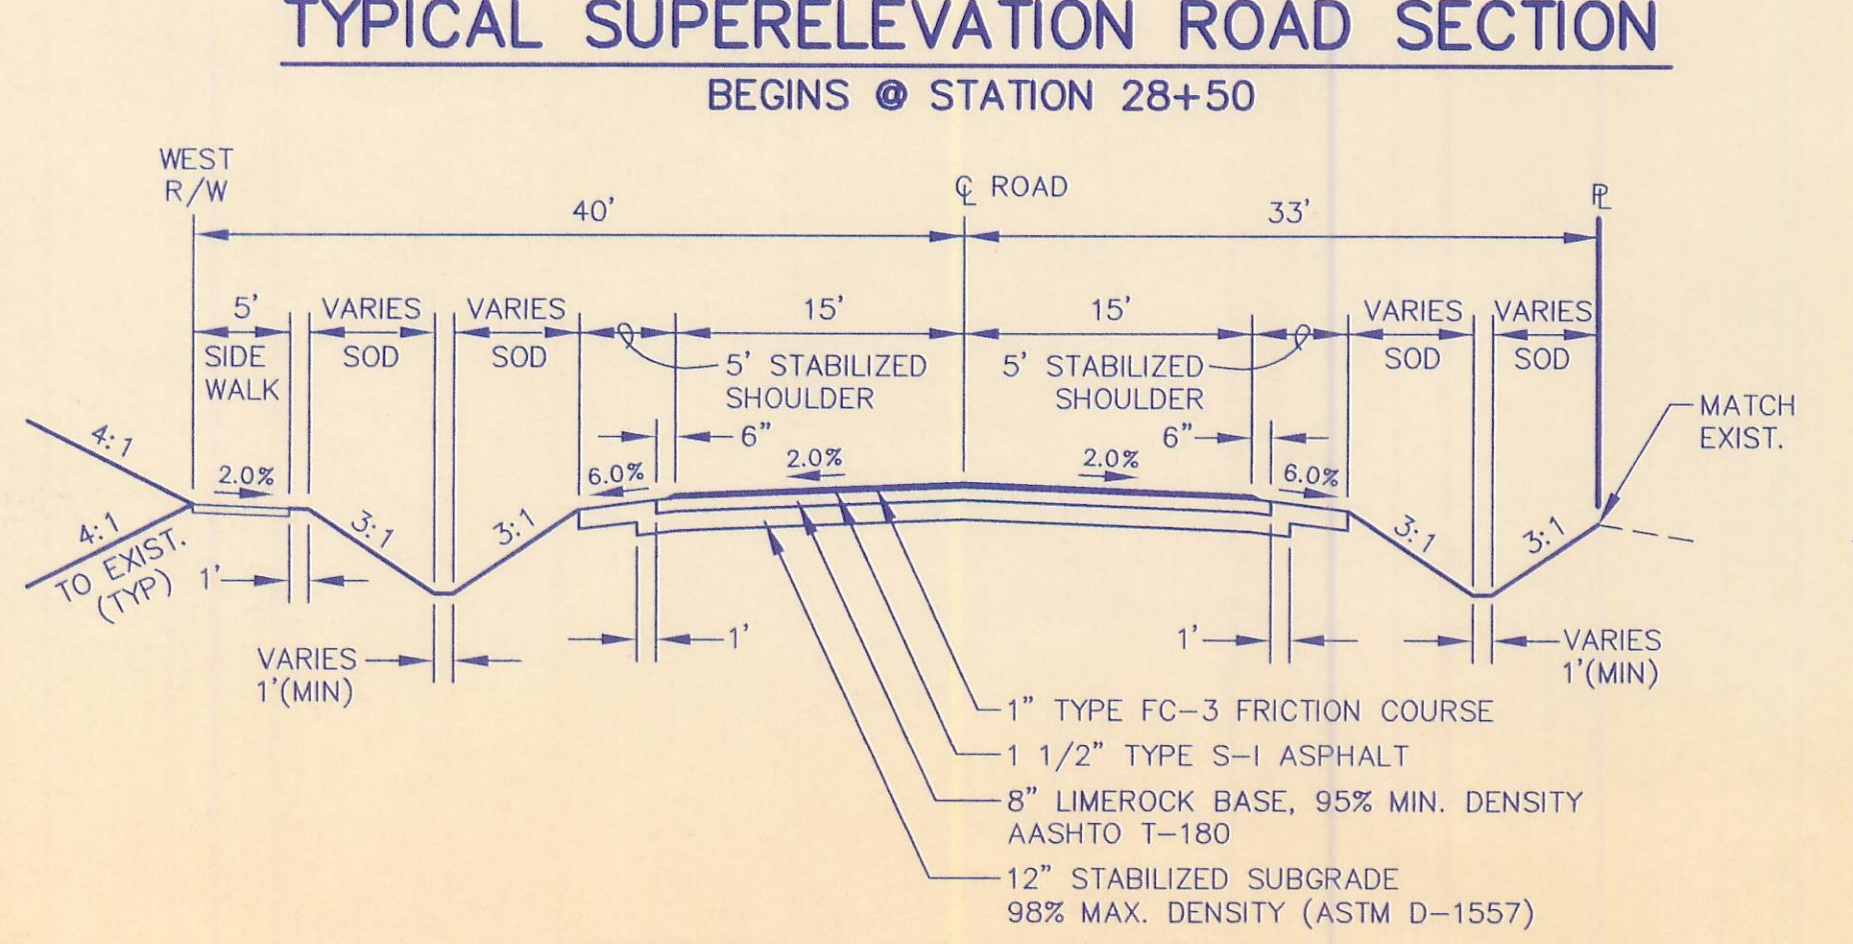

TYPICAL ROAD SECTION

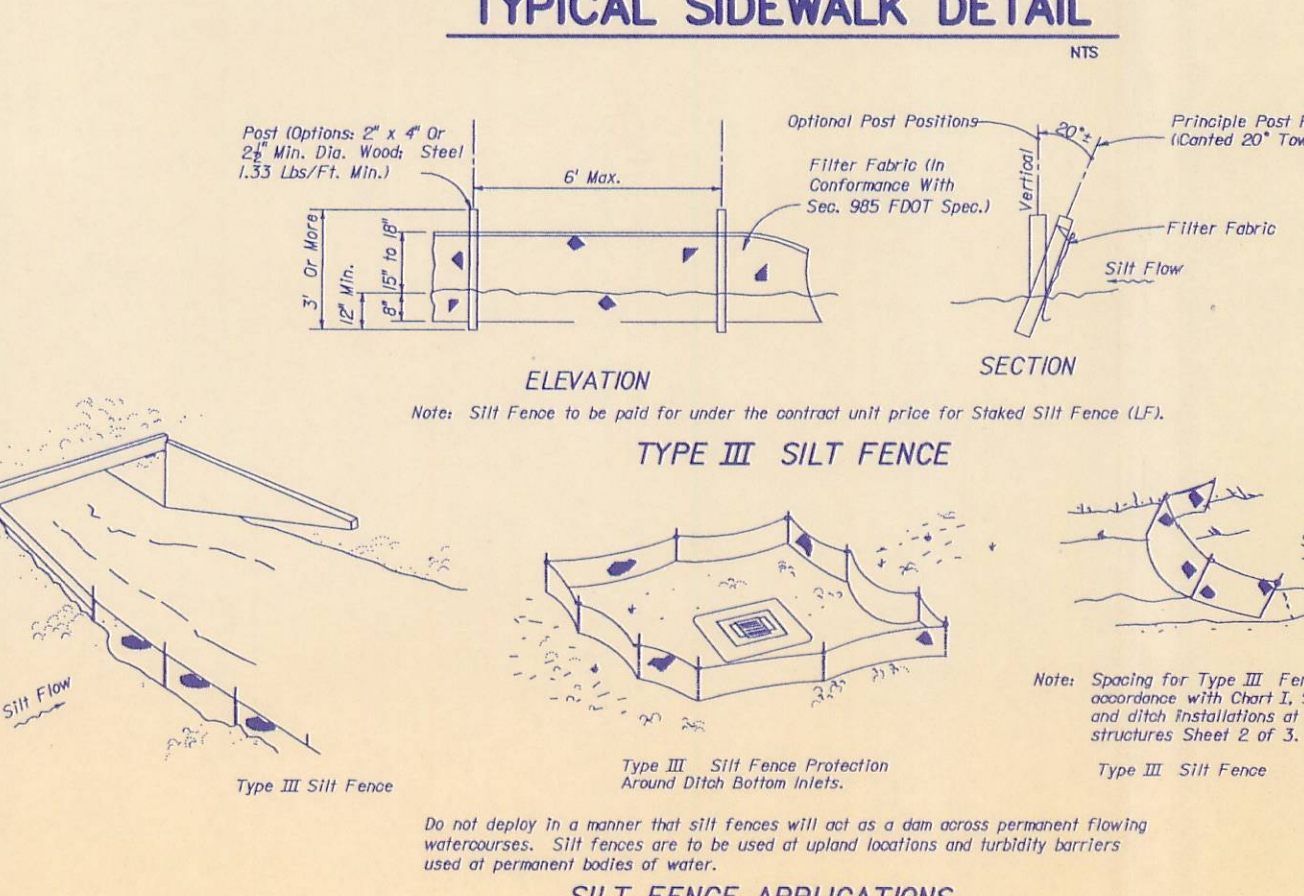

SILT FENCE APPLICATIONS

REFERENCED DETAILS FROM FOOT ROADWAY AND TRAFFIC DESIGN STANDARD

INDEX NO.	SHEET TITLE
102	BALED HAY OR STRAW BARRIERS AND SILT FENCES
103	TURBIDITY BARRIERS
200	STRUCTURE BOTTOMS TYPE I AND P
201	SUPPLEMENTARY DETAILS FOR MANHOLES AND INLETS
232	TYPE C INLET
233	TYPE F INLET
273	SIDE DRAIN MITERED END SECTION*
280	MISCELLANEOUS DRAINAGE DETAILS
600-860	MAINTENANCE OF TRAFFIC

*NOTE: ALL MITERED END SECTIONS INTO DRY RETENTION AREAS SHALL BE CHILDPROOFED WITH MAXIMUM OPENINGS BETWEEN BARS OF 4 1/2 INCHES.

1" TYPE FC-3 FRICTION COURSE
1 1/2" TYPE S-1 ASPHALT
8" LIMEROCK BASE, 95% MIN. DENSITY AASHTO T-180
12" STABILIZED SUBGRADE
98% MAX. DENSITY (ASTM D-1557)

DONALD W. MCINTOSH ASSOCIATES, INC.
ENGINEERS PLANNERS SURVEYORS
2200 PARK AVENUE NORTH, WINTER PARK, FLORIDA 32789 (407) 644-4068

MERRY ROAD
LAKE COUNTY, FLORIDA

NOTES, SPECIFICATIONS & DETAILS

DESIGNED BY: ET DATE: 4-19-96
CHECKED BY: MEW DATE: 4-19-96
SCALE: AS SHOWN
JOB NUMBER: 95198
NO. DESCRIPTION

SHEET TITLE: NOTES, SPECS. & DETAILS
SUBMITTAL TO: LOCAL C/D/M/D, OTHER:
VOID DATE: