

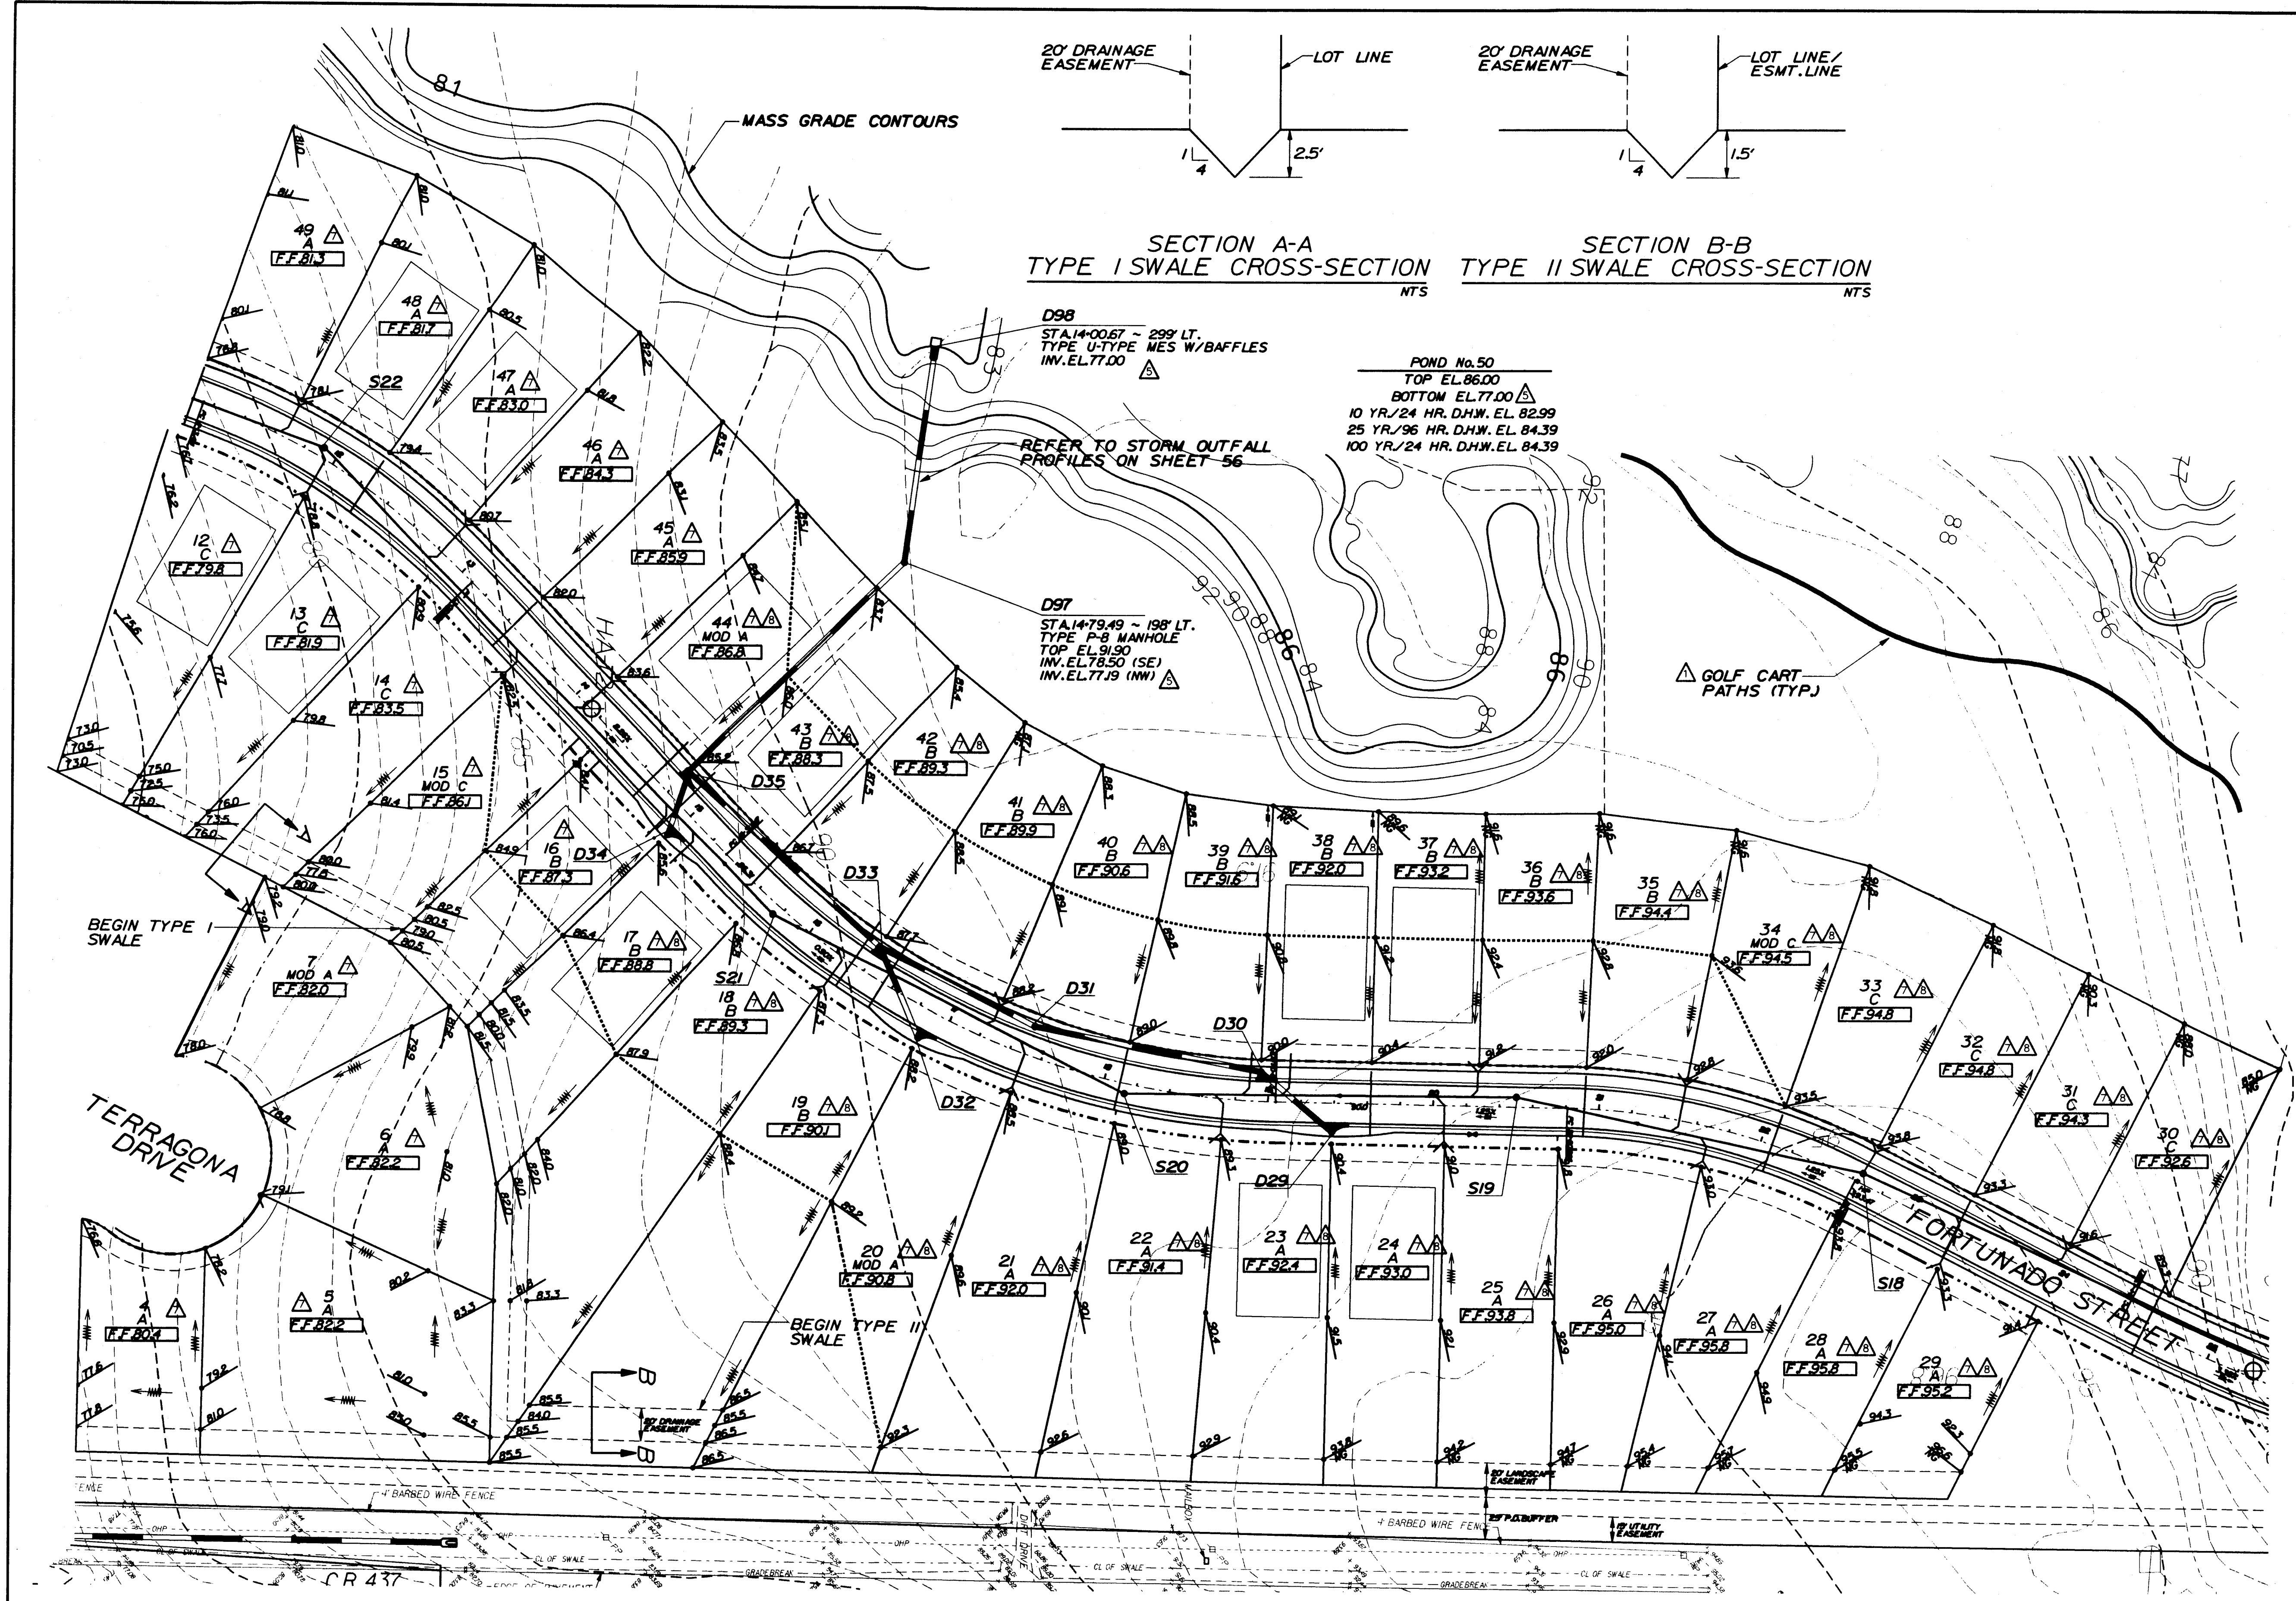


**LEGEND**

DESCRIPTION	EXISTING	PROPOSED
STORM SEWER SYSTEM		
CONTOUR		
DIRECTION OF SURFACE FLOW		
PROPERTY BOUNDARY		
FUTURE R/W		
DRAINAGE BASIN LINE		
FUTURE STORM CONSTRUCTION		
DRAINAGE STRUCTURE (SEE SHEET 15 OF 16 FOR STRUCTURE TYPE)		
PROPOSED PIPE NUMBER (SEE SHEET 15 OF 16 FOR LENGTH, SIZE & SLOPE)		
PROPOSED WEIR		

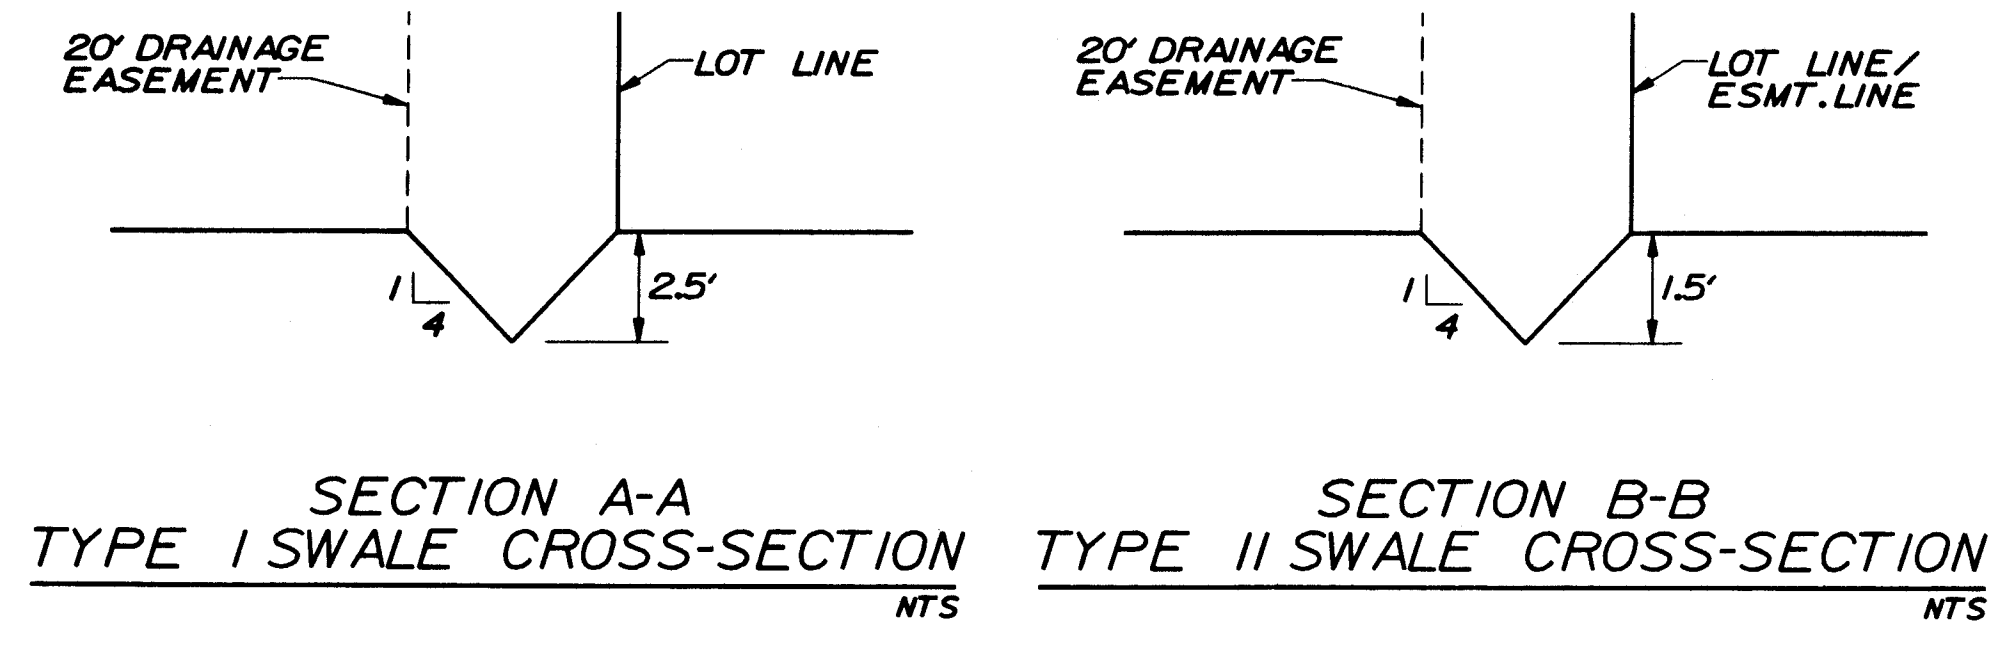

**REVISED**  
THIS SUPERCEDES ALL  
PREVIOUS DRAWINGS.

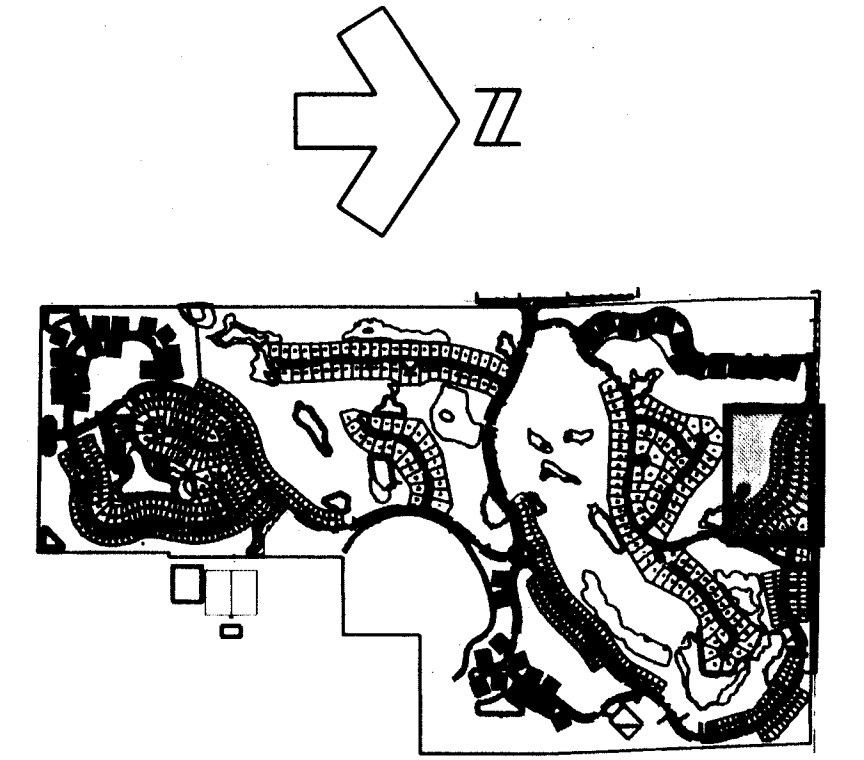

KEYMAP

**REVISIONS**

DATE	BY	DESCRIPTION	DATE	BY	DESCRIPTION
06/06/03	NLE	REVISED FFE AND LOT GRADES			
10-29-02	NLE	REVISED FFE AND LOT GRADES			
7-23-02	NLE	CONSTRUCTION MODIFICATION			
4-22-02	NLE	REVISED PER AGENCY COMMENTS			



**BOWYER-SINGLETON & ASSOCIATES, INCORPORATED**  
ENGINEERING • PLANNING • SURVEYING • ENVIRONMENTAL  
520 SOUTH MAGNOLIA AVENUE • ORLANDO, FLORIDA 32801  
407-843-5120 • FAX 407-649-8664  
ENGINEERING BUSINESS • 1221

LAKE COUNTY FLORIDA

**LOT & BLOCK GRADING**  
SORRENTO HILLS - PHASE I

DATE	10-04-01
DESIGNED	NLE
CHECKED	DJM
SCALE	1"=50'
PROJECT NO.	SH2
FILE NAME	SH2L65.DGN
SHEET	12 OF 62

Reinarda Malve, P.E.  
Florida Reg. Number 31588

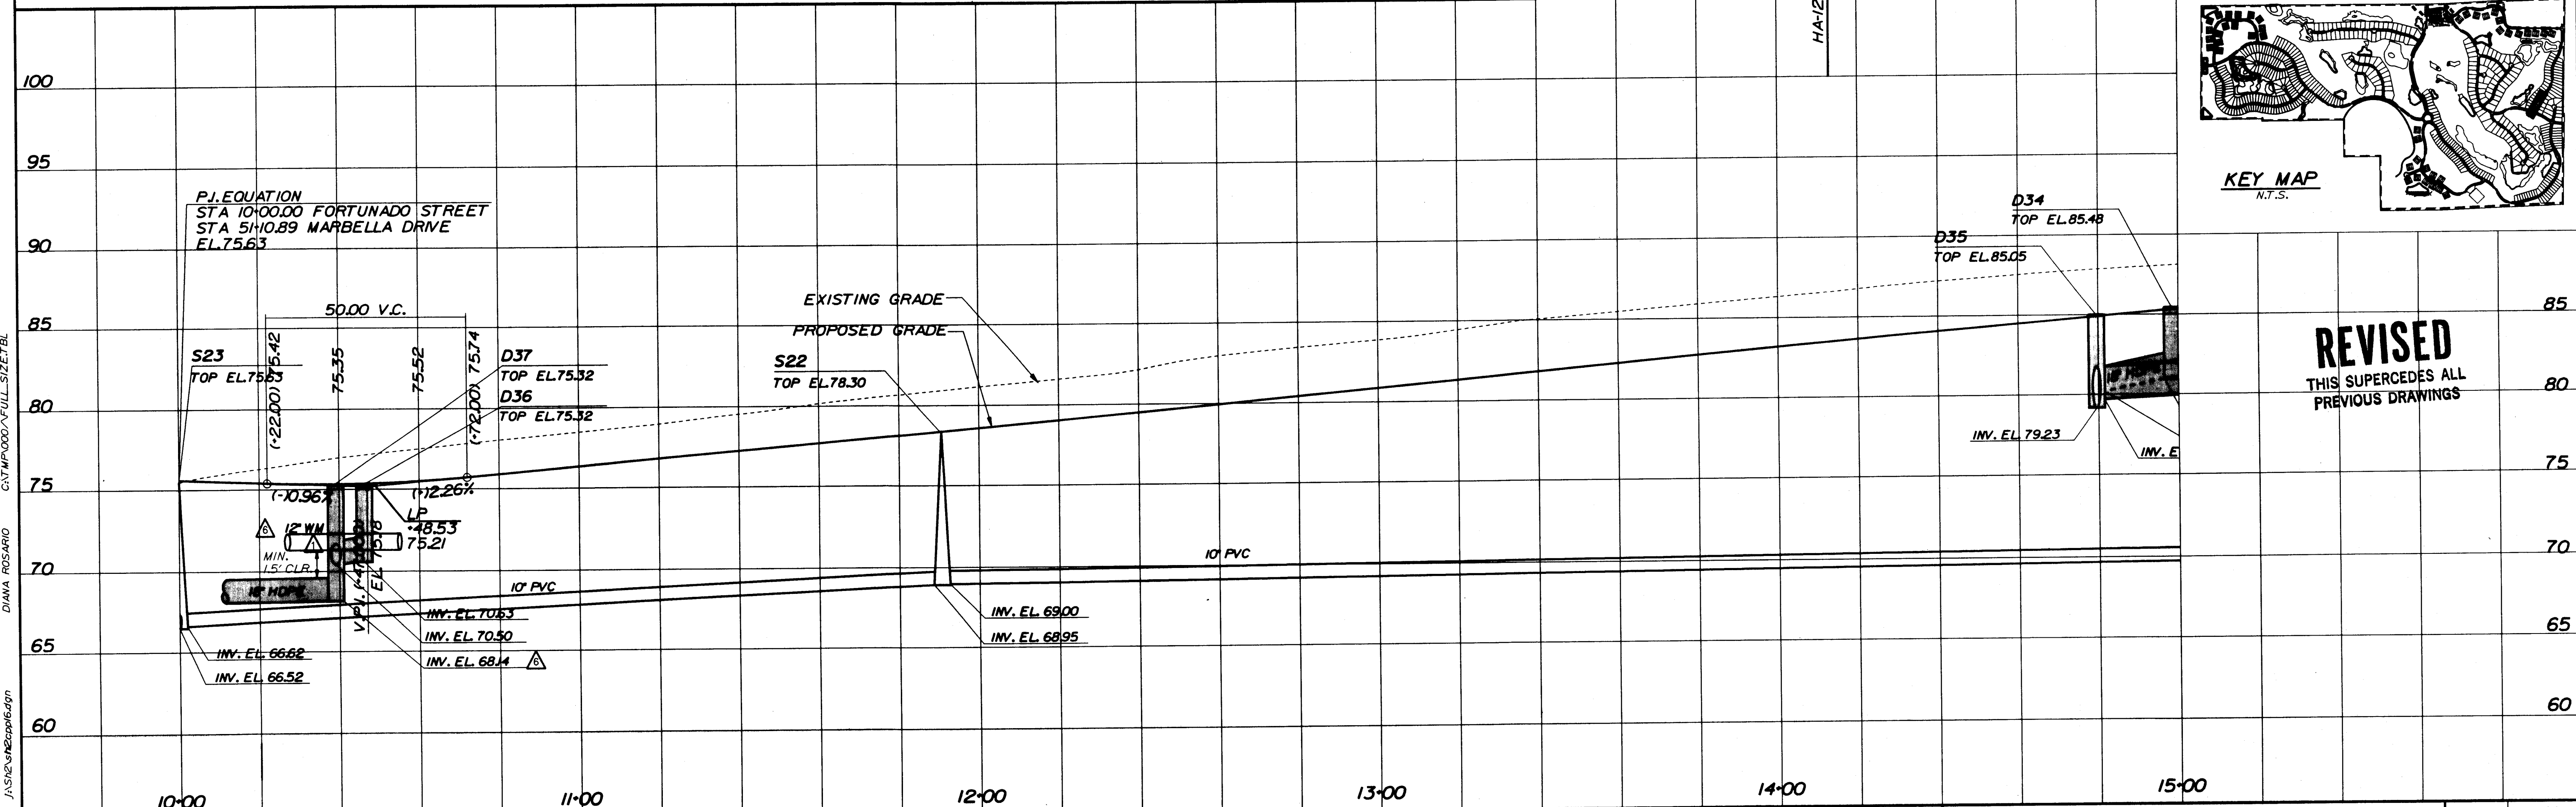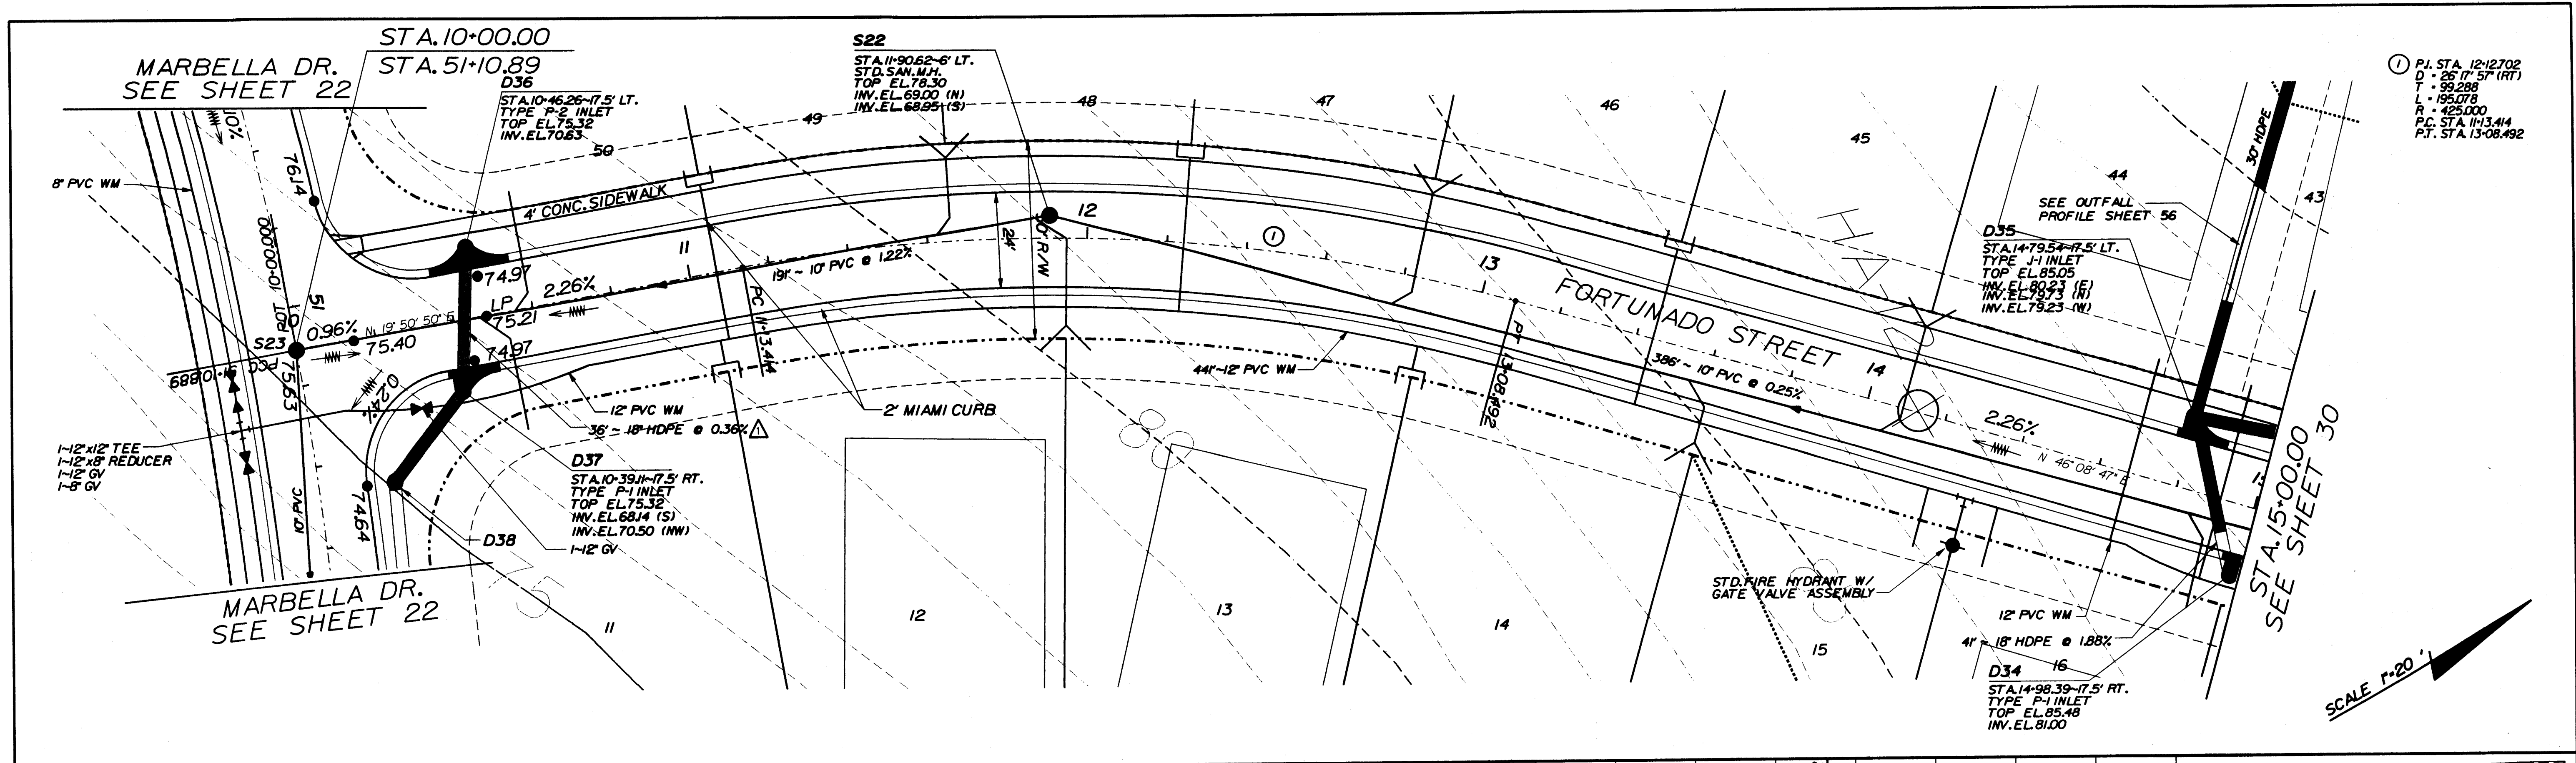

REVISIONS				SUBMITTAL	DATE
DATE	BY	DESCRIPTION	DATE	BY	DESCRIPTION
06/06/03	NLE	REVISED FOR LOT GRADING			
08/21/02	NLE	REVISED PER FDEP COMMENTS			
4-22-02	NLE	REVISED PER AGENCY COMMENTS			

DATE	06-08-01
DESIGNED	NLE
CHECKED	DJM
SCALE	HORIZ 1"=20' VERT 1"=5'
PROJECT NO.	SH2
FILE NAME	SH2CPR16.DGN
SHEET	29 OF 62

**BOWYER-SINGLETON & ASSOCIATES, INCORPORATED**  
 ENGINEERING • PLANNING • SURVEYING • ENVIRONMENTAL  
 520 SOUTH MAGNOLIA AVENUE • ORLANDO, FLORIDA 32801  
 407-843-5120 • FAX 407-649-8664  
 ENGINEERING BUSINESS • 1221




LAKE COUNTY FLORIDA

**FORTUNADO STREET**  
 STA. 10+00.00 ~ STA. 15+00.00  
 SORRENTO HILLS - PHASE I

DATE: 06-08-01  
 DESIGNED: NLE  
 CHECKED: DJM  
 SCALE: HORIZ 1"=20'  
 VERT 1"=5'  
 PROJECT NO.: SH2  
 FILE NAME: SH2CPR16.DGN  
 SHEET: 29 OF 62

6/13/2003 16:04:03 JAS:24-18200016.dgn DIANA ROSARIO C:\TMP\0001\FULL\SIZE\T.BL



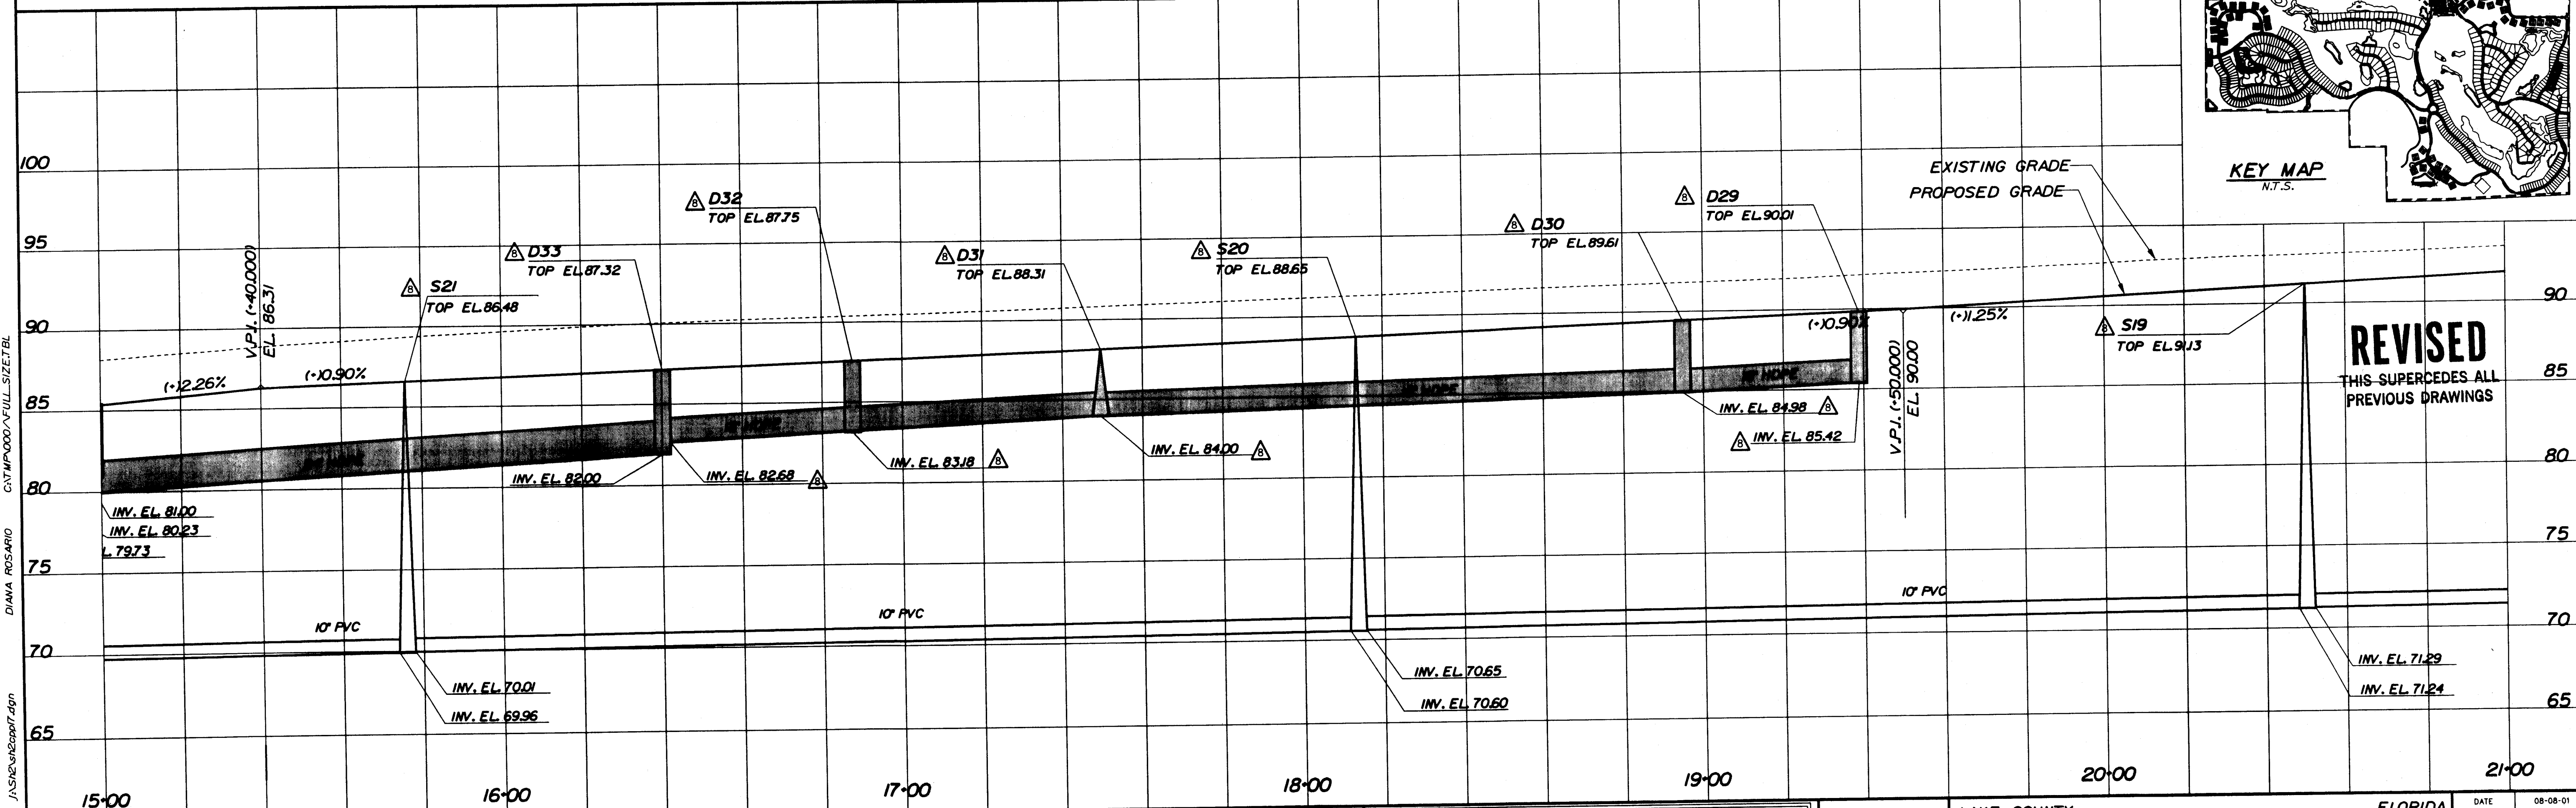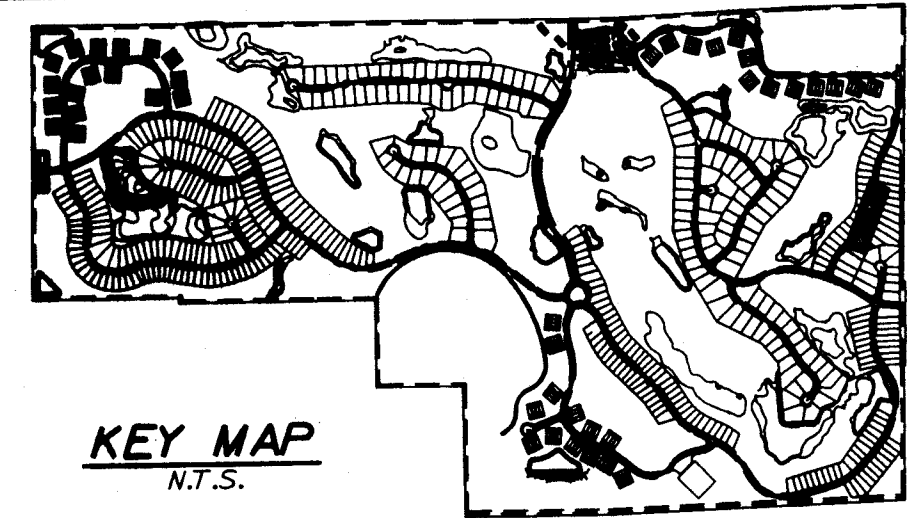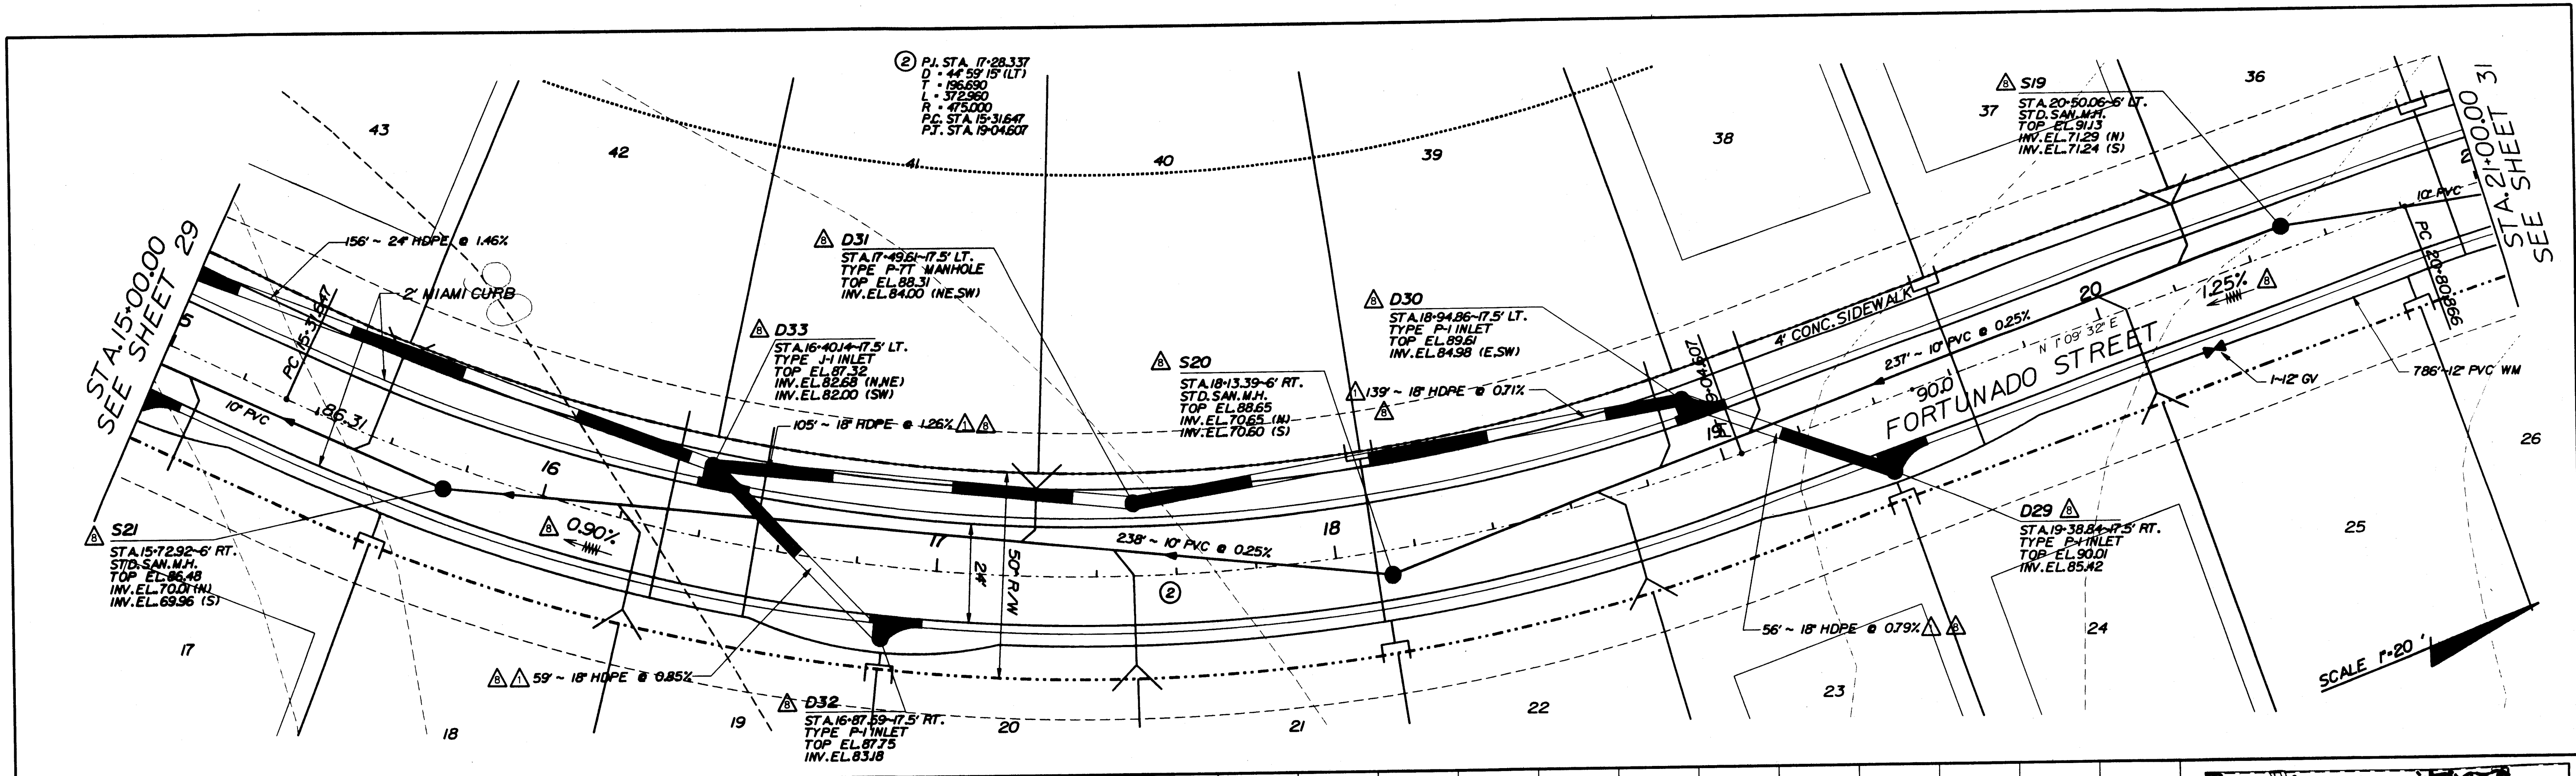

REVISIONS							
DATE	BY	DESCRIPTION	DATE	BY	DESCRIPTION	DATE	BY
			6-06-03	NLE	REVISED FOR LOT GRADING		
			4-22-02	NLE	REVISED PER AGENCY COMMENTS		

SUBMITTAL	DATE
CITY OR COUNTY	
W.M.D.	
FINAL APPROVAL	
BD SET	
AS-BUILT	




**BOWYER-SINGLETON & ASSOCIATES, INCORPORATED**  
 ENGINEERING • PLANNING • SURVEYING • ENVIRONMENTAL  
 520 SOUTH MAGNOLIA AVENUE • ORLANDO, FLORIDA 32801  
 407-843-5120 • FAX 407-849-8664  
 ENGINEERING BUSINESS #1221

Donal J. Hayes  
 Florida Reg. Number 48895  
 P.E.

LAKE COUNTY FLORIDA  
**FORTUNADO STREET**  
 STA. 15+00.00 ~ STA. 21+00.00  
 SORRENTO HILLS - PHASE 1

DATE	DESCRIPTION
08-08-01 <td>DESIGNED NLE</td>	DESIGNED NLE
	CHECKED DJH
	SCALE 1"=20'
	PROJECT NO. SH2
	FILE NAME SH2CPR17.DGN
	SHEET 30 OF 62

6/13/2003 16:26:43 JAS20202097L401 DIANA ROSARIO C:\MP\000\FULL\SIZE\TEL

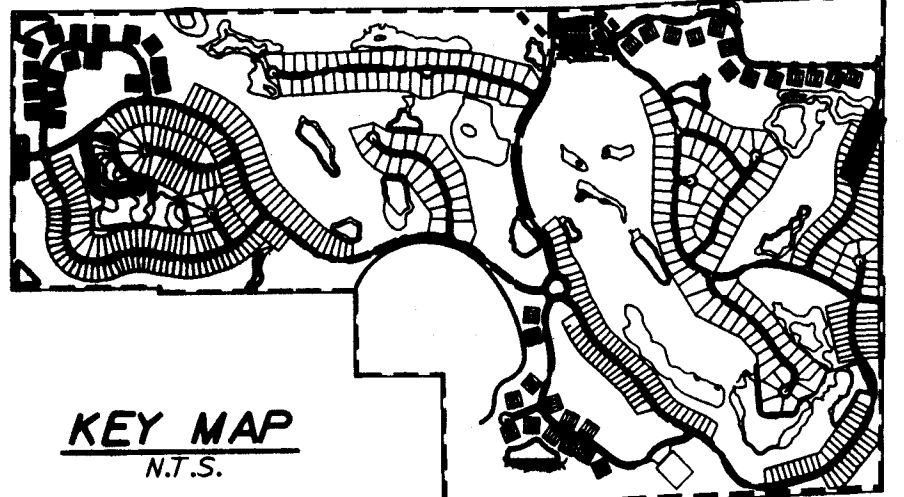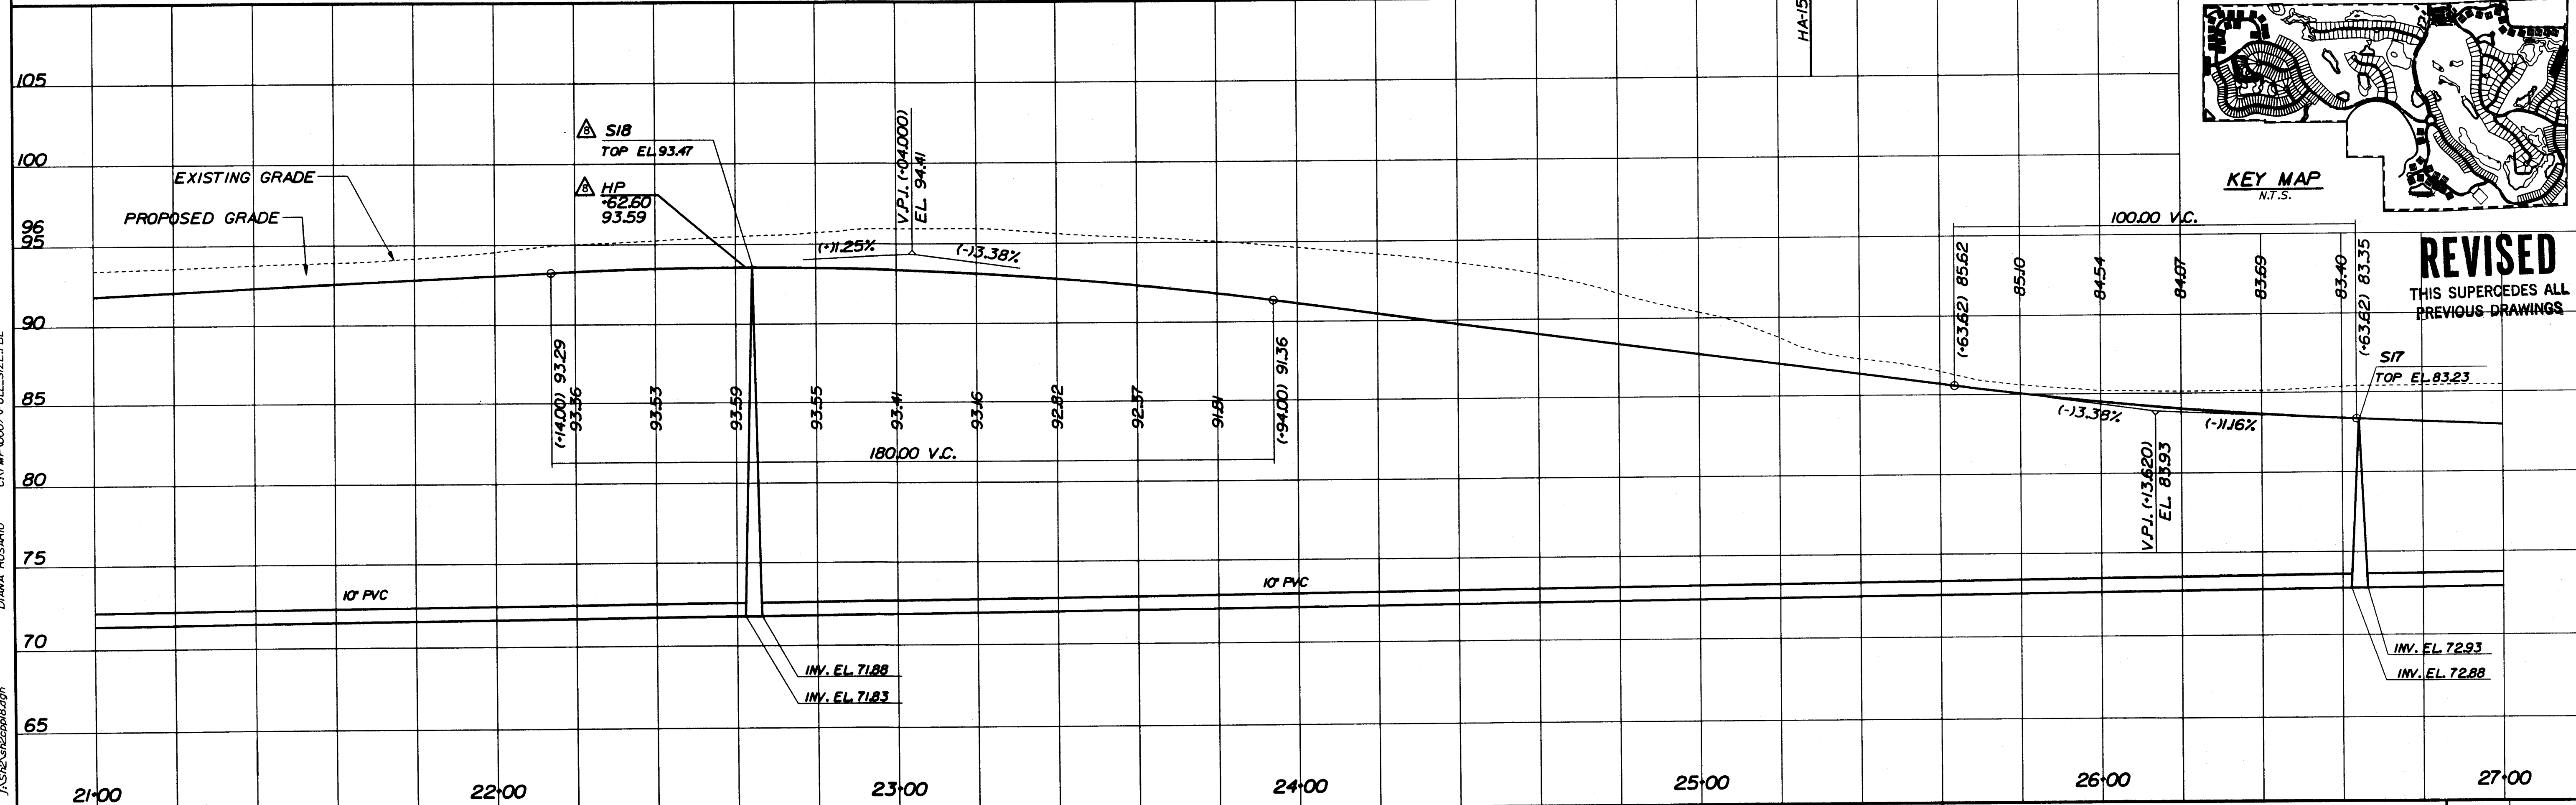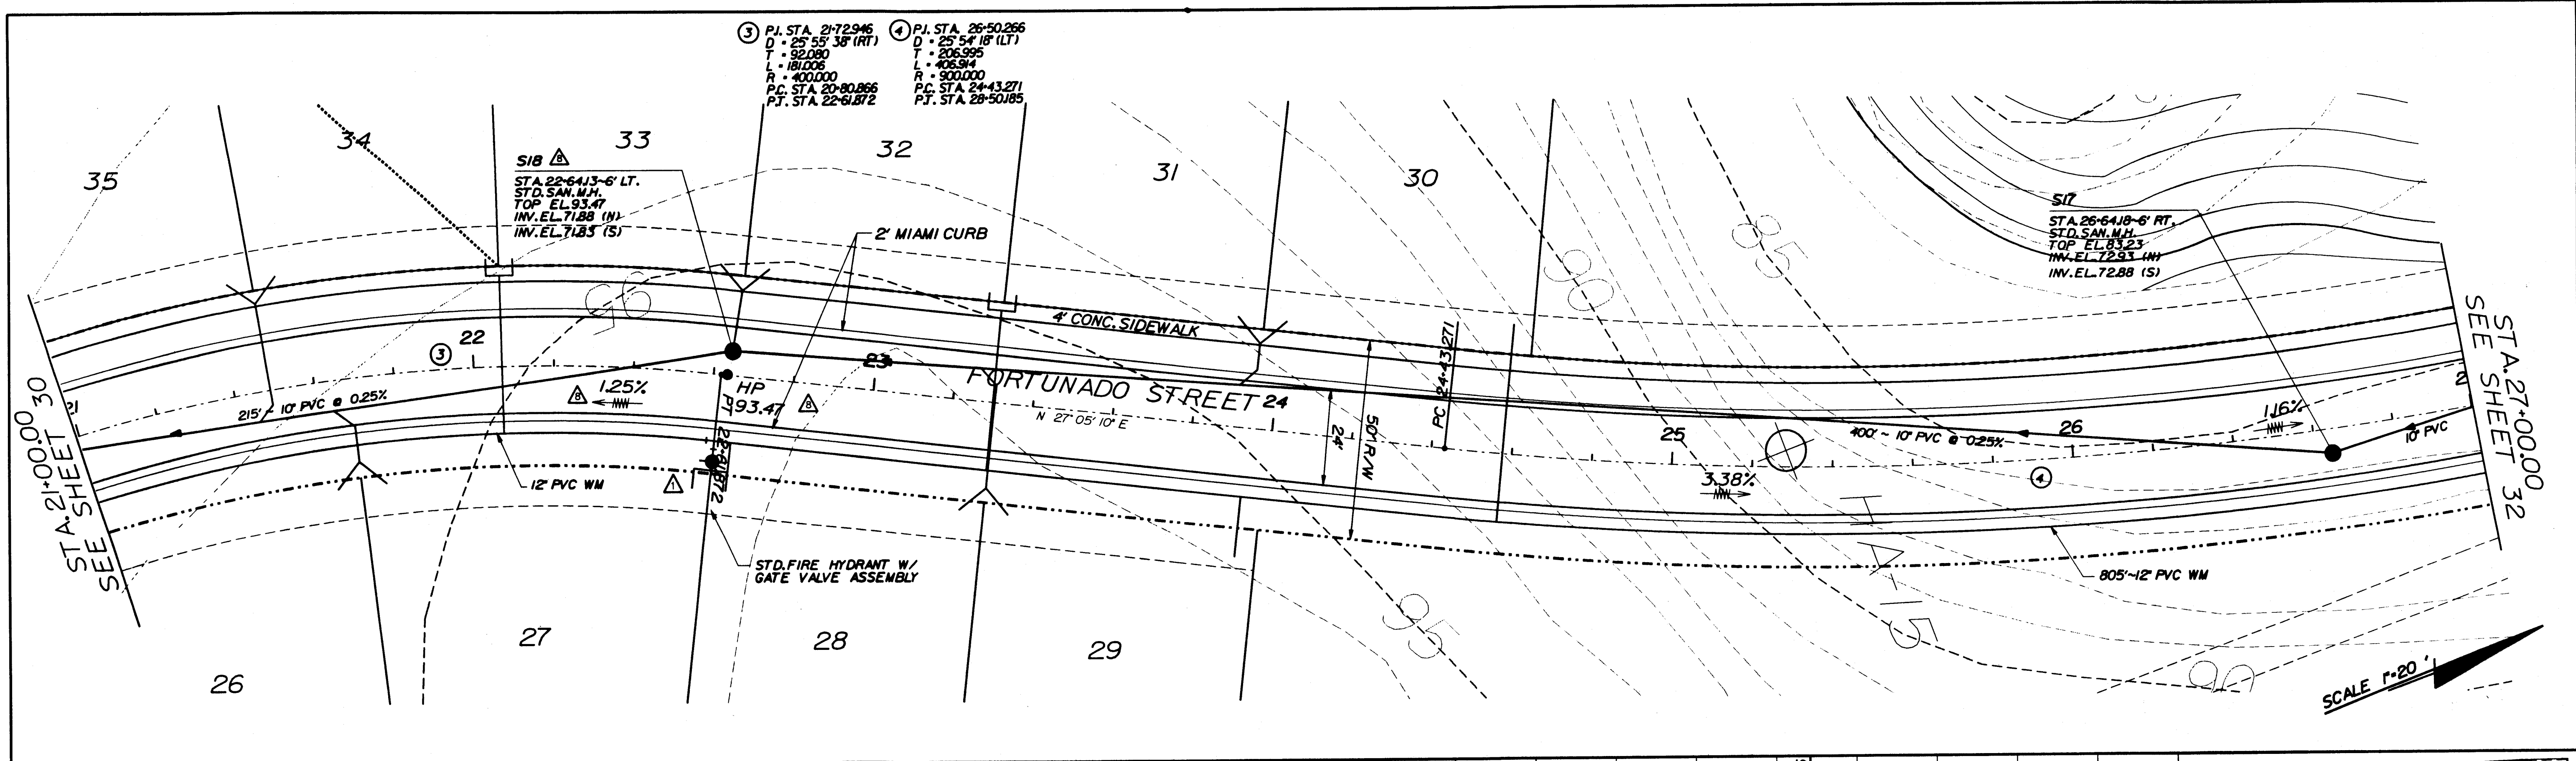

**REVISED**  
THIS SUPERCEDES ALL  
PREVIOUS DRAWINGS

REVISIONS					
DATE	BY	DESCRIPTION	DATE	BY	DESCRIPTION
6-06-03	NLE	REVISED FOR LOT GRADING			
4-22-02	NLE	REVISED PER AGENCY COMMENTS			


**BOWYER-SINGLETON & ASSOCIATES, INCORPORATED**  
ENGINEERING • PLANNING • SURVEYING • ENVIRONMENTAL  
520 SOUTH MAGNOLIA AVENUE • ORLANDO, FLORIDA 32801  
407-843-5120 • FAX 407-649-8664  
ENGINEERING BUSINESS \*1221

LAKE COUNTY FLORIDA  
**FORTUNADO STREET**  
STA. 21+00.00 ~ STA. 27+00.00  
SORRENTO HILLS - PHASE I


DATE	08-08-01
DESIGNED	NLE
CHECKED	DJM
SCALE	HORIZ. 1"=20' VERT. 1"=5'
PROJECT NO.	SH2
FILE NAME	SH2CPR18.DGN
SHEET	31 OF 62

6/13/2003 16:09:24 JASHEW@bentley.com DIANA ROSARIO CNTMP000\FULLSIZE\TEL



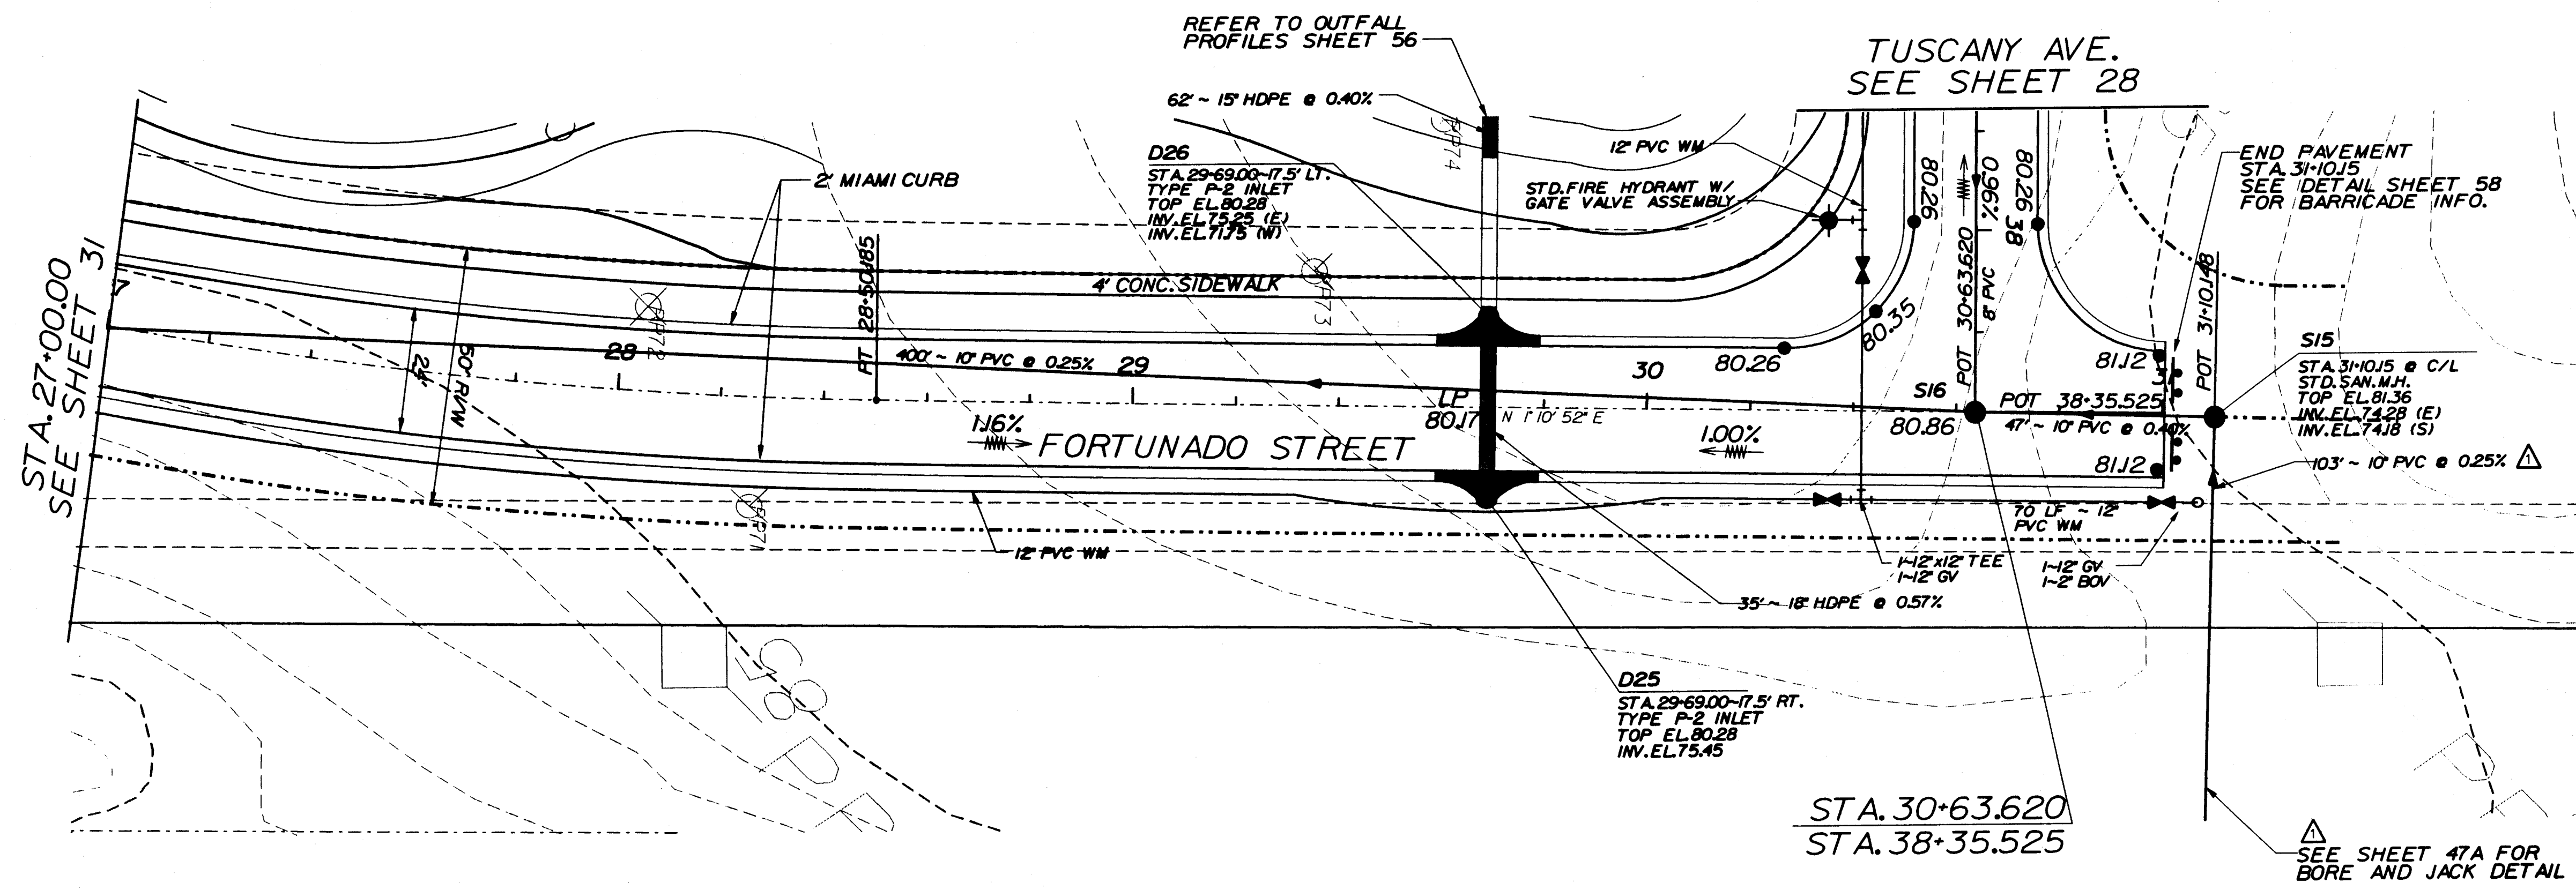


SCALE 1"=20'

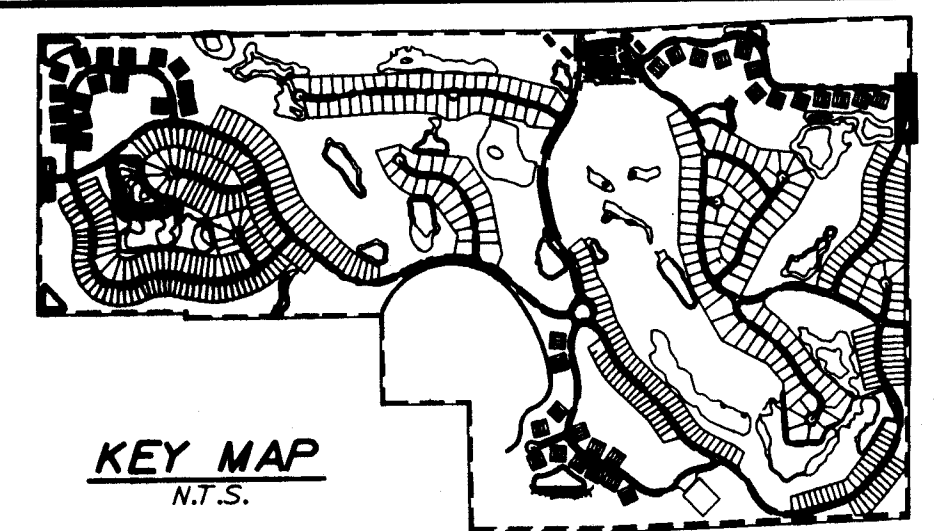

KEY MAP N.T.S.

**REVISED**  
THIS SUPERCEDES ALL PREVIOUS DRAWINGS

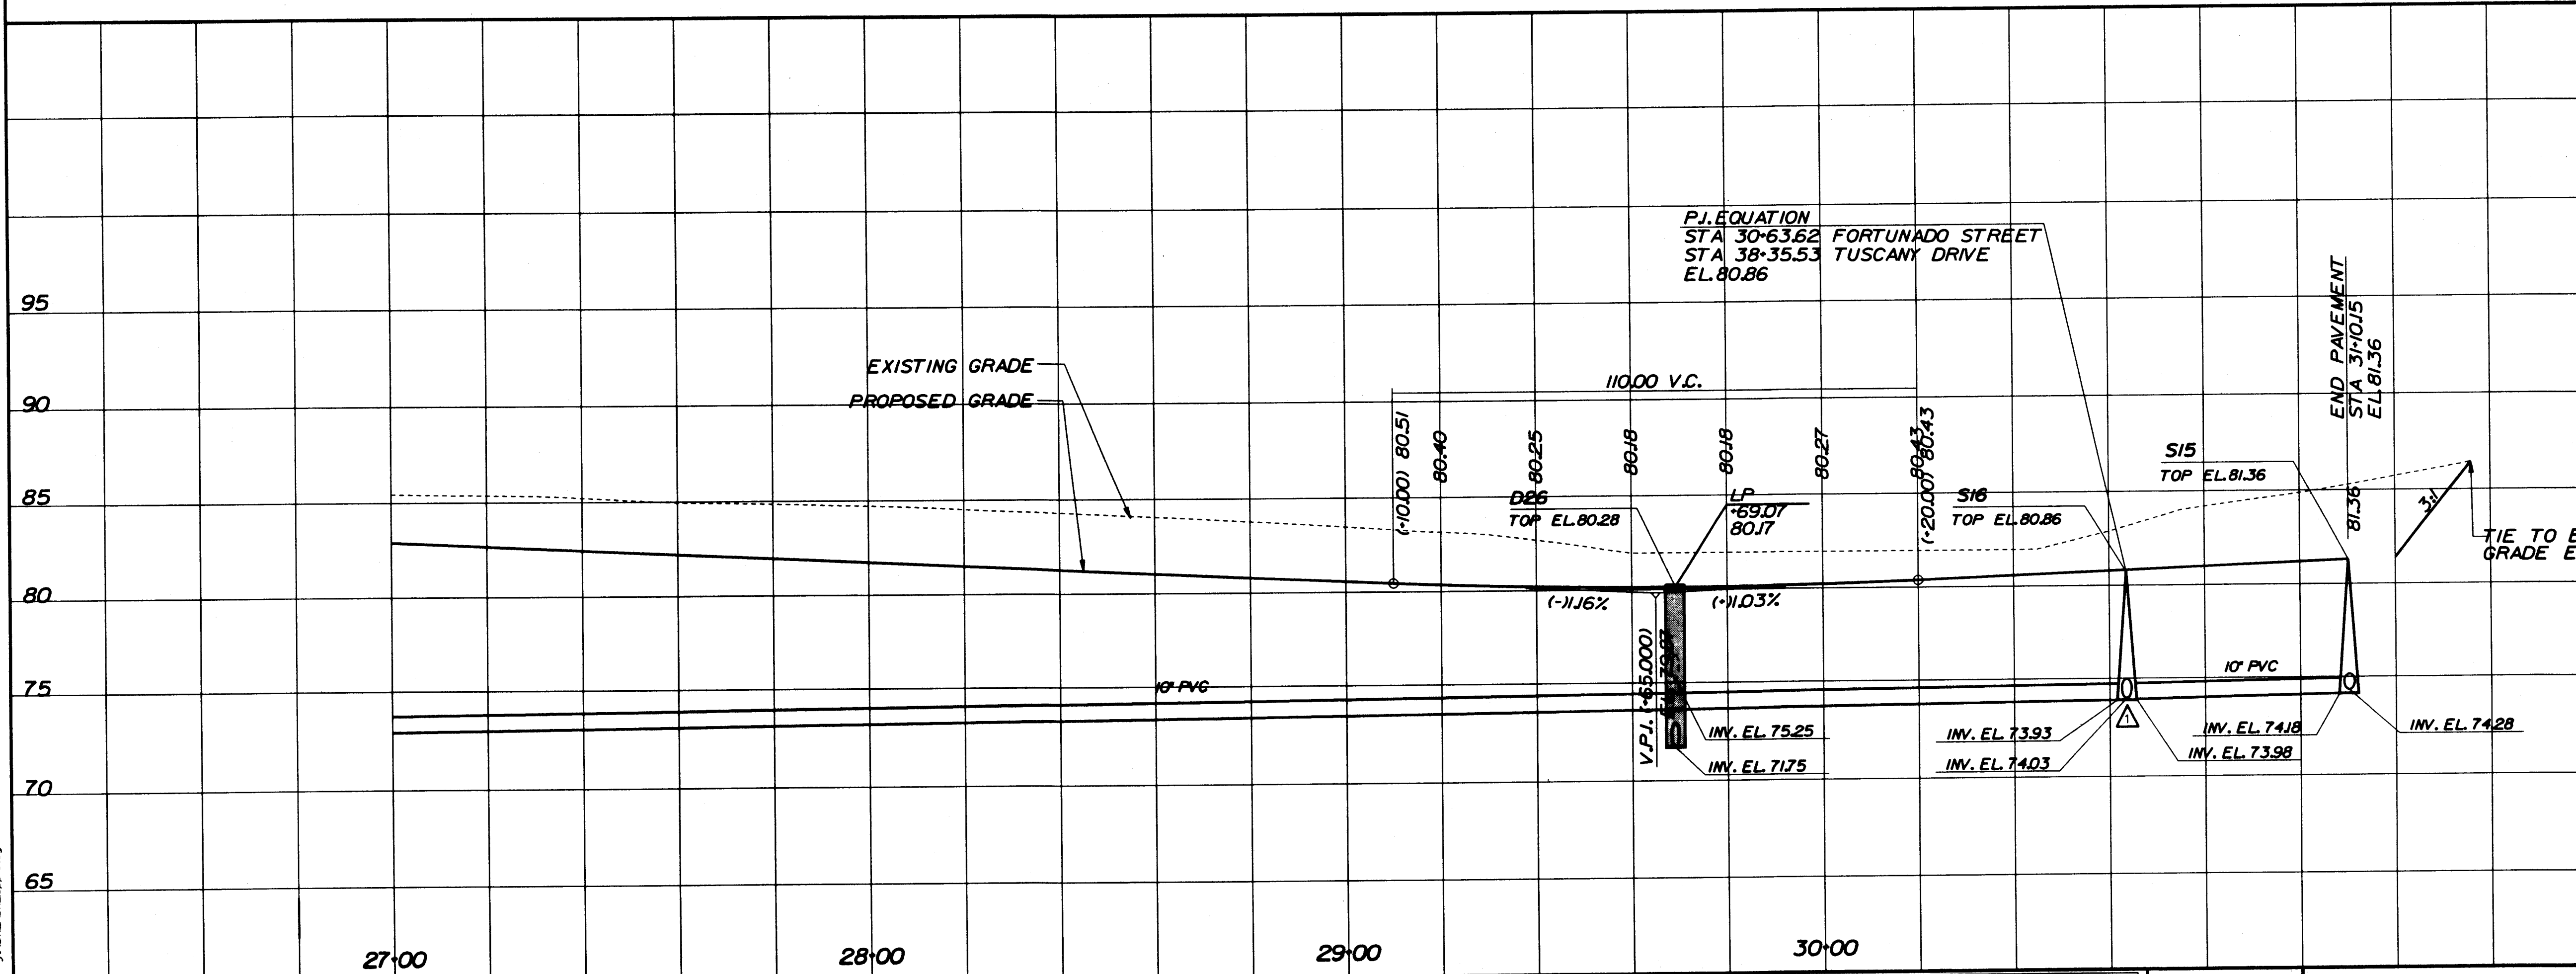

6/13/2003 16:03:34 JAS2424220999497 DIANA ROSARIO C:\TMP\000\FULL\SIZE.TBL

REVISIONS							
DATE	BY	DESCRIPTION	DATE	BY	DESCRIPTION	DATE	BY
6-06-03	NLE	REVISED FOR LOT GRADING					
4-22-02	NLE	REVISED PER AGENCY COMMENTS					

SUBMITTAL	DATE
CITY OR COUNTY	
W.M.D.	
FINAL APPROVAL	
BD SET	
AS-BUILT	

**BOWYER-SINGLETON & ASSOCIATES, INCORPORATED**  
 ENGINEERING • PLANNING • SURVEYING • ENVIRONMENTAL  
 520 SOUTH MAGNOLIA AVENUE • ORLANDO, FLORIDA 32801  
 407-843-5120 • FAX 407-649-8664  
 ENGINEERING BUSINESS #1221

Daniel J. Hayes  
 Florida Reg. Number 48993

LAKE COUNTY FLORIDA  
**FORTUNADO STREET**  
 STA. 27+00.00 ~ STA. 38+35.53  
 SORRENTO HILLS - PHASE 1

DATE	08-08-01
DESIGNED	NLE
CHECKED	DJM
SCALE	HORIZ. 1"=20' VERT. 1"=5'
PROJECT NO.	SH2
FILE NAME	SH2CPP19.DGN
SHEET	32 OF 62

Reinaldo M. ...  
 Florida Reg. Number 31588