


• - Electric valves
• - quick couplers

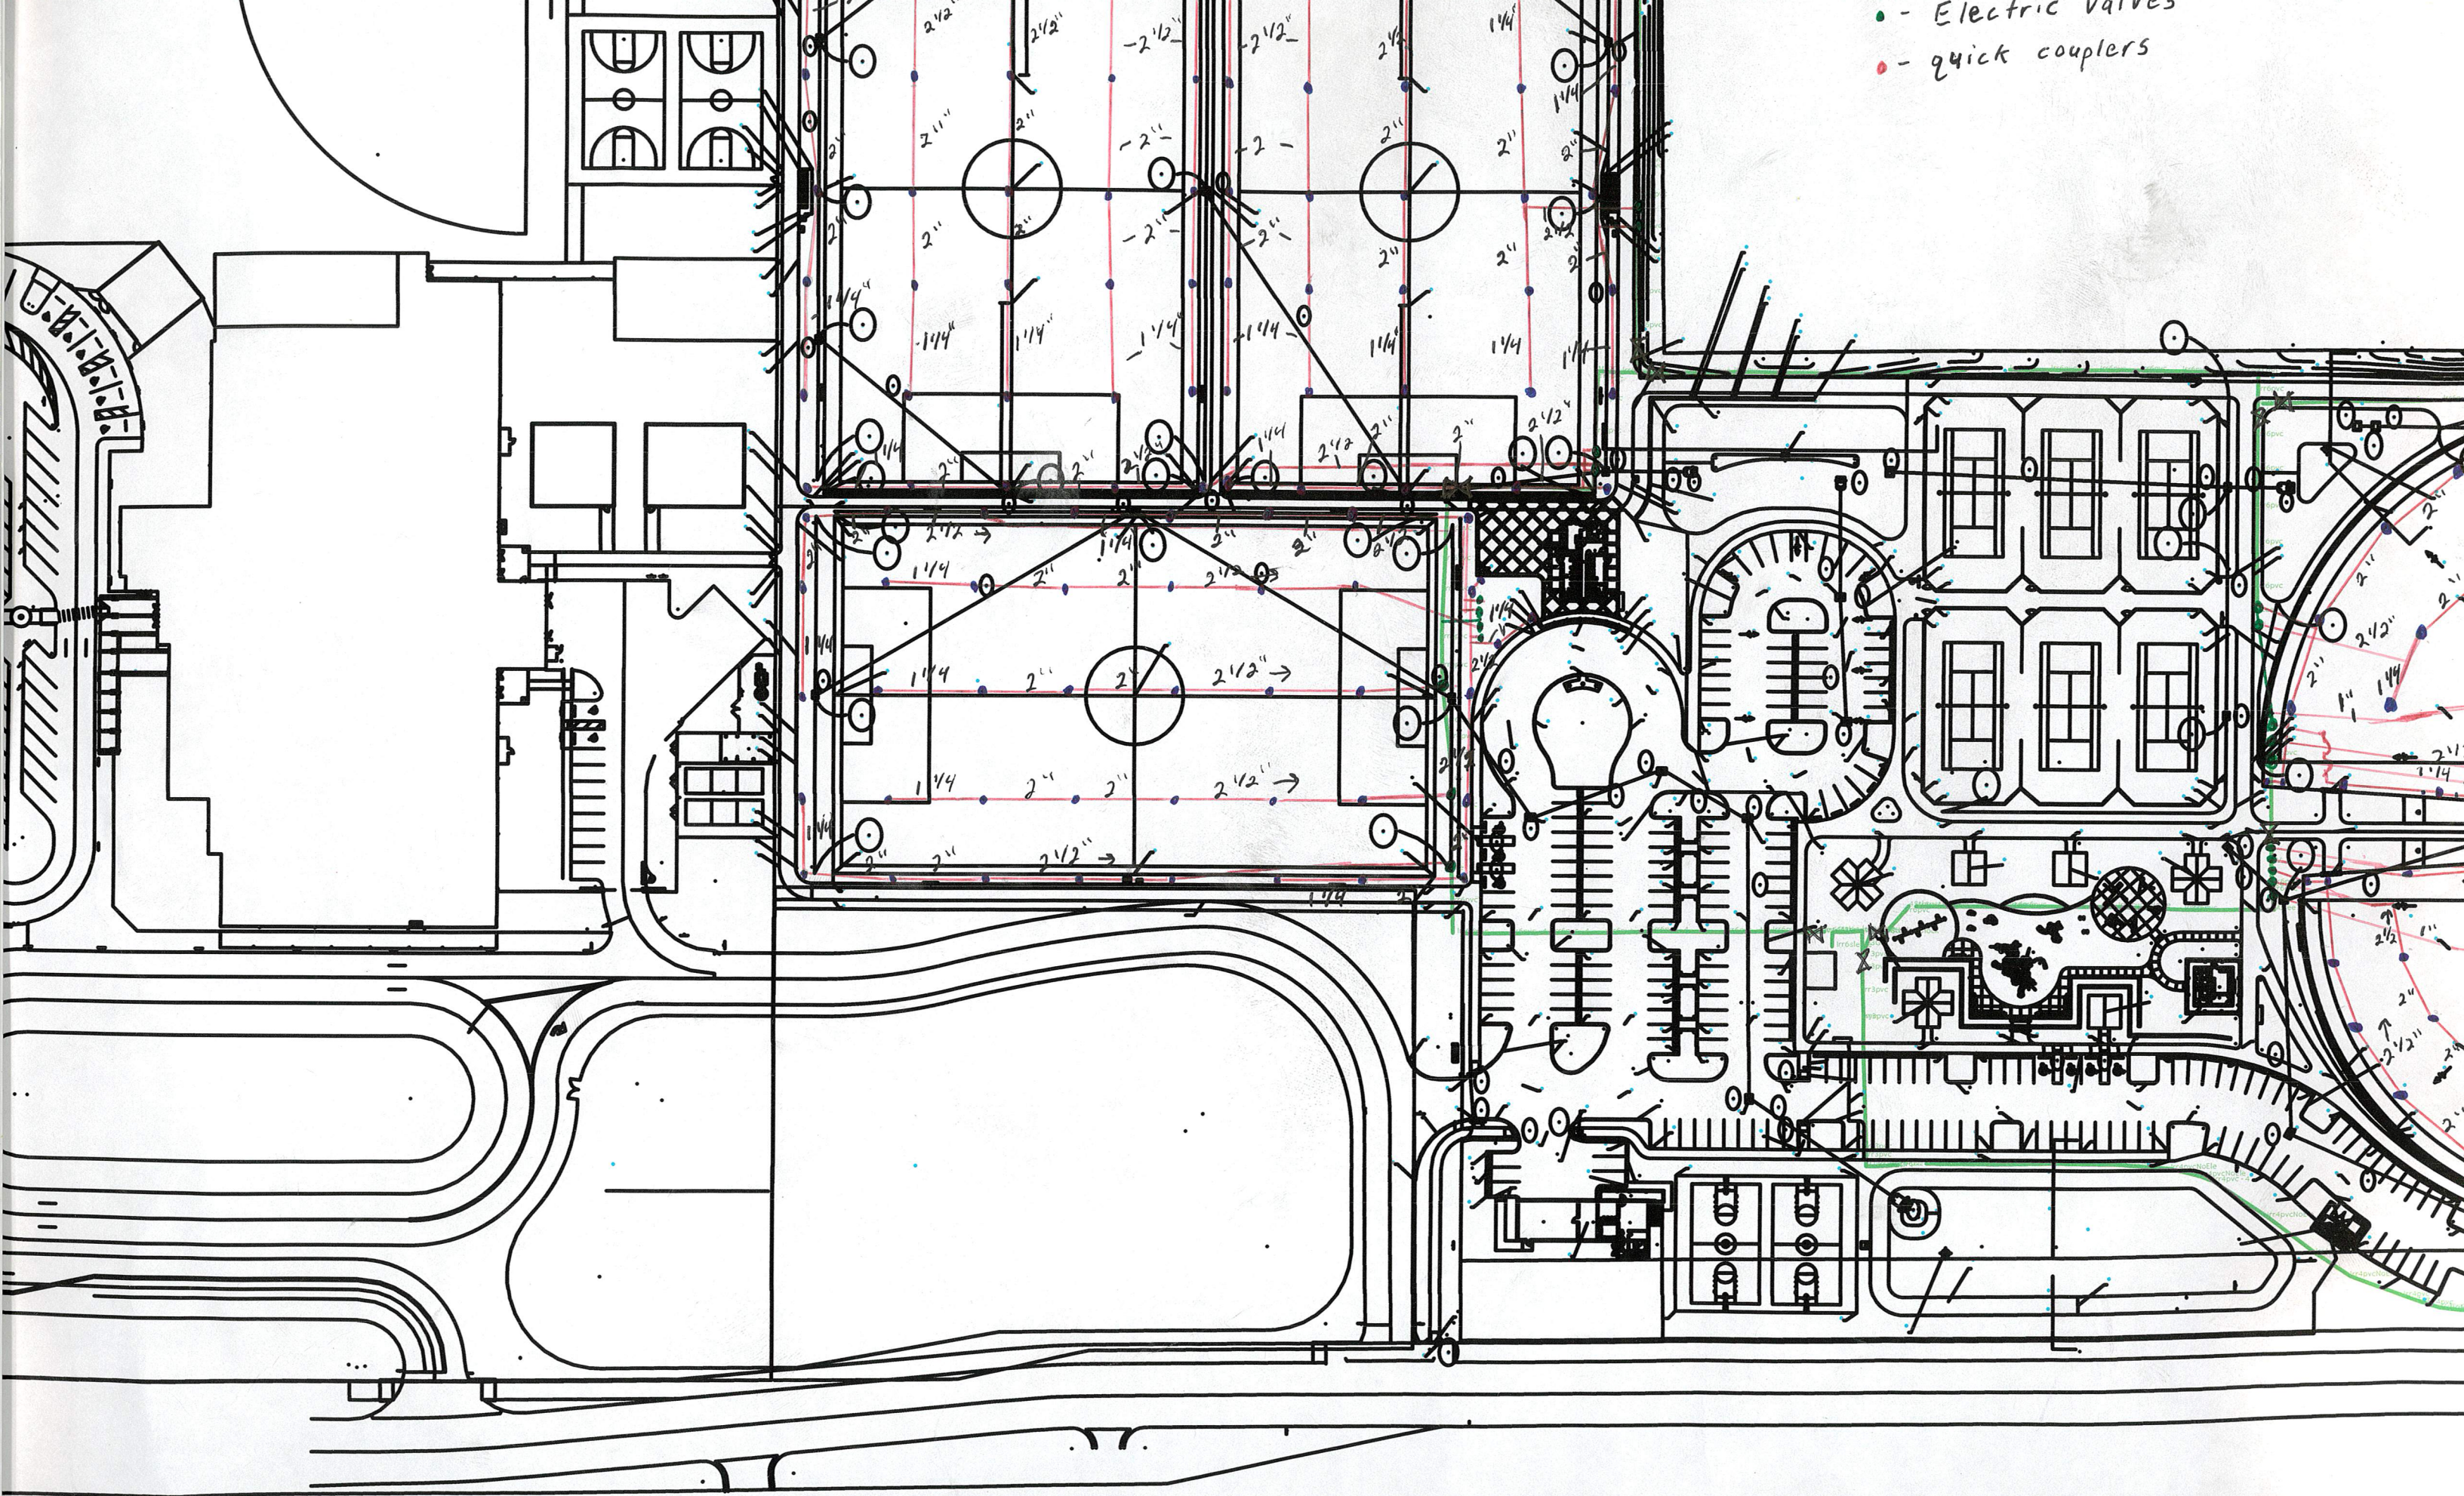

- laterals
- rotors
- Electric valves
- quick couplers

