THIS MAP HAS BEEN COMPILED FROM THE MOST AUTHENTIC INFORMATION AVAILABLE AND NEITHER LAKE COUNTY NOR HUNNICUTT AND ASSOCIATES INC ASSUMES RESPONSIBILITY FOR ERRORS OR OMISSIONS CONTAINED HEREON

8-[illegible]
4-9-08 U
10-7-08 S
2-24-10 U
5-10-10 U
11-18-10 U
8-9-12 U
9-14-12 U

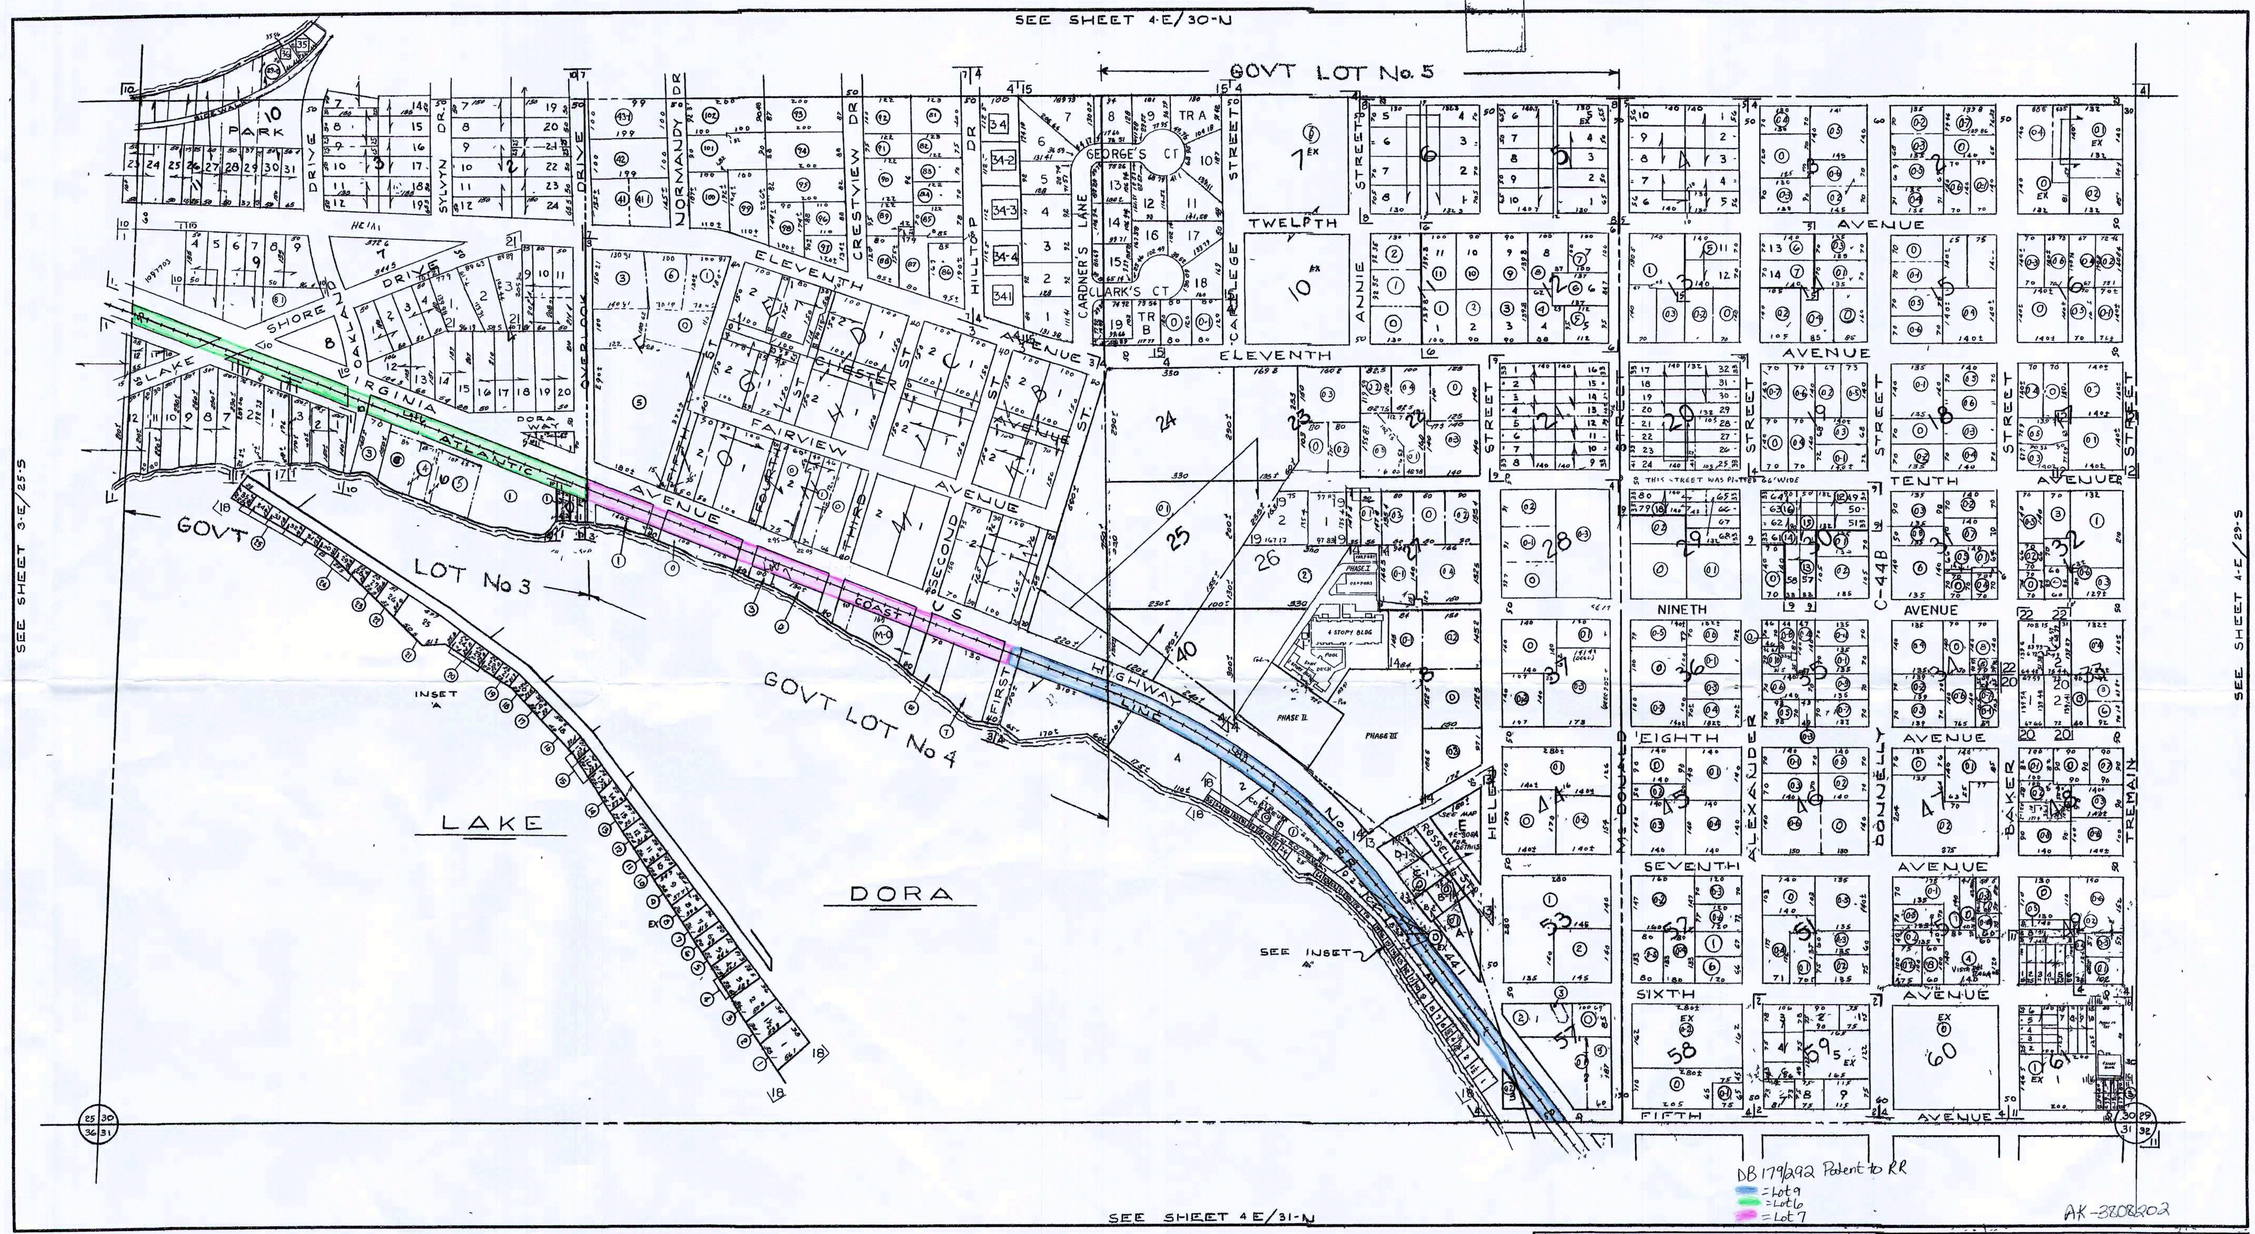

DB 179/292 Patent to RR
= Lot 9
= Lot 6
= Lot 7

AK-3808202

SUBDIVISION INDEX

MOUNT DORA

No	NAME	PB	PG
1	CHAUTAUQUA PARK SUB.	2	30
2	DONNELLY'S SUB	10	56
3.	GARDNER'S SUB	1	76
4.	Mt DORA SUB	3	37, 39, 41, 43
5	NORWOOD SUB	4	55
6	ORANGE HILL SUB	12	39
7	PINE CREST SUB	4	15
8	PORTER'S SUB	9	2
9.	SHORT'S SUB	2	26
10.	SYLVAN SHORES	9	56
11.	TOMPKINS' SUB	5	9
12	DORA ARMS (CONDOMINIUM)	1	58, 59
13	THE SUMMIT (CONDOMINIUM)	1	75-82
14	SUMMIT PLACE (CONDOMINIUM)	1	87-93
15	THE HIGHLANDS OF MT DORA	28	33
16	THE REGENCY VILLAS	ORB 843	1831
17	MASTRONARDI PLACE	39	79
18	SHORE LOTS ON LAKE DORA	4	14
19	SUNSET SETTLE SUB	51	59
20	SWANSON SUB	51	78
21	COFFIELD SUB	~~54~~ ~~55~~	42
22	SUNSHINE CORNER	63	66

AK 3808202

int of old 441/Lakeshore to W. 5th Ave

SCALE 1" = 200

ASSESSMENT MAP
LAKE COUNTY, FLORIDA
COMPILED & DRAWN BY
HUNNICUTT & ASSOCIATES, INC
ST. PETERSBURG, FLORIDA

SECTION S ½ of 30
TOWNSHIP 19-S
RANGE 27-E
COMPILED & DRAWN, 1961
REVISION DATES
TRACING _____ PRINT _____

SHEET NUMBER 4-E/30S